


Mt Lyell Mg. and Ry Co Ltd.
 Plan of Underground Workings
 Scale 40ft to an inch

28 Jan
 1896

218-07

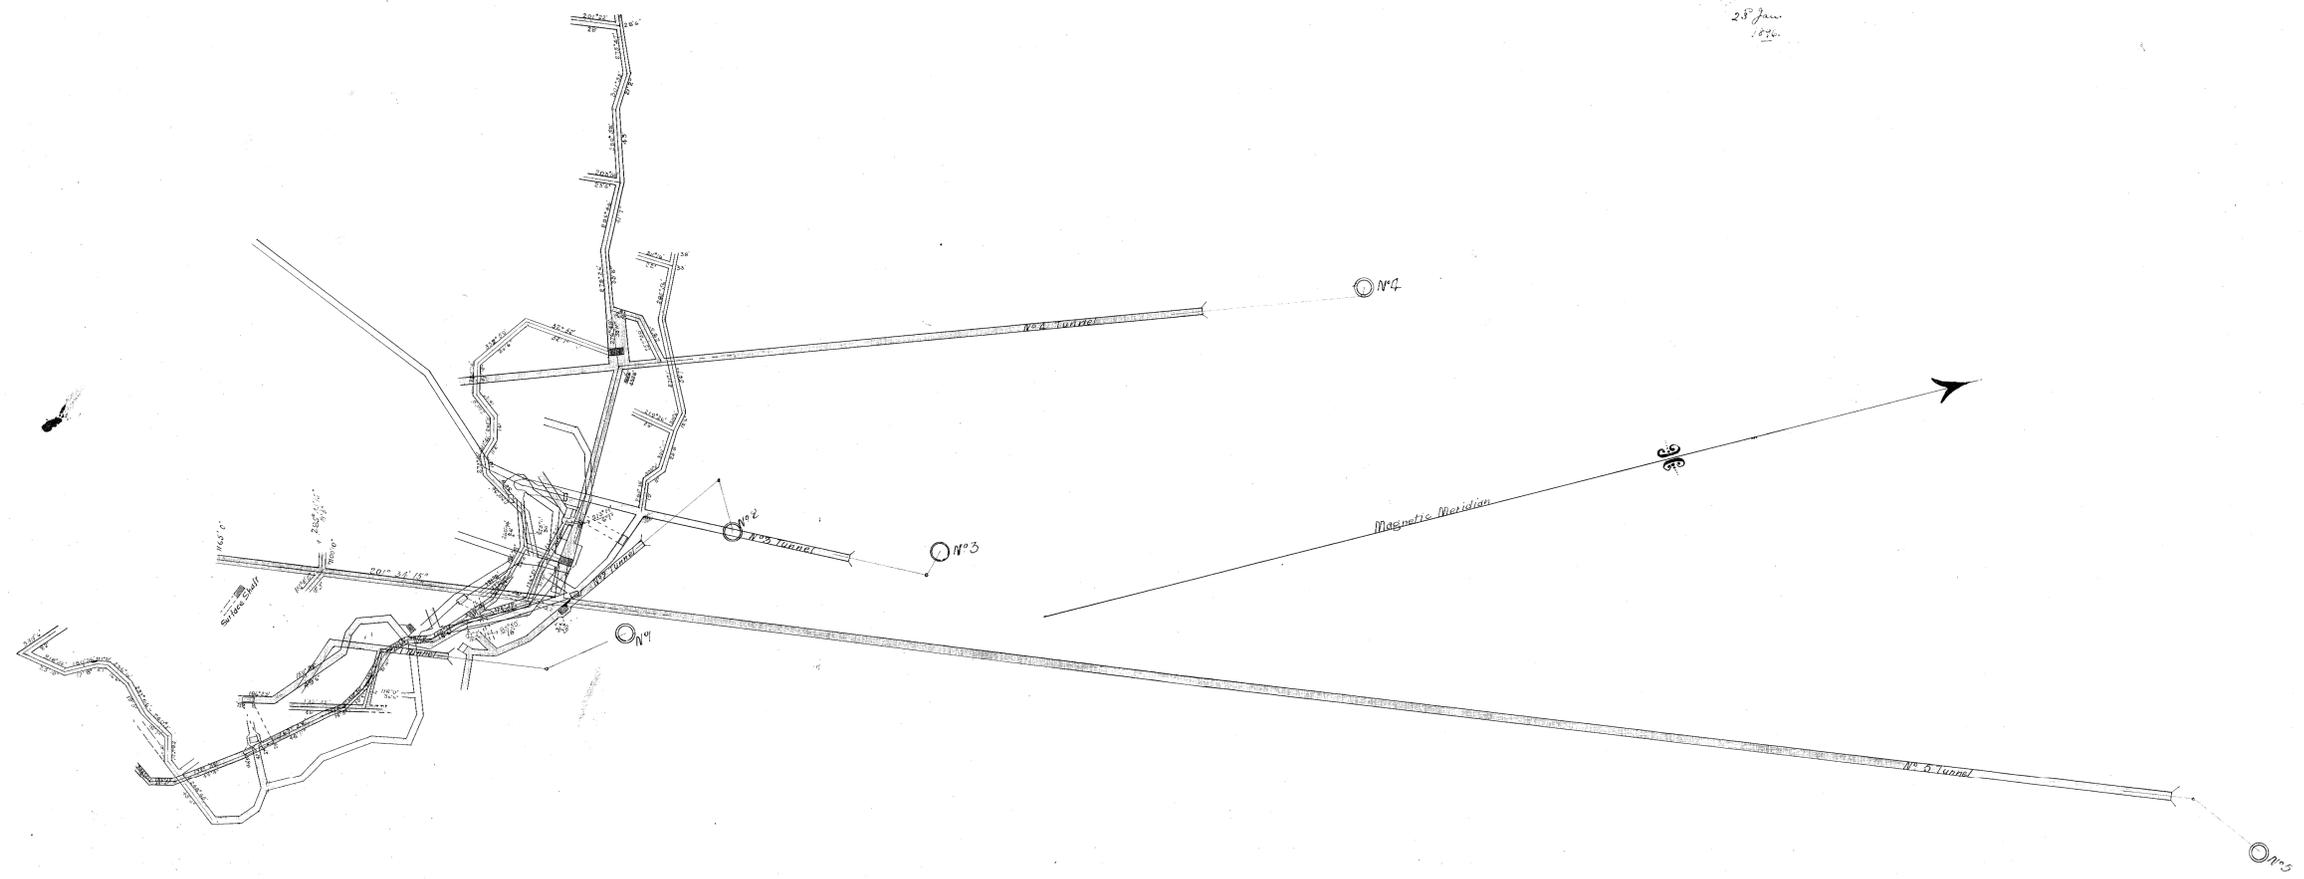

- | | | | |
|--------------|---|-----------------|---|
| No. 1 Tunnel | ▬ | No. 4 Tunnel | ▬ |
| No. 2 " | ▬ | Do. 50ft. Level | ▬ |
| No. 3 " | ▬ | " 75ft " | ▬ |
| No. 5 " | ▬ | " 100ft " | ▬ |

J. Stanley Esq. B.C.E.
 December 1895

218-07