


5 cm

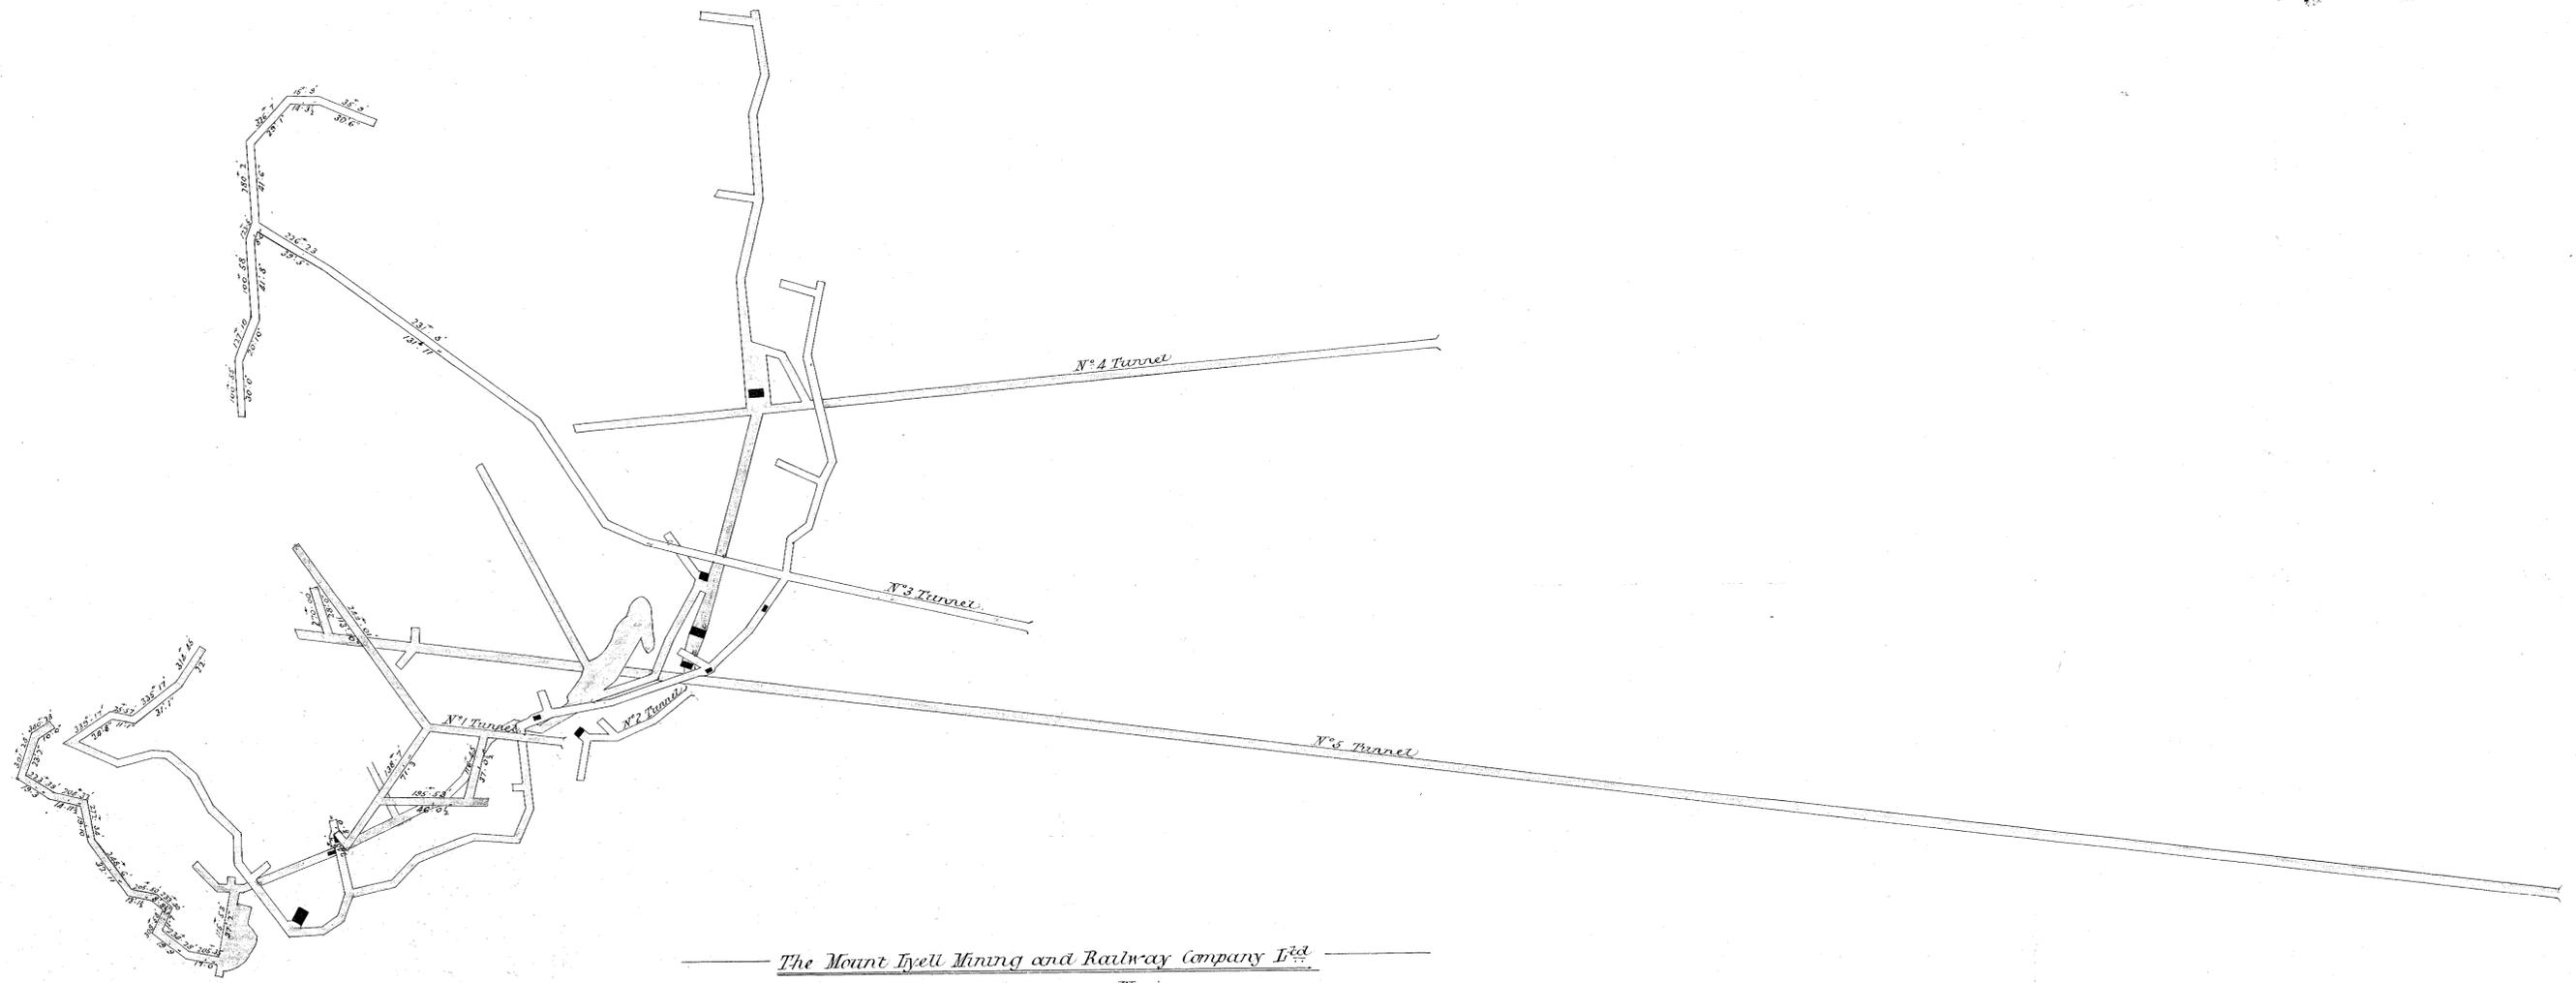

The Mount Iyell Mining and Railway Company Ltd

Plan of Underground Workings


Scale - 40 Feet to an Inch

Note - No new work has been done below the level of N°4 Tunnel, except in N°3 Tunnel N°2 X cut

Bearings shown in red figures

Distances given in blue colour in feet and inches

1897

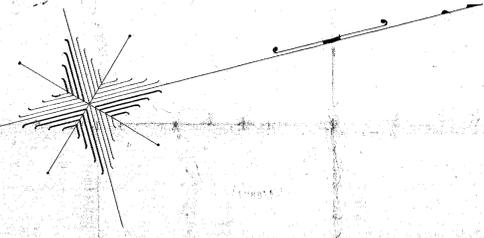

Handwritten signature or name, possibly 'Murray'.

1897
M. I. M. & R. Co.