

5 cm

218-10

MOUNT LYELL MINING & RAILWAY CO.


LIMITED

N^o 3 TUNNEL WORKINGS



DETAIL PLAN OF N^{os} 1, 2 & 3 TUNNELS

Scale 40 feet to 1 inch

N^o 1 TUNNEL WORKINGS

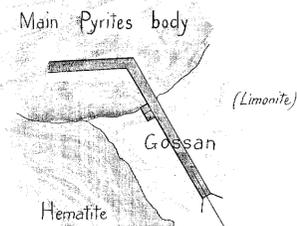

N^o 2 TUNNEL WORKINGS

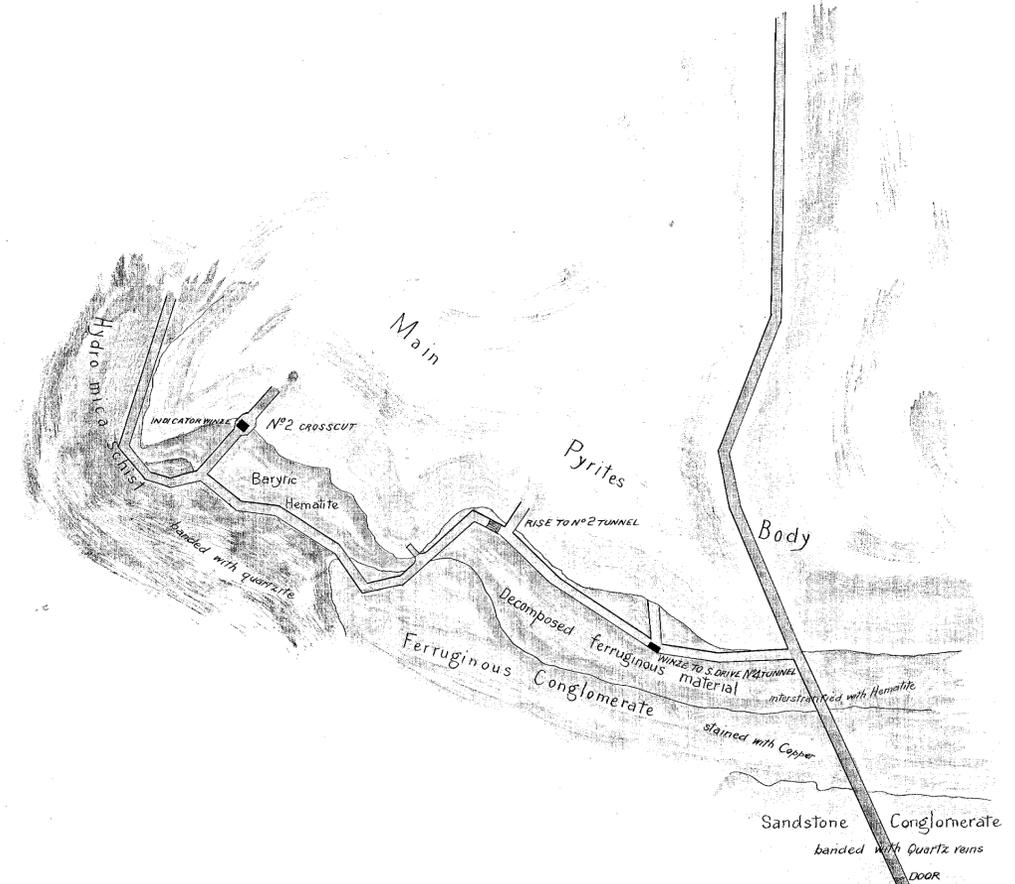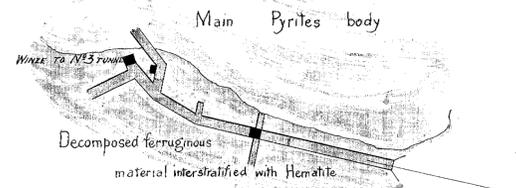

PLAN VIEWS

110 9 9 9 9