

5 cm

218-11

M^T LYELL MINING AND RAILWAY COMPANY L^{TD}

DETAIL PLAN OF WORKINGS N^o 4 TUNNEL

Scale 25 ft. to an inch

PLAN

VIEWS








SOUTH DRIVE N^o 4 TUNNEL

50 FT LEVEL

100 FT LEVEL

75 FT LEVEL

TRANSVERSE SECTIONS

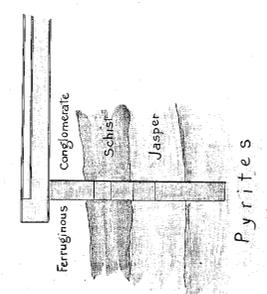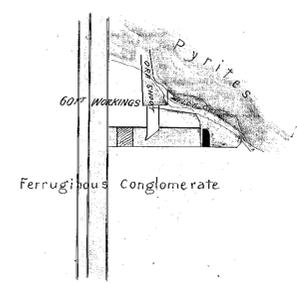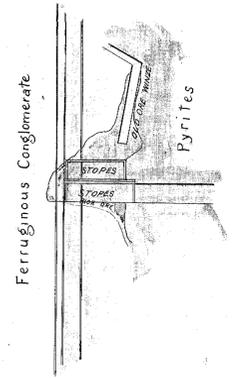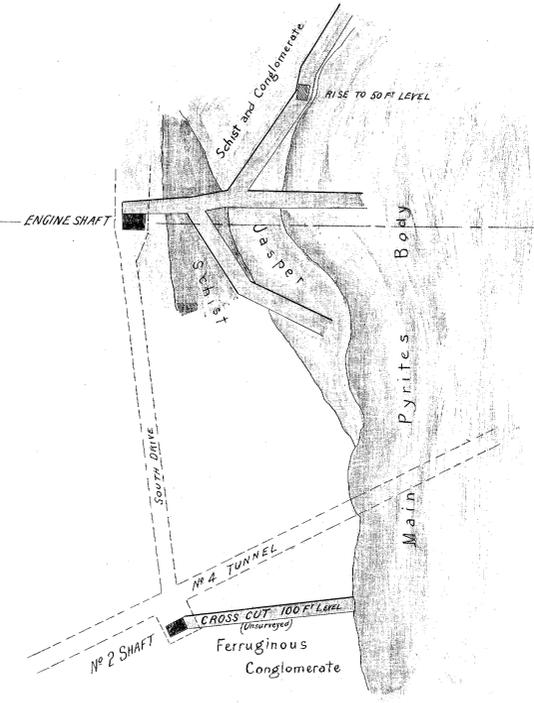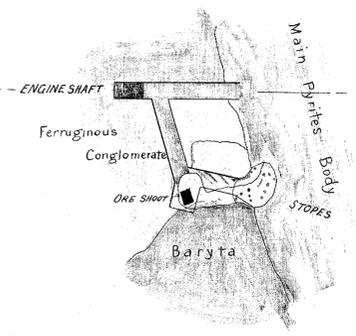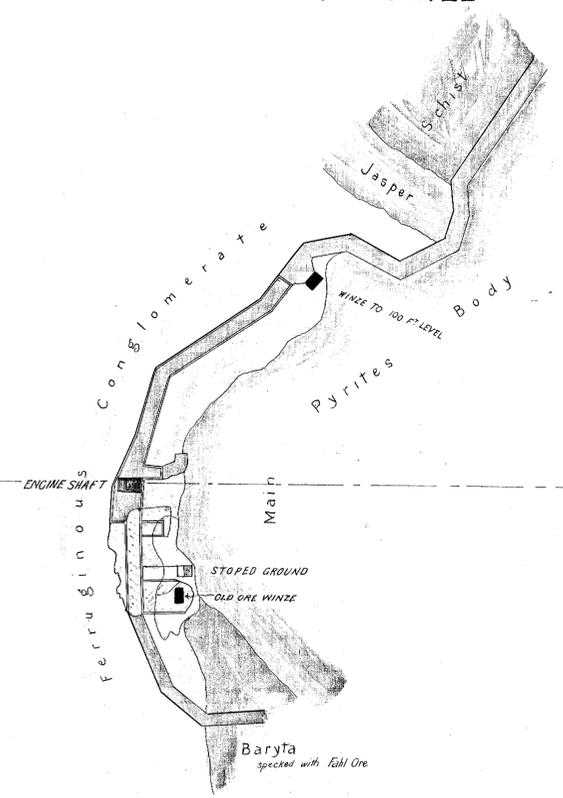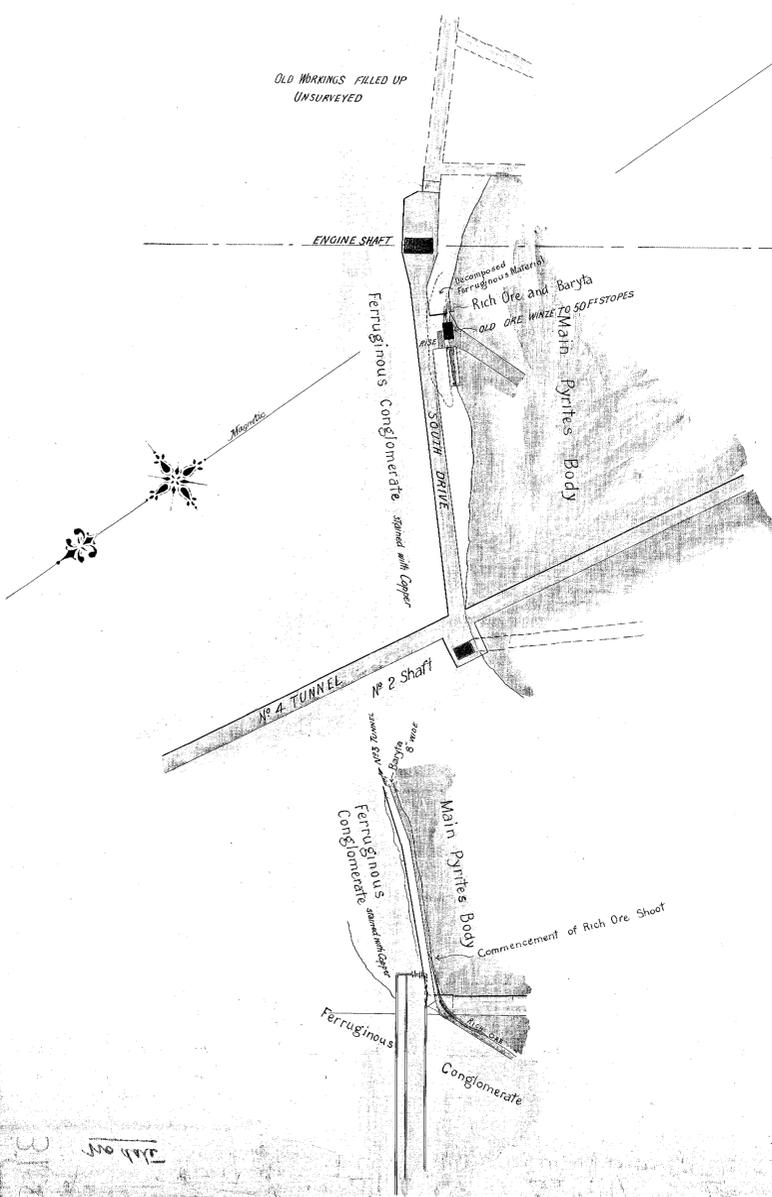

318