



218-12

5 cm

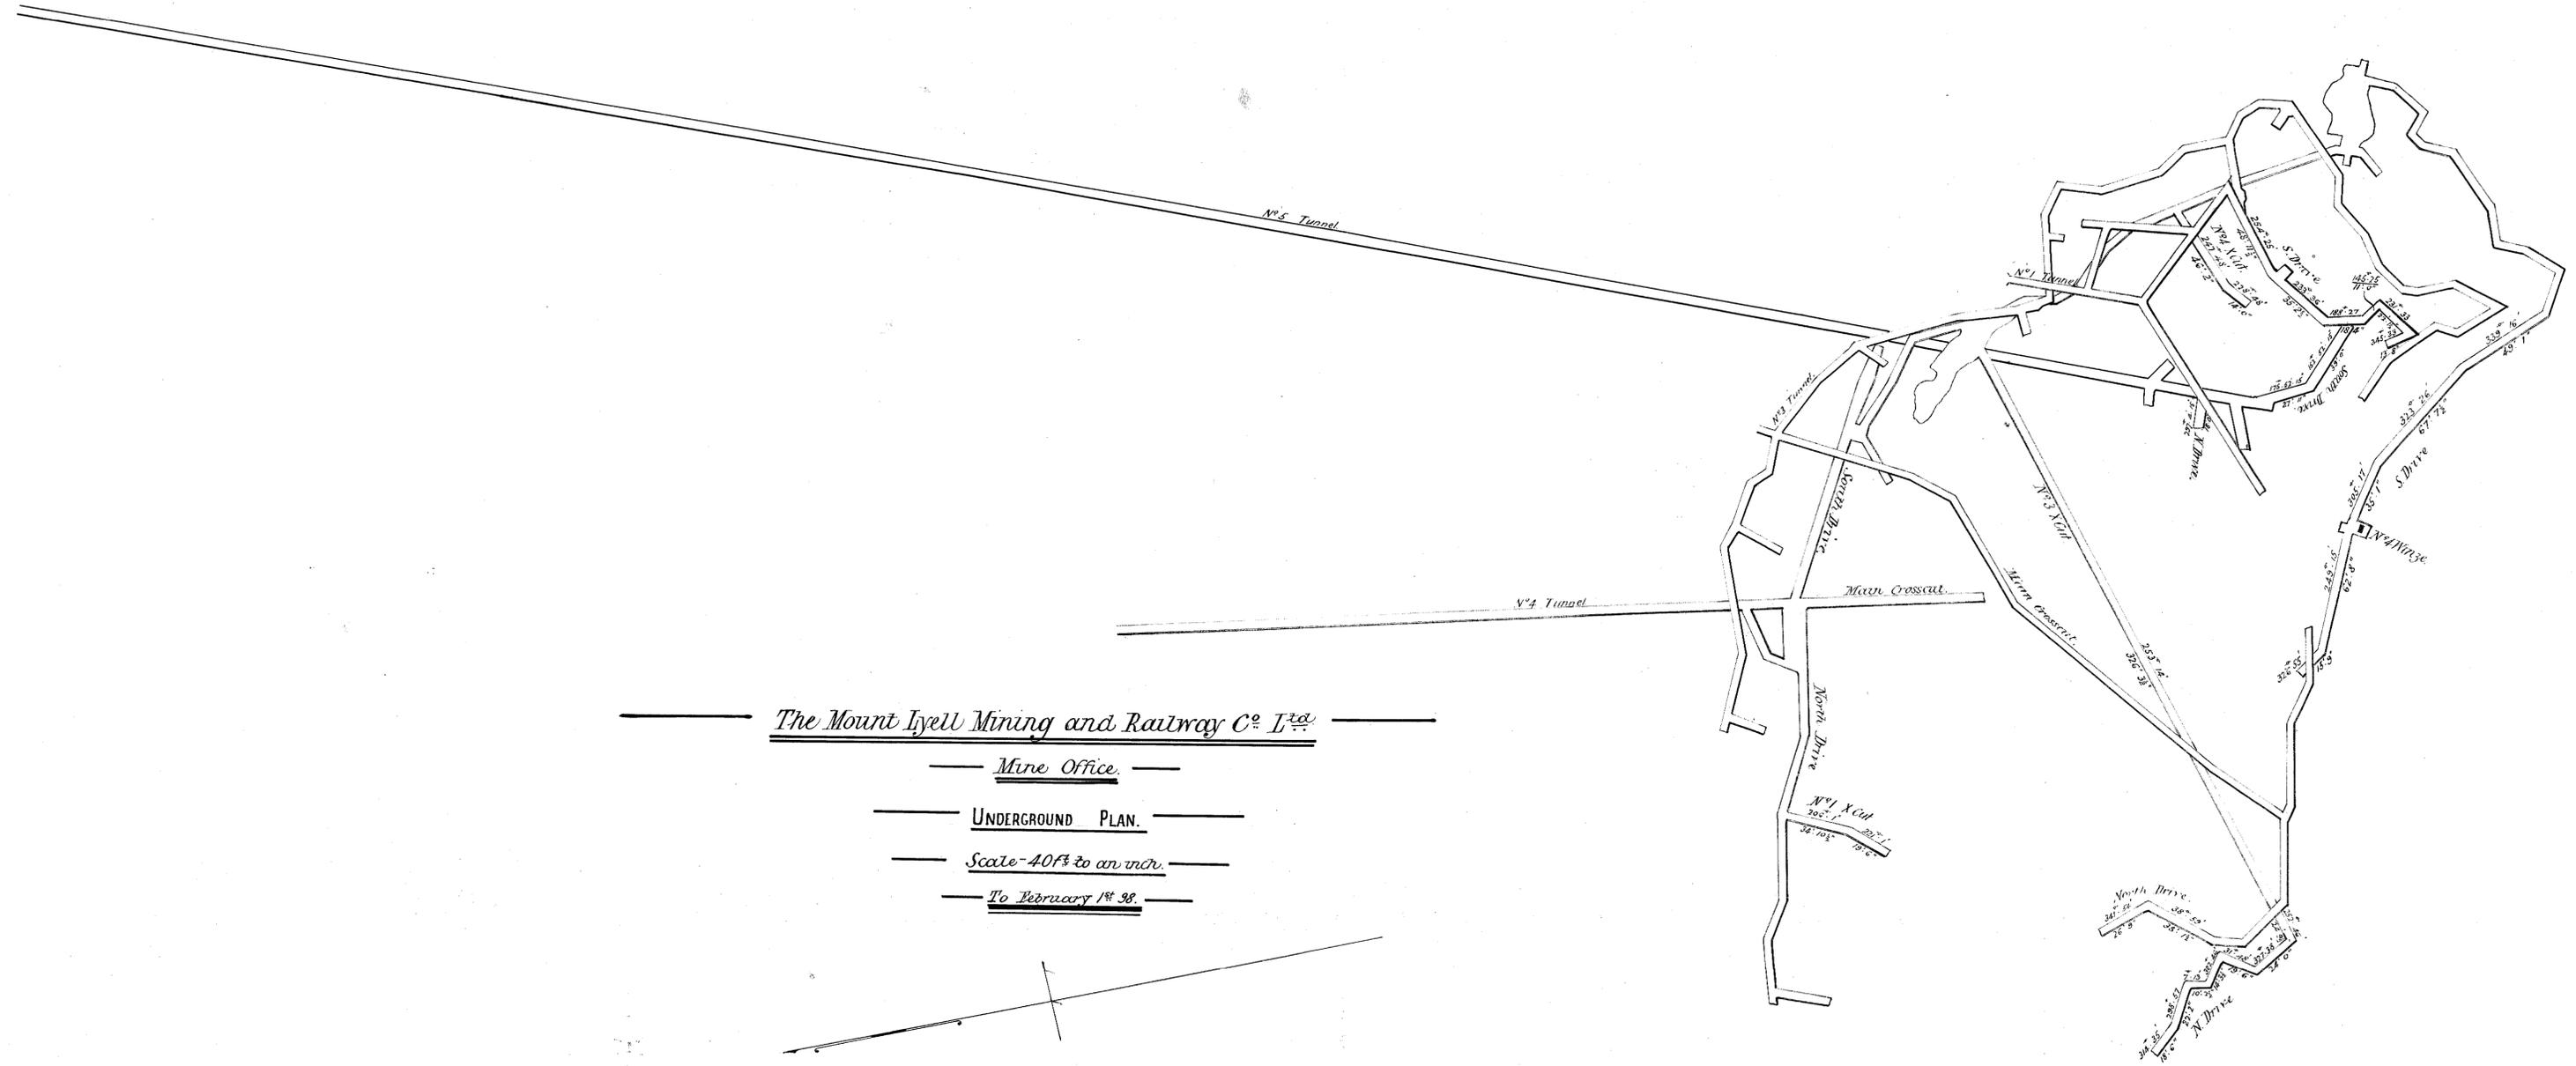

————— The Mount Iyell Mining and Railway Co. Ltd. —————  
 ————— Mine Office. —————  
 ————— UNDERGROUND PLAN. —————  
 ————— Scale - 40ft to an inch. —————  
 ————— To February 1st 98. —————

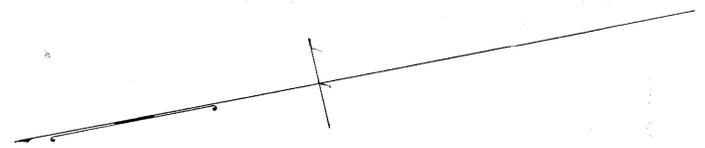

116-117