


THE MOUNT LYELL M. & R. CO. LTD

SURFACE WORKINGS.

Scale - 40 feet to an Inch.

Plan showing relative positions of faces.

December 31st 98

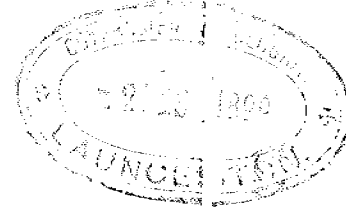


50m

218-13

218-13

31

partial revision 11/13/98

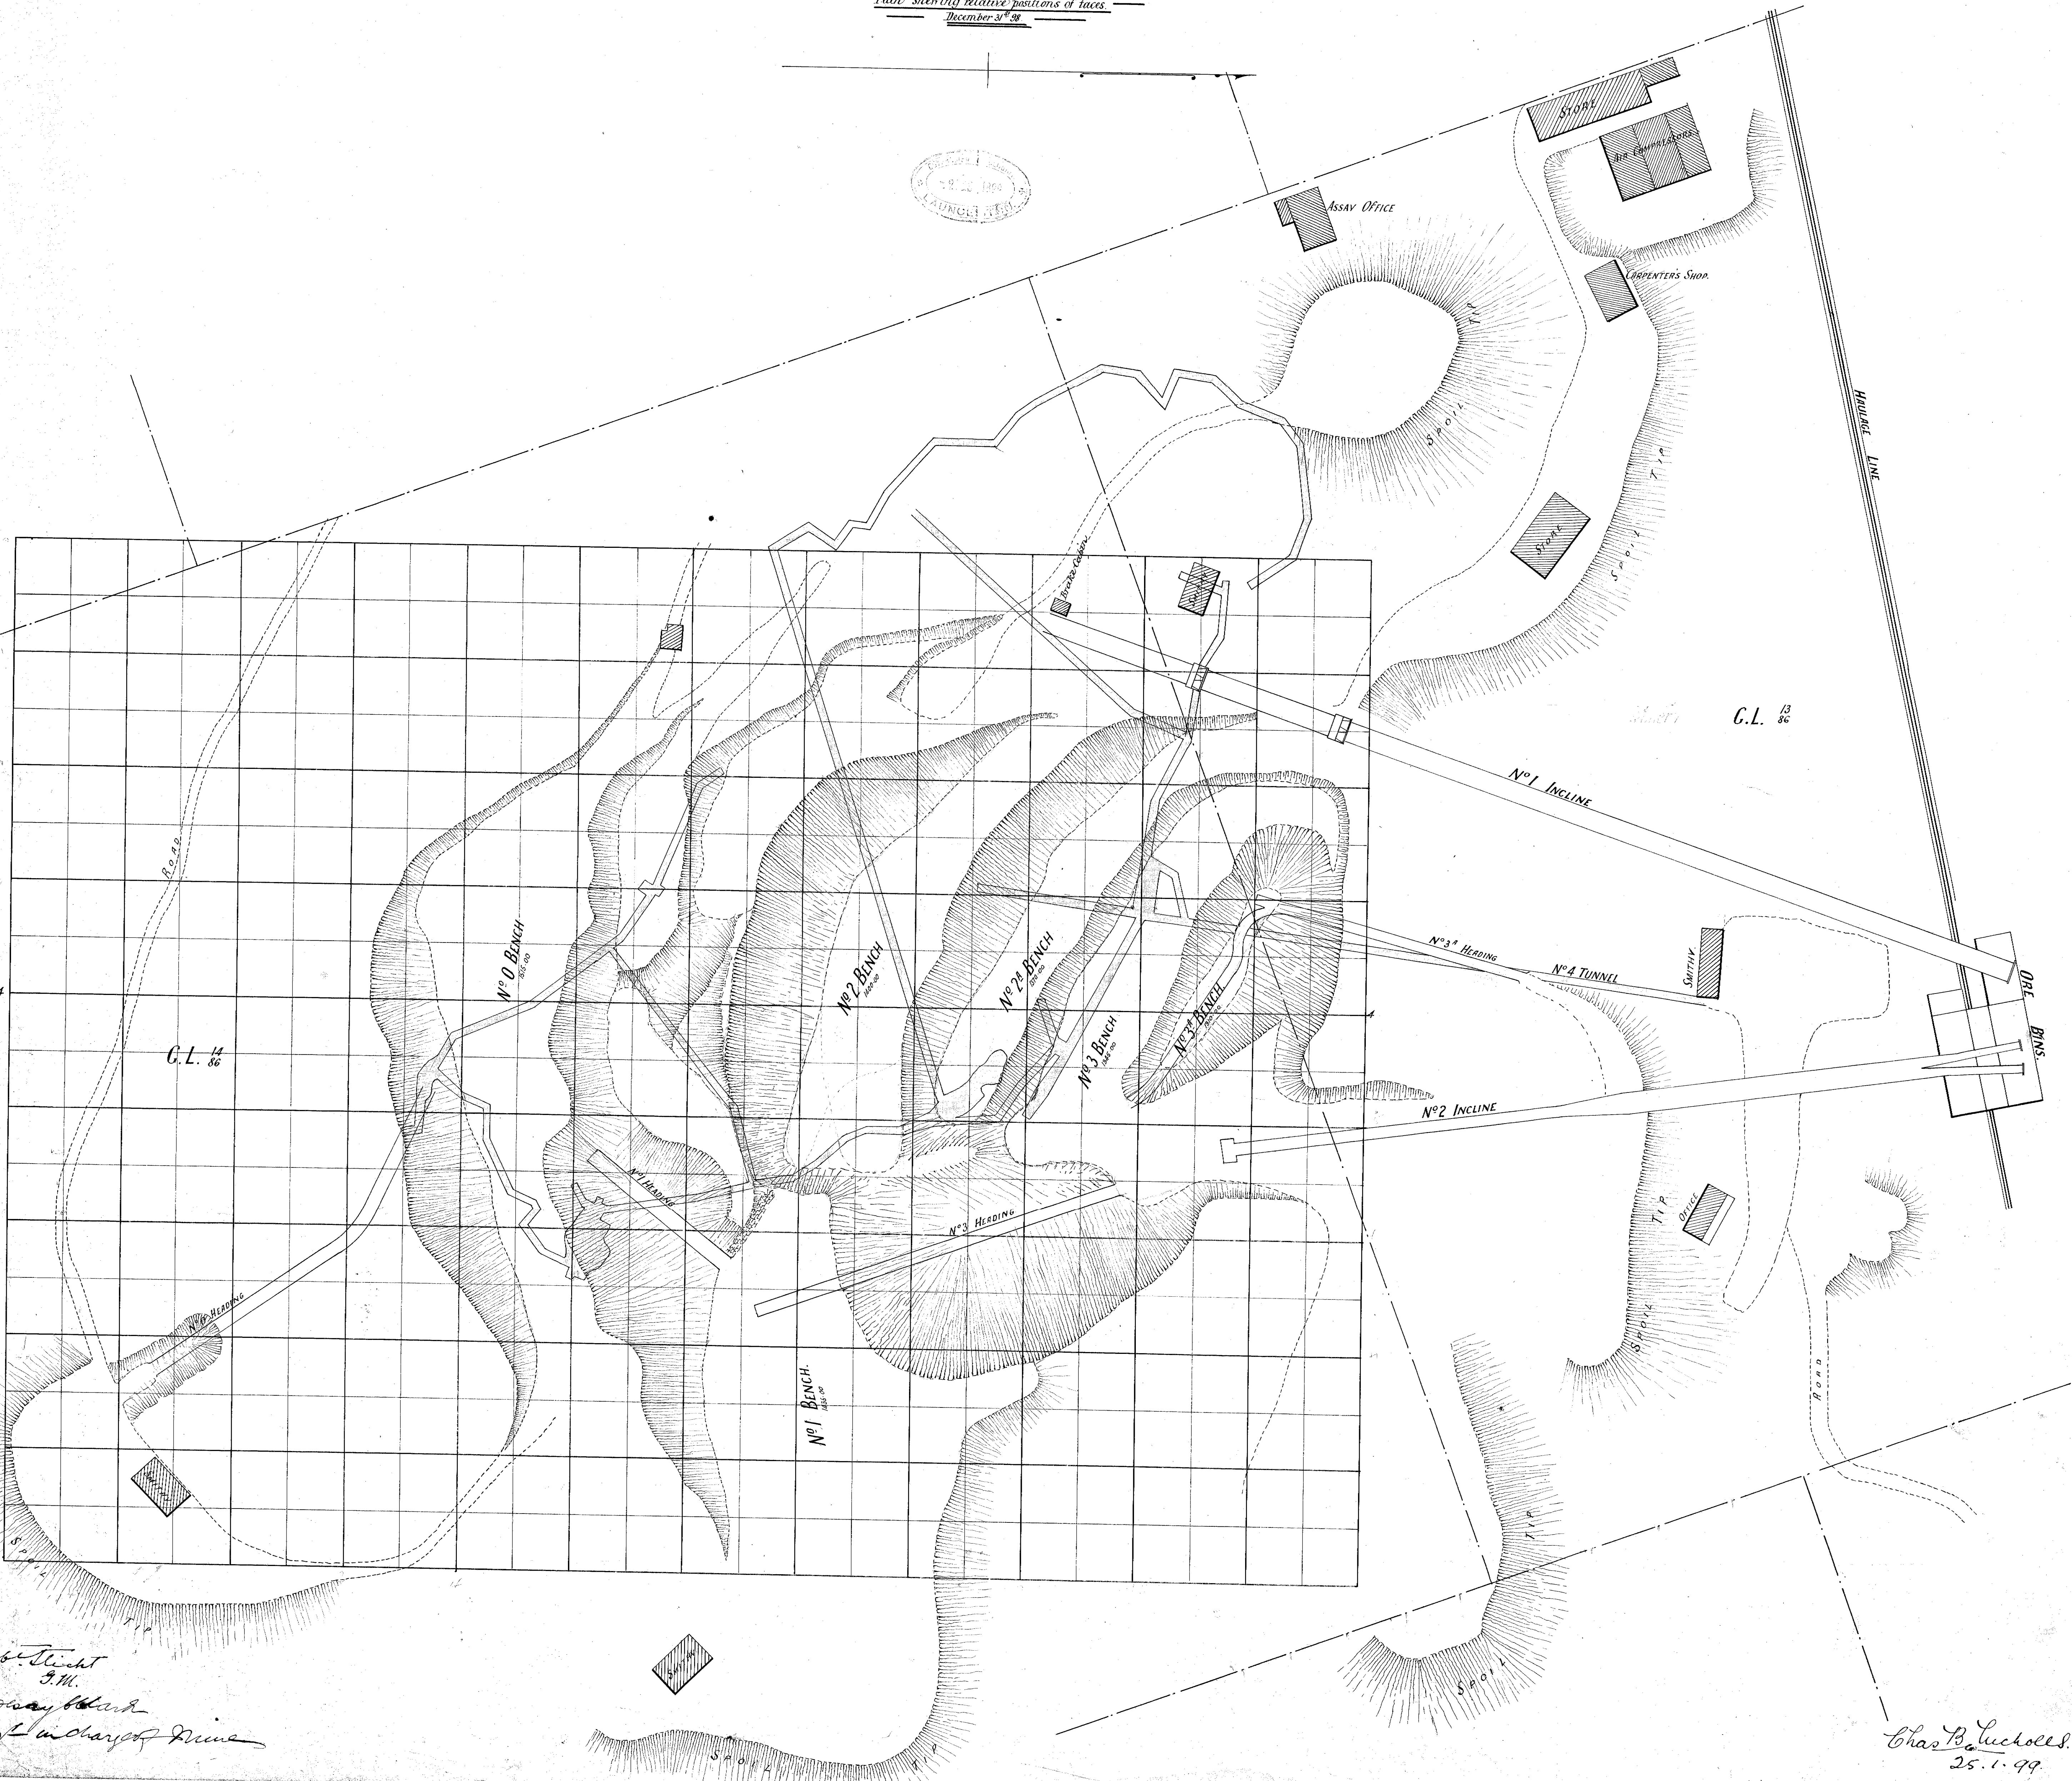

Robert Smith
S.M.
Assistant Manager
In charge of mine

Chas. B. Luckwell
25.1.99