

5 cm

218-14




THE MOUNT LYELL M. & R. CO. LTD

UNDERGROUND WORKINGS.

Scale 40 Feet to an Inch

Plan showing work done during 1898

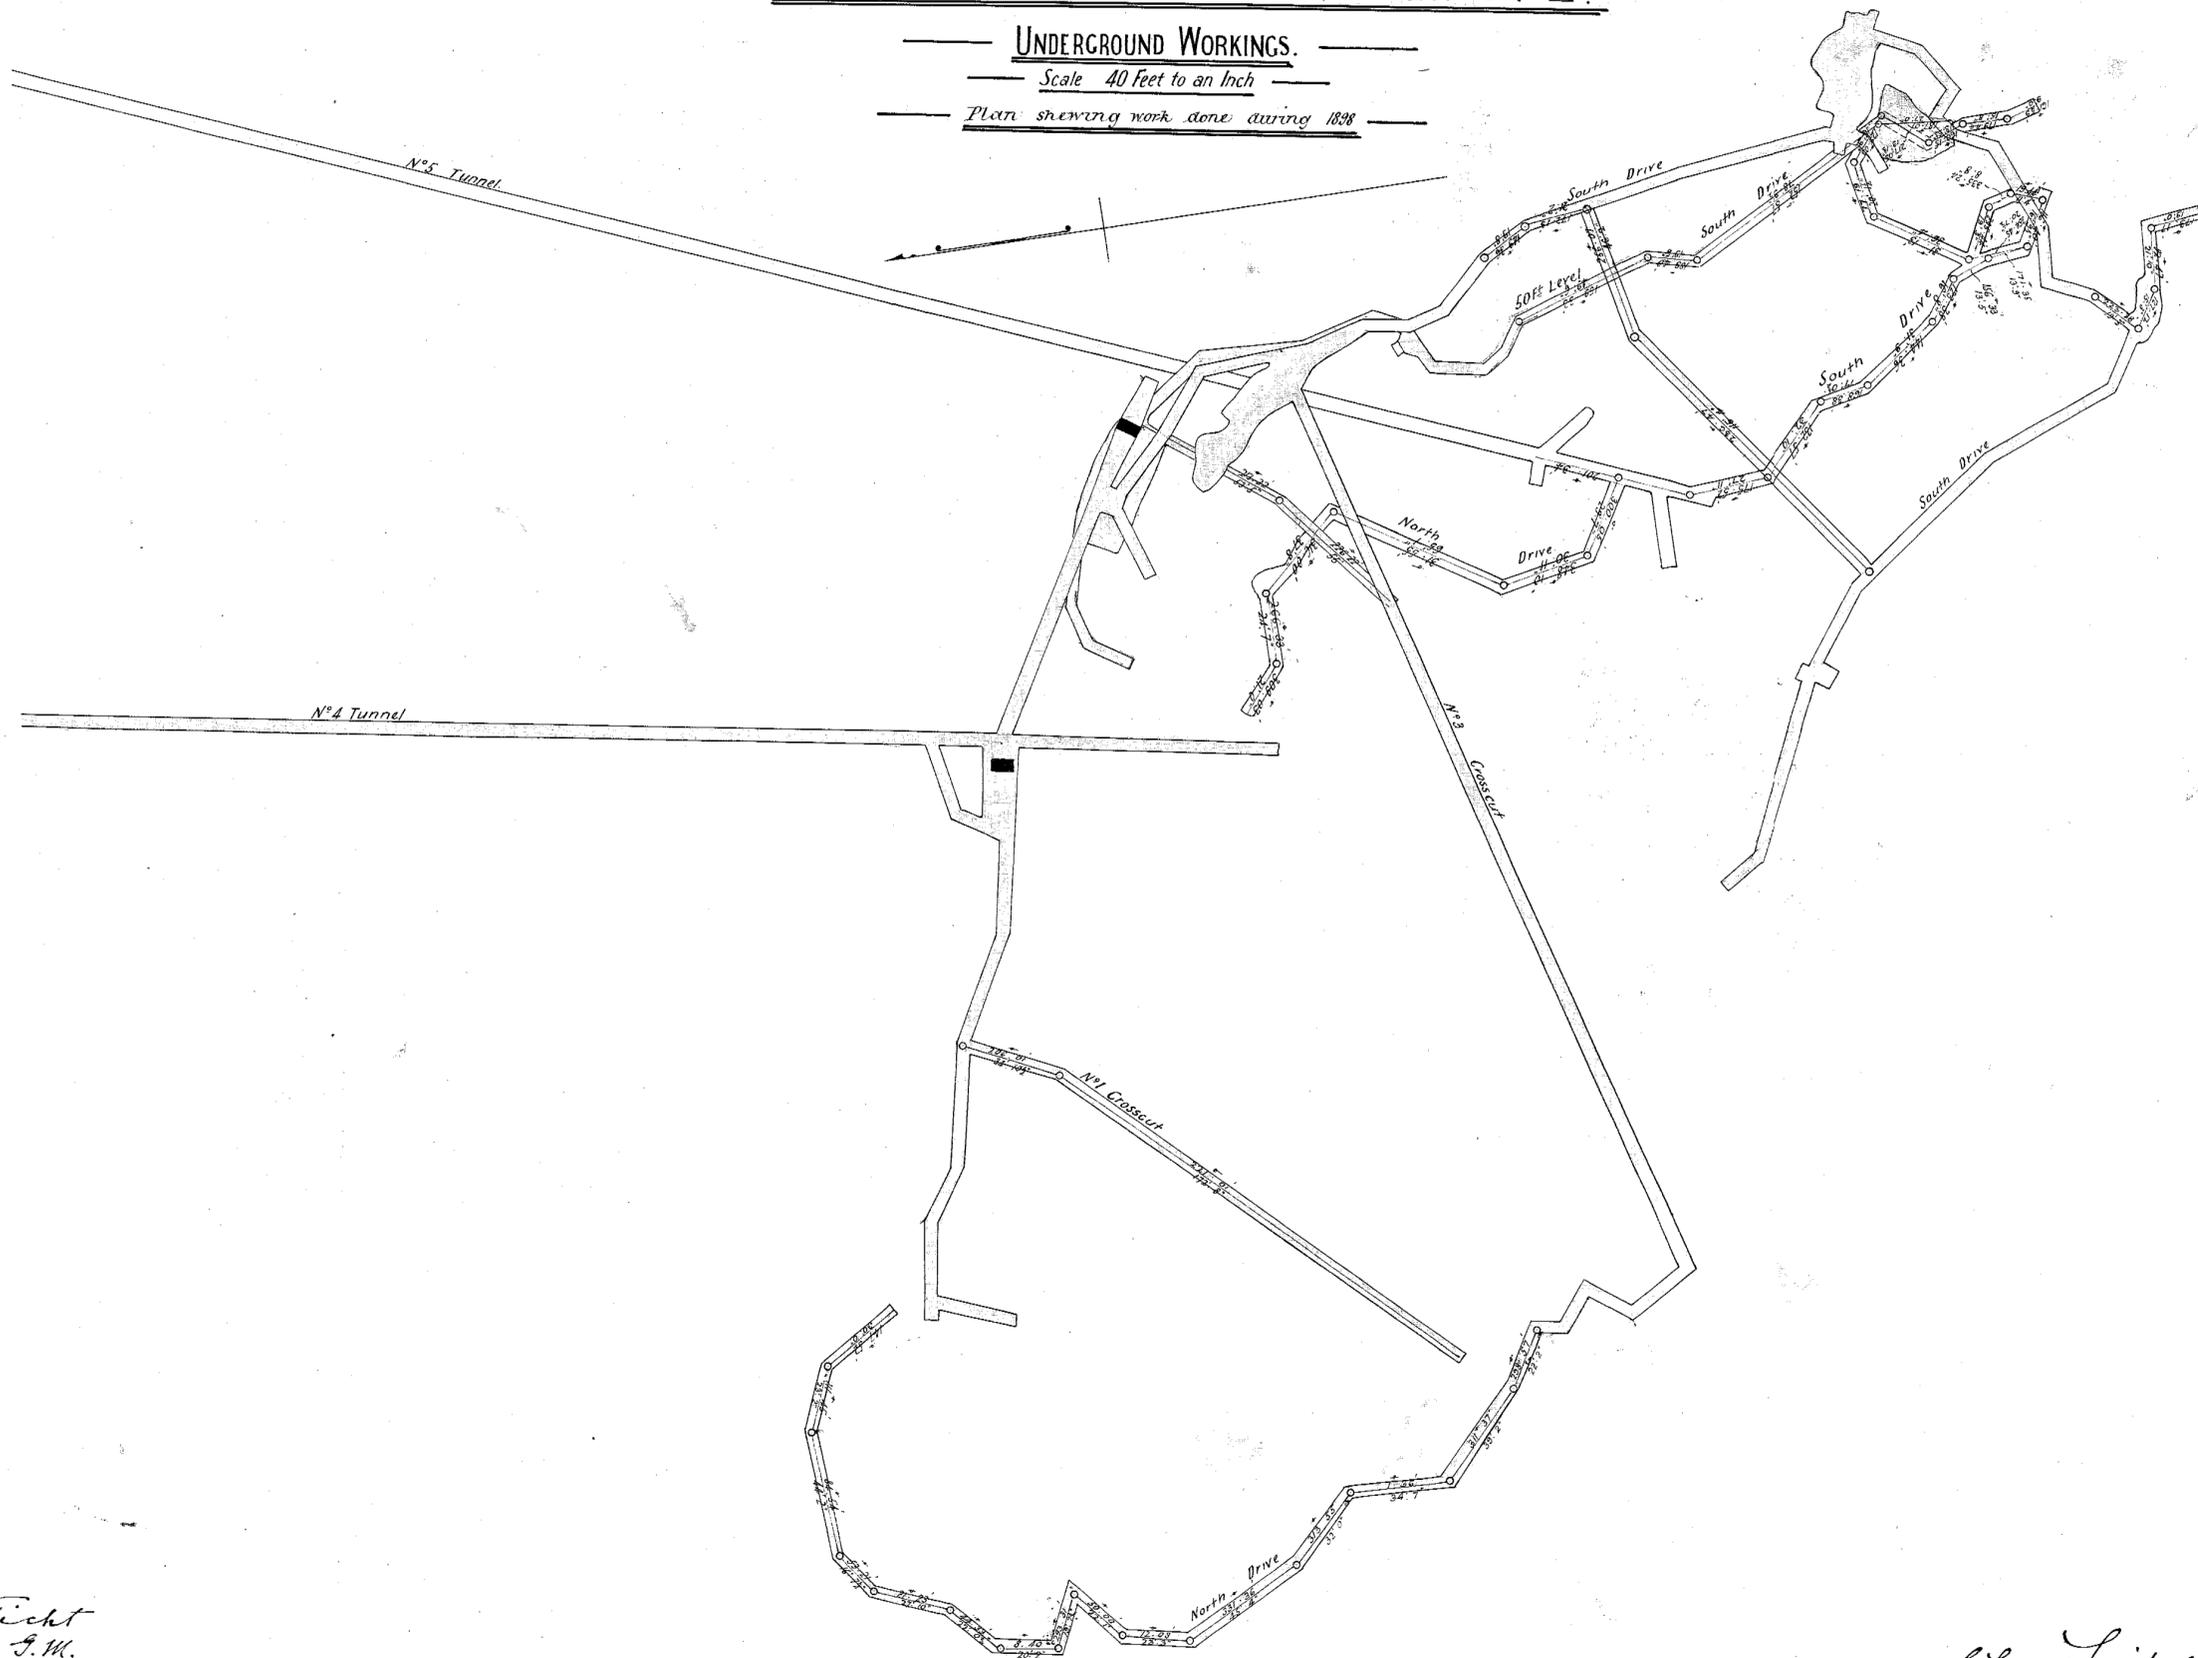

Robt Licht
S.M.
Ruudway & Clark
Eng in charge of Mine

Chas Bicknell
25.1.99.