

43

31

5 cm


218-15

The Mount Lyell Mining and Railway Company Ltd.

Mine Office

Section Line 44 showing relative positions of Open Cut and Underground Workings

Scale - 20 feet to 1 inch

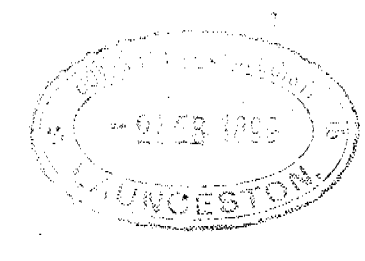

Robt. T. J. ...
S. M.
Rudway & Co.
In charge of mine

Datum Line 1100.00 Datum taken 100ft below HWMOST at Pine Cove.

218-15
25.1.99
Chas. B. L. ...