

3
1881
Mount Lyell
Prospecting

#13
1881


500

28-17

THE MOUNT LYELL M. AND R. CO. LTD

PROSPECTING TUNNEL $\frac{13}{86}$

SCALE 1" = 40'

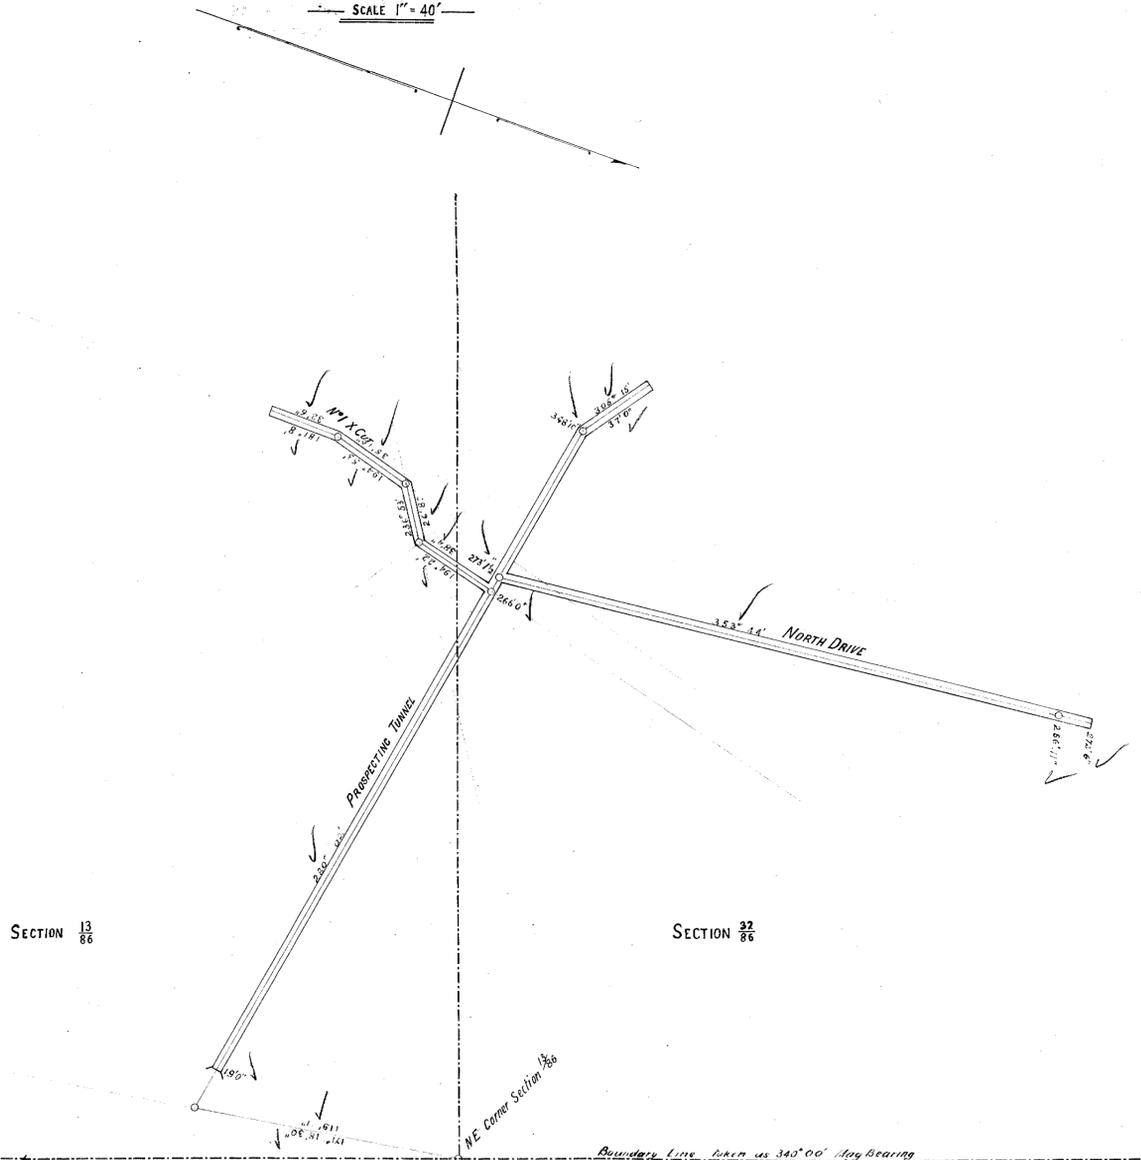

Robt. Licht
S. M.

Huntley Blake
Custodian Surveyor

28-17

31

31