

5 cm


218-19

THE MOUNT LYELL M. & R. C. ° L^{TD}

PROSPECTING TUNNEL SECTION 13-86

For the year ending Dec 31st 1900

Scale 1" = 40'

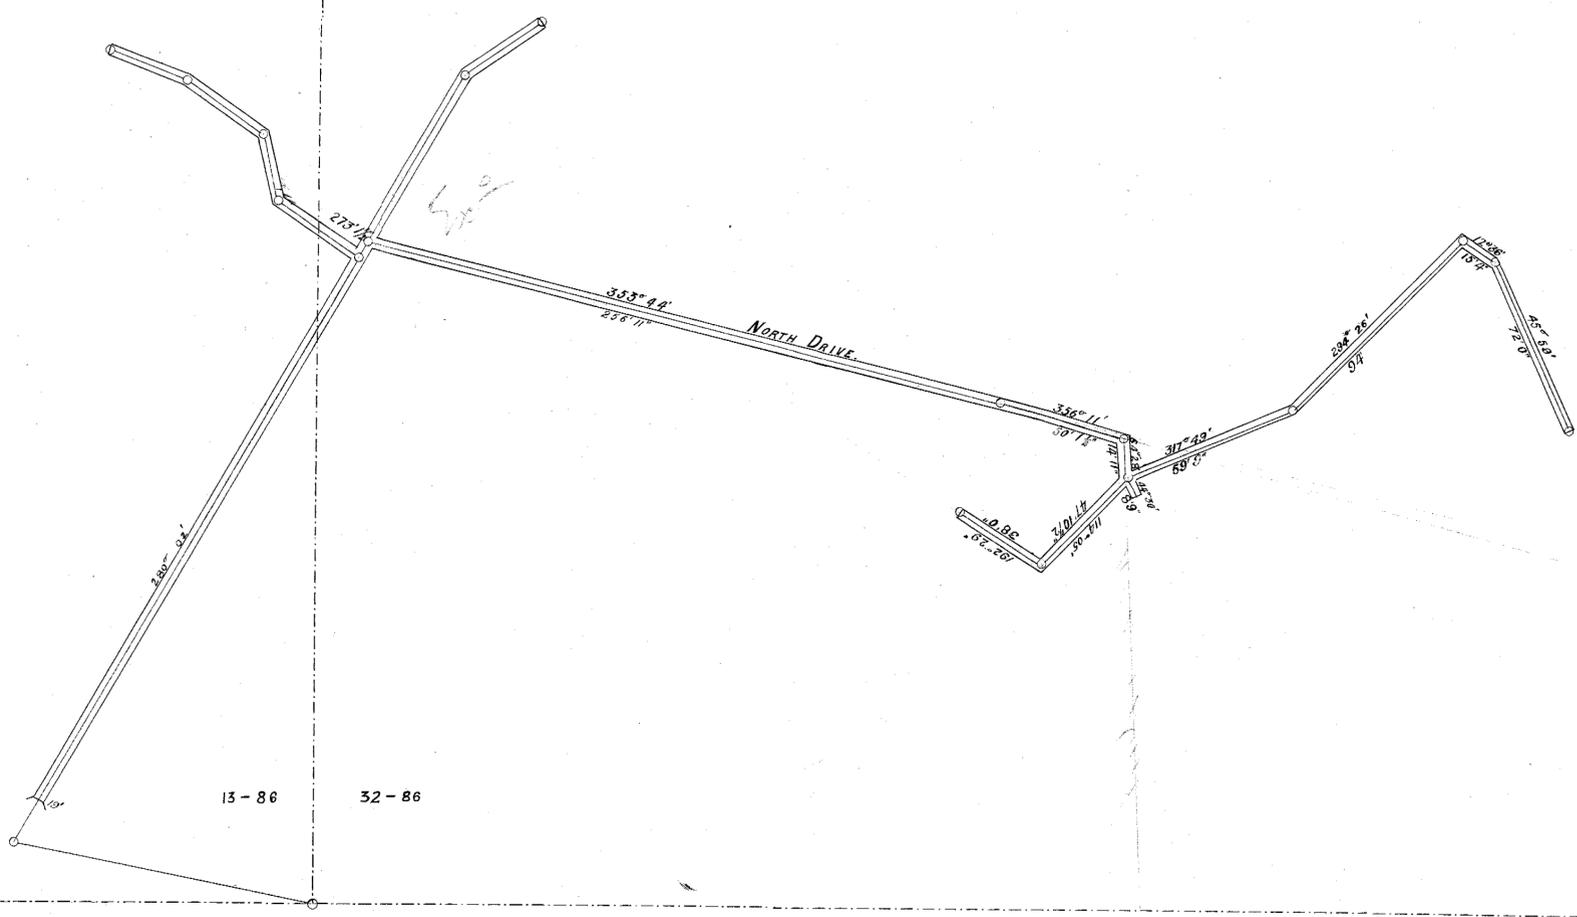

W. J. Batehela
 Eng - in - Charge