

Adm Dept
OP1

ROYAL THARSIS

LYELL THARSIS



955
93M

2105
91M

THE MOUNT LYELL M. & R. CO. LTD

SOUTH THARSIS FLUX QUARRY

UNDERGROUND WORKINGS
SCALE 1" = 40'

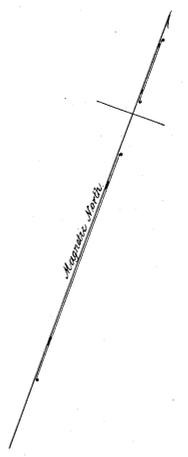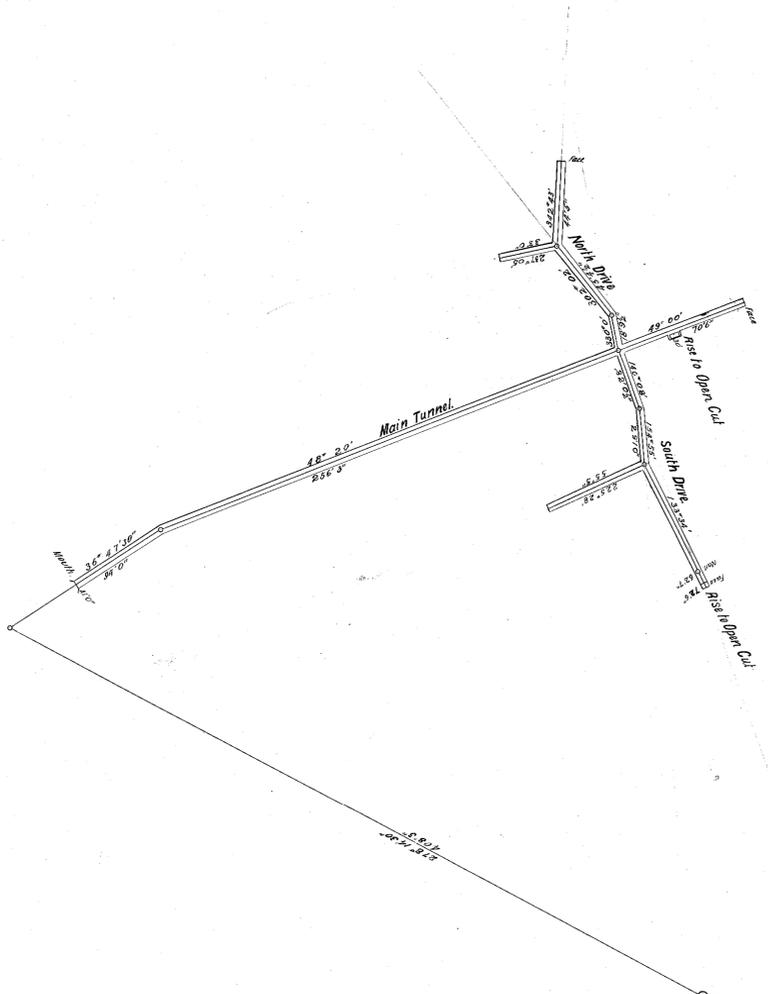

1845
91M

WEST LYELL EXTENDED

218-21

1805
91M

170
91

THE COPPER MINES OF MT LYELL WEST LTD

165
91



W. J. Batehlo
Eng. in Charge

218-21

