


5 cm

218-22

THE MOUNT LYELL M. & R. C^o L^{TD}
UNDERGROUND WORKINGS
 For the Year ending December 31st 1900
 Scale 1 Inch = 40 Feet

14
86

15
86

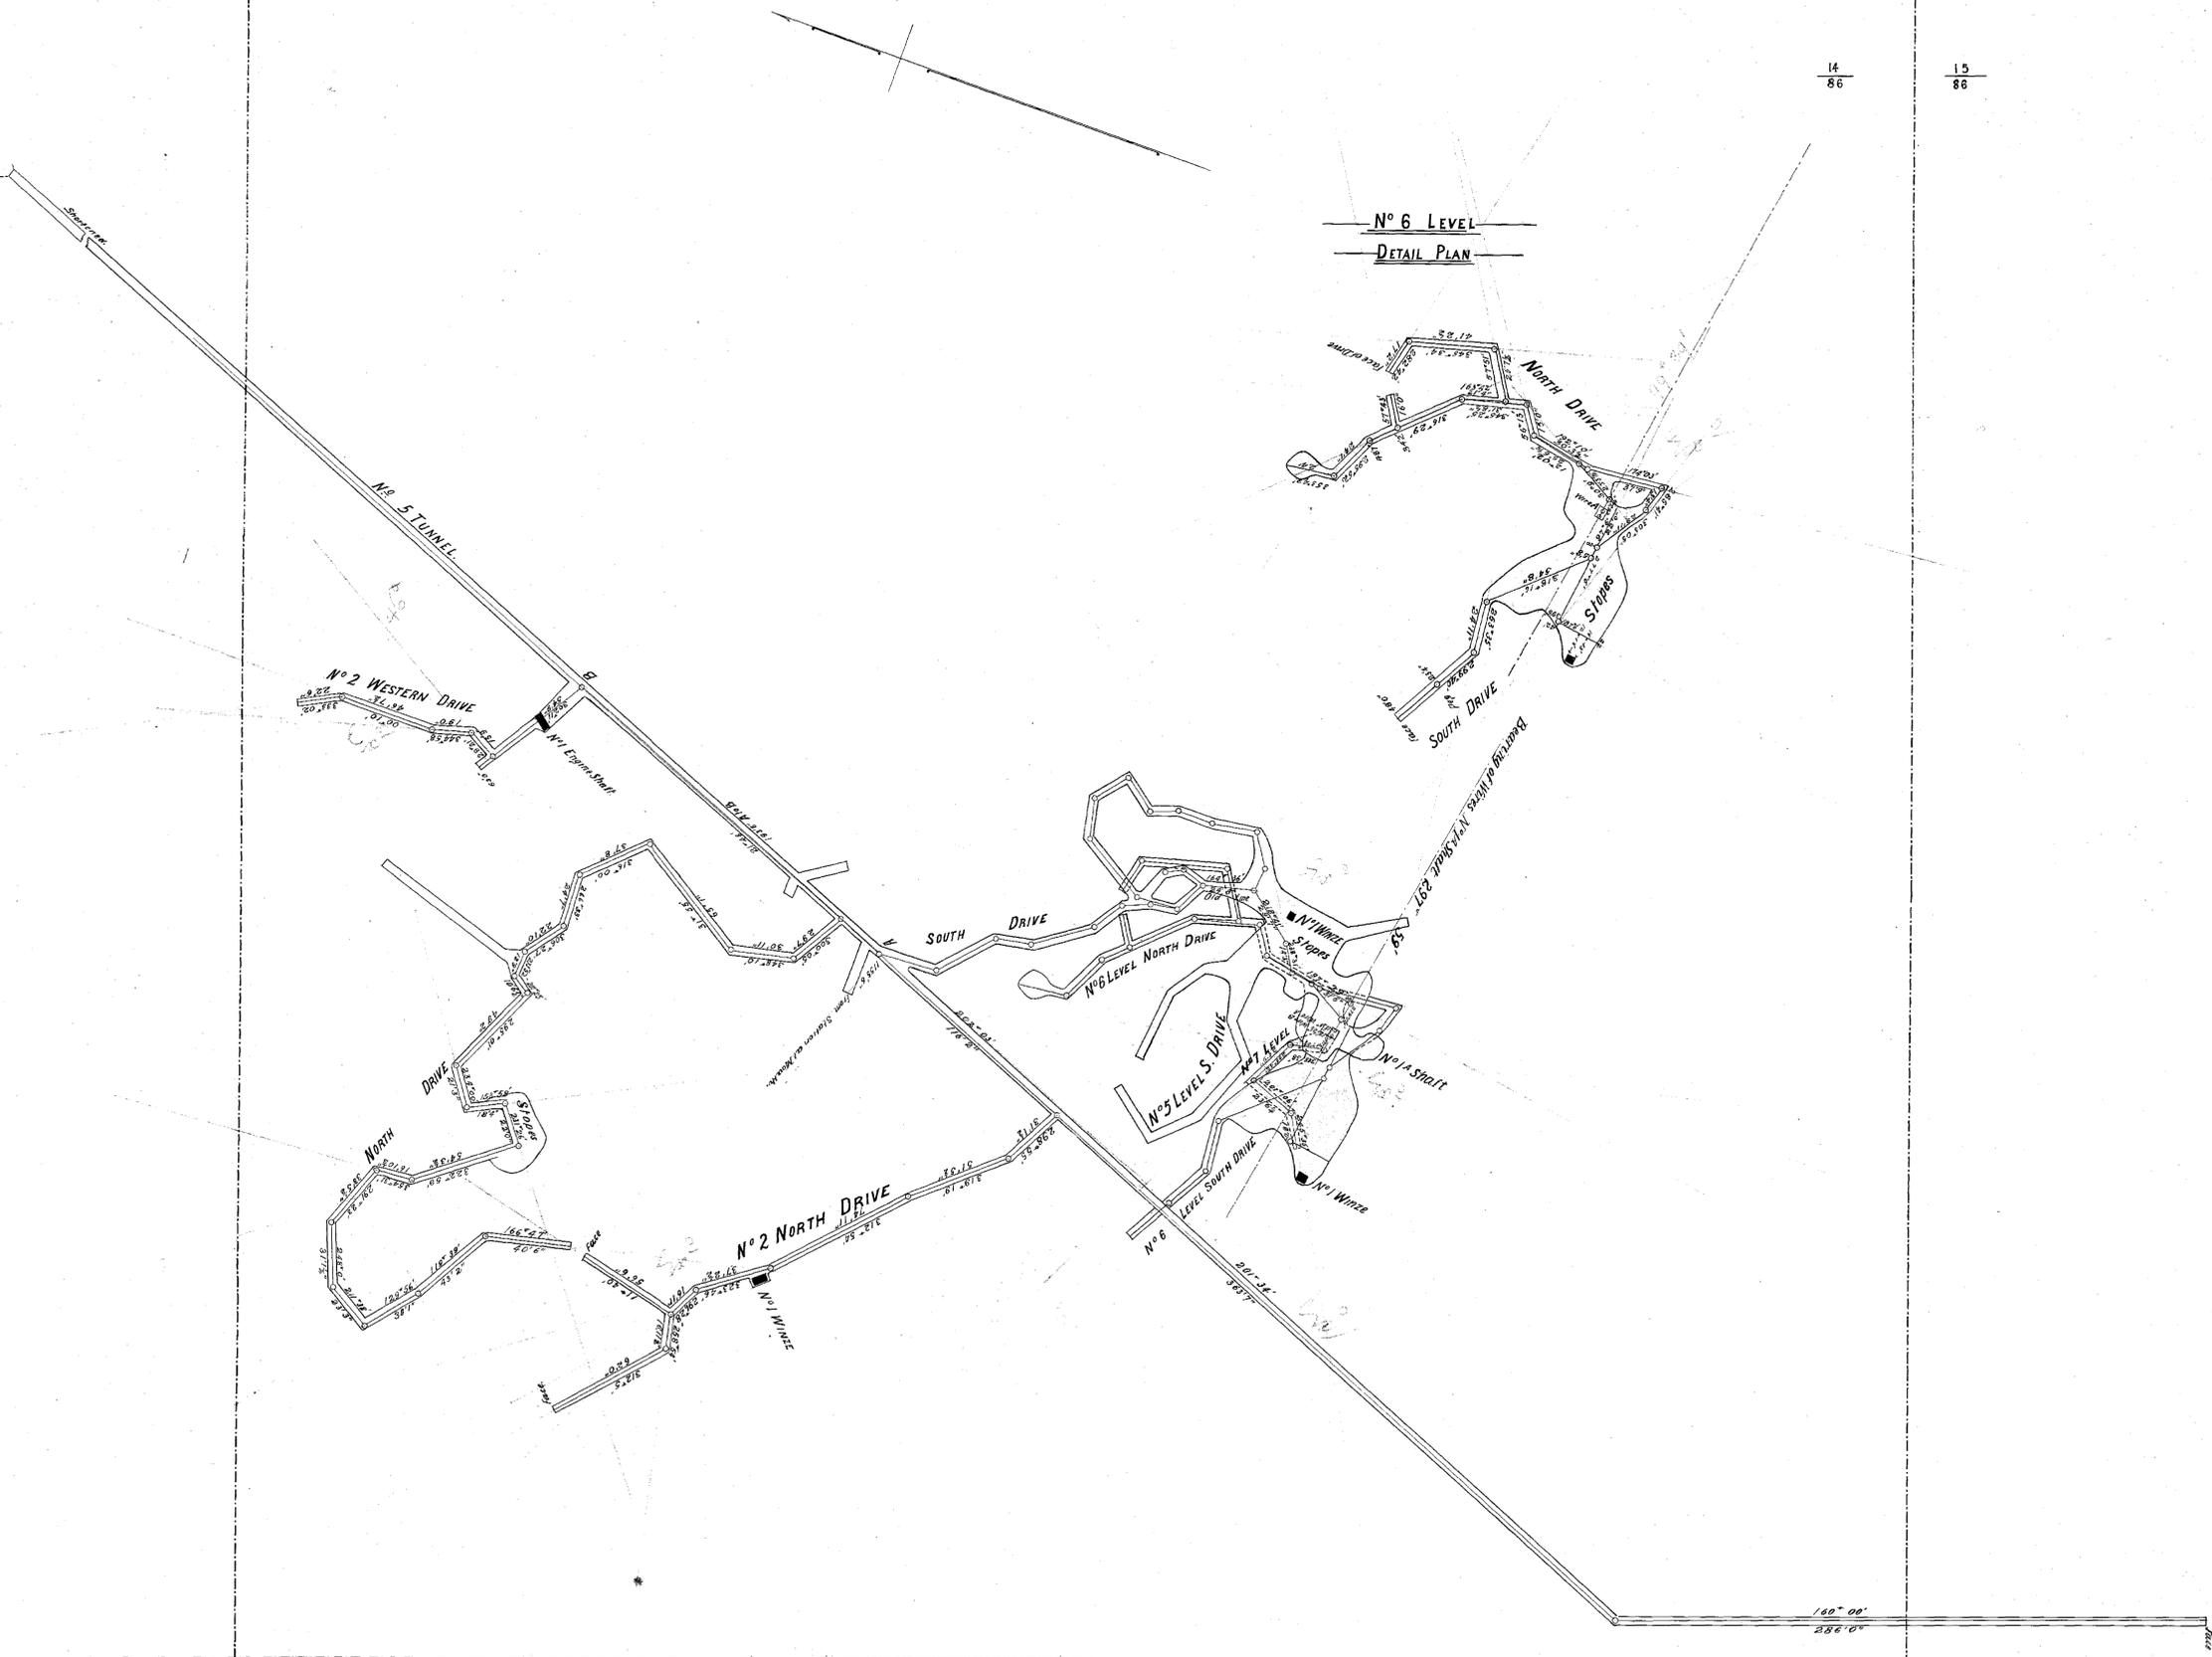

N^o 6 LEVEL
DETAIL PLAN

THE CENTRAL LYELL MINING C^o

SOUTH LYELL C^o



W. J. Betts
 Eng. in Charge

W