


218-23


5 cm

218-23


**N<sup>o</sup> 6 LEVEL**  
DETAIL PLAN

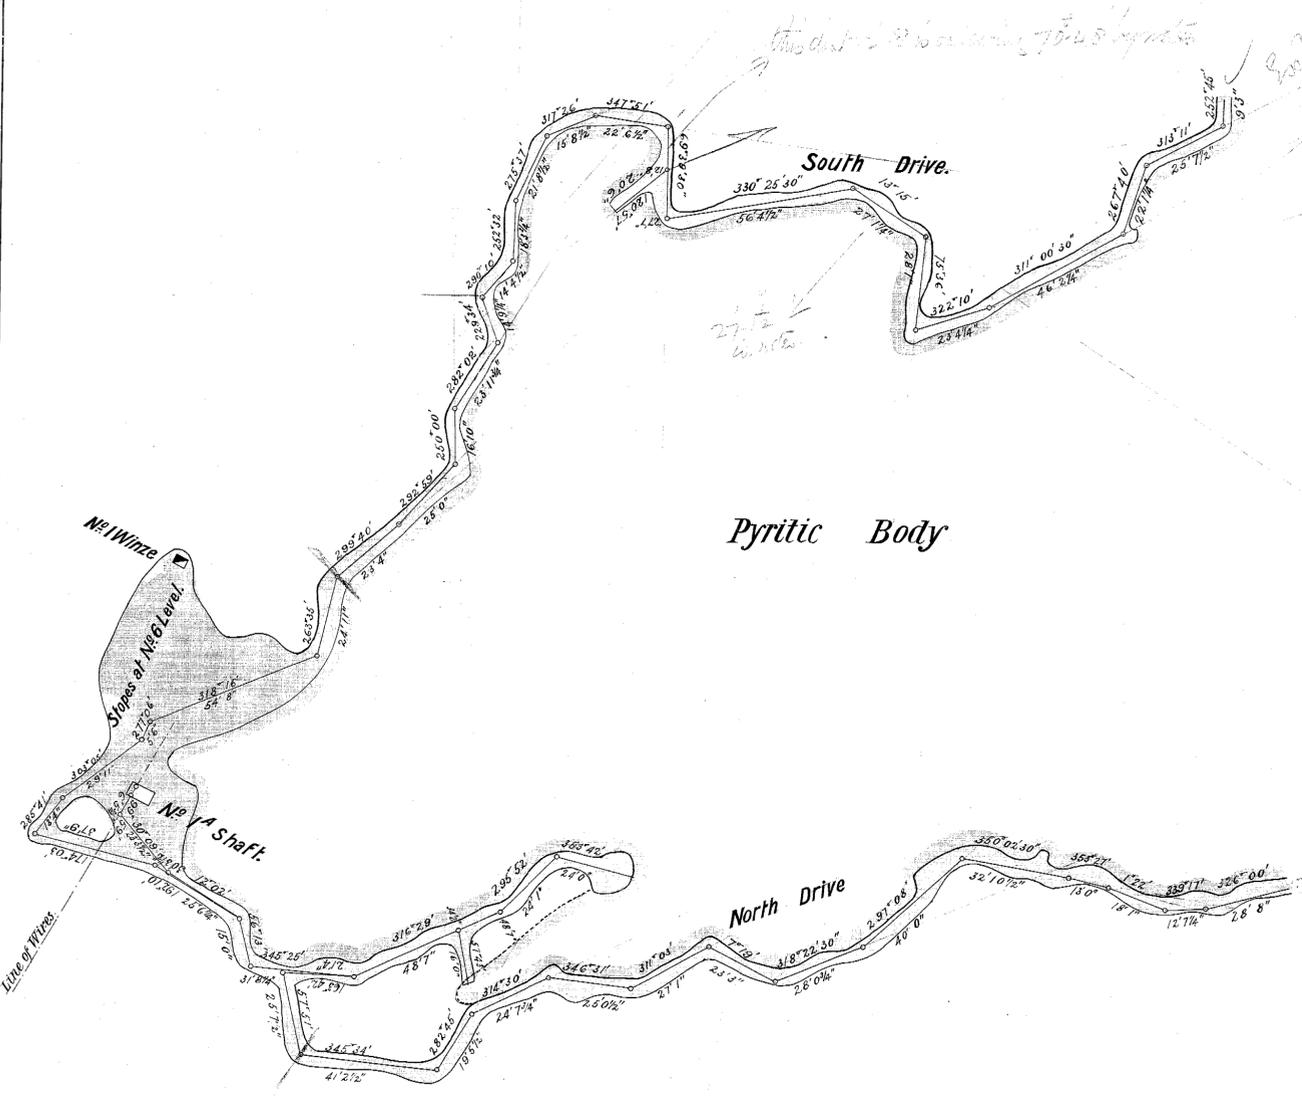



**N<sup>o</sup> 7 LEVEL**  
DETAIL PLAN

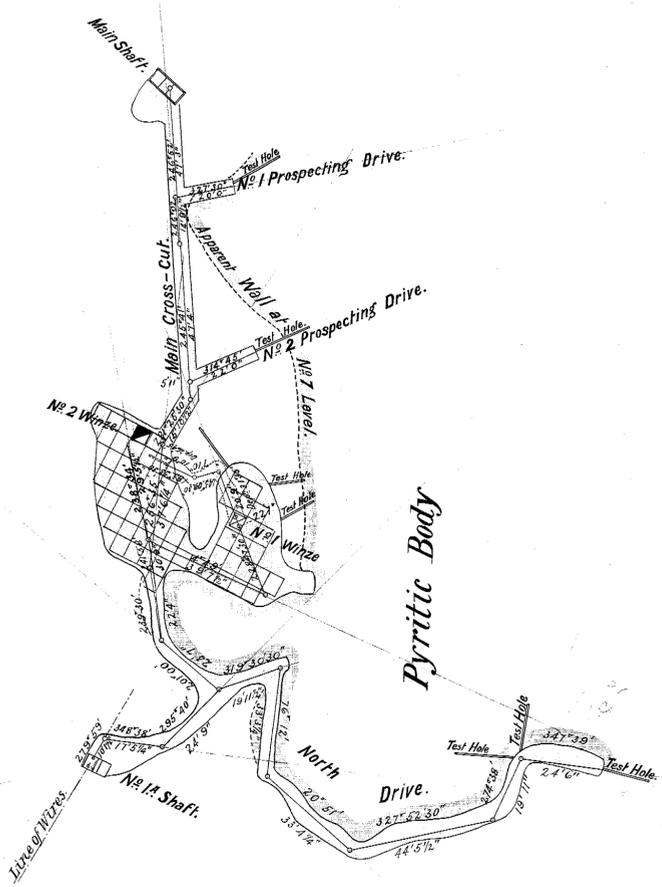

**N<sup>o</sup> 8 LEVEL**  
DETAIL PLAN

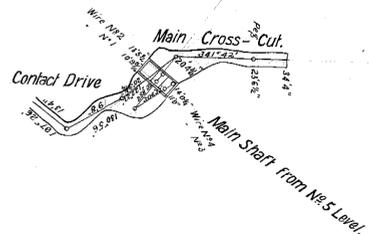

**100 F<sup>t</sup> LEVEL**  
DETAIL PLAN

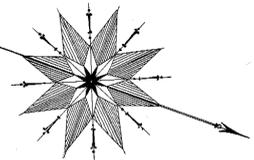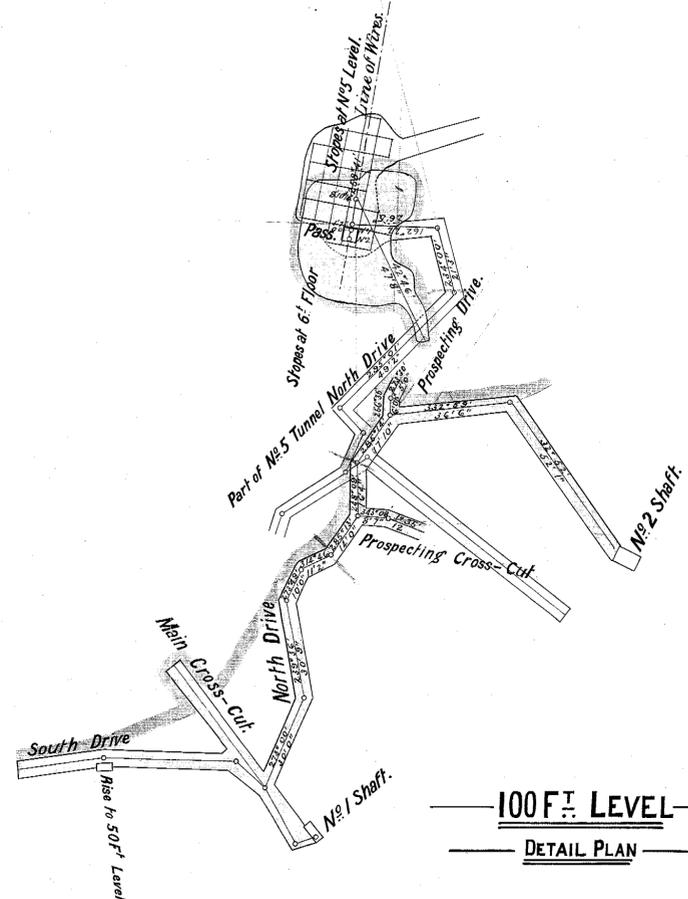

**The Mount Lyell Mining & Railway Co., Ltd.**

Mine Department.

DETAILS OF UNDERGROUND WORKINGS.

SCALE. 1 INCH = 30 FEET.

Genl. Manager. *Robt. Ditch*  
Engineer-in-Charge. *W. J. Batchelor*

