

SOUTH LYELL MINING CO.

CENTRAL LYELL MINING CO.


172
91

27
90

Main Tunnel.

15
86

14
86

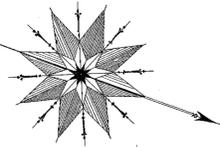


The Mount Lyell Mining & Railway Co., Ltd.

Mine Department.

DETAIL PLAN OF NO 5 LEVEL

Scale = 1 Inch = 30 Feet.

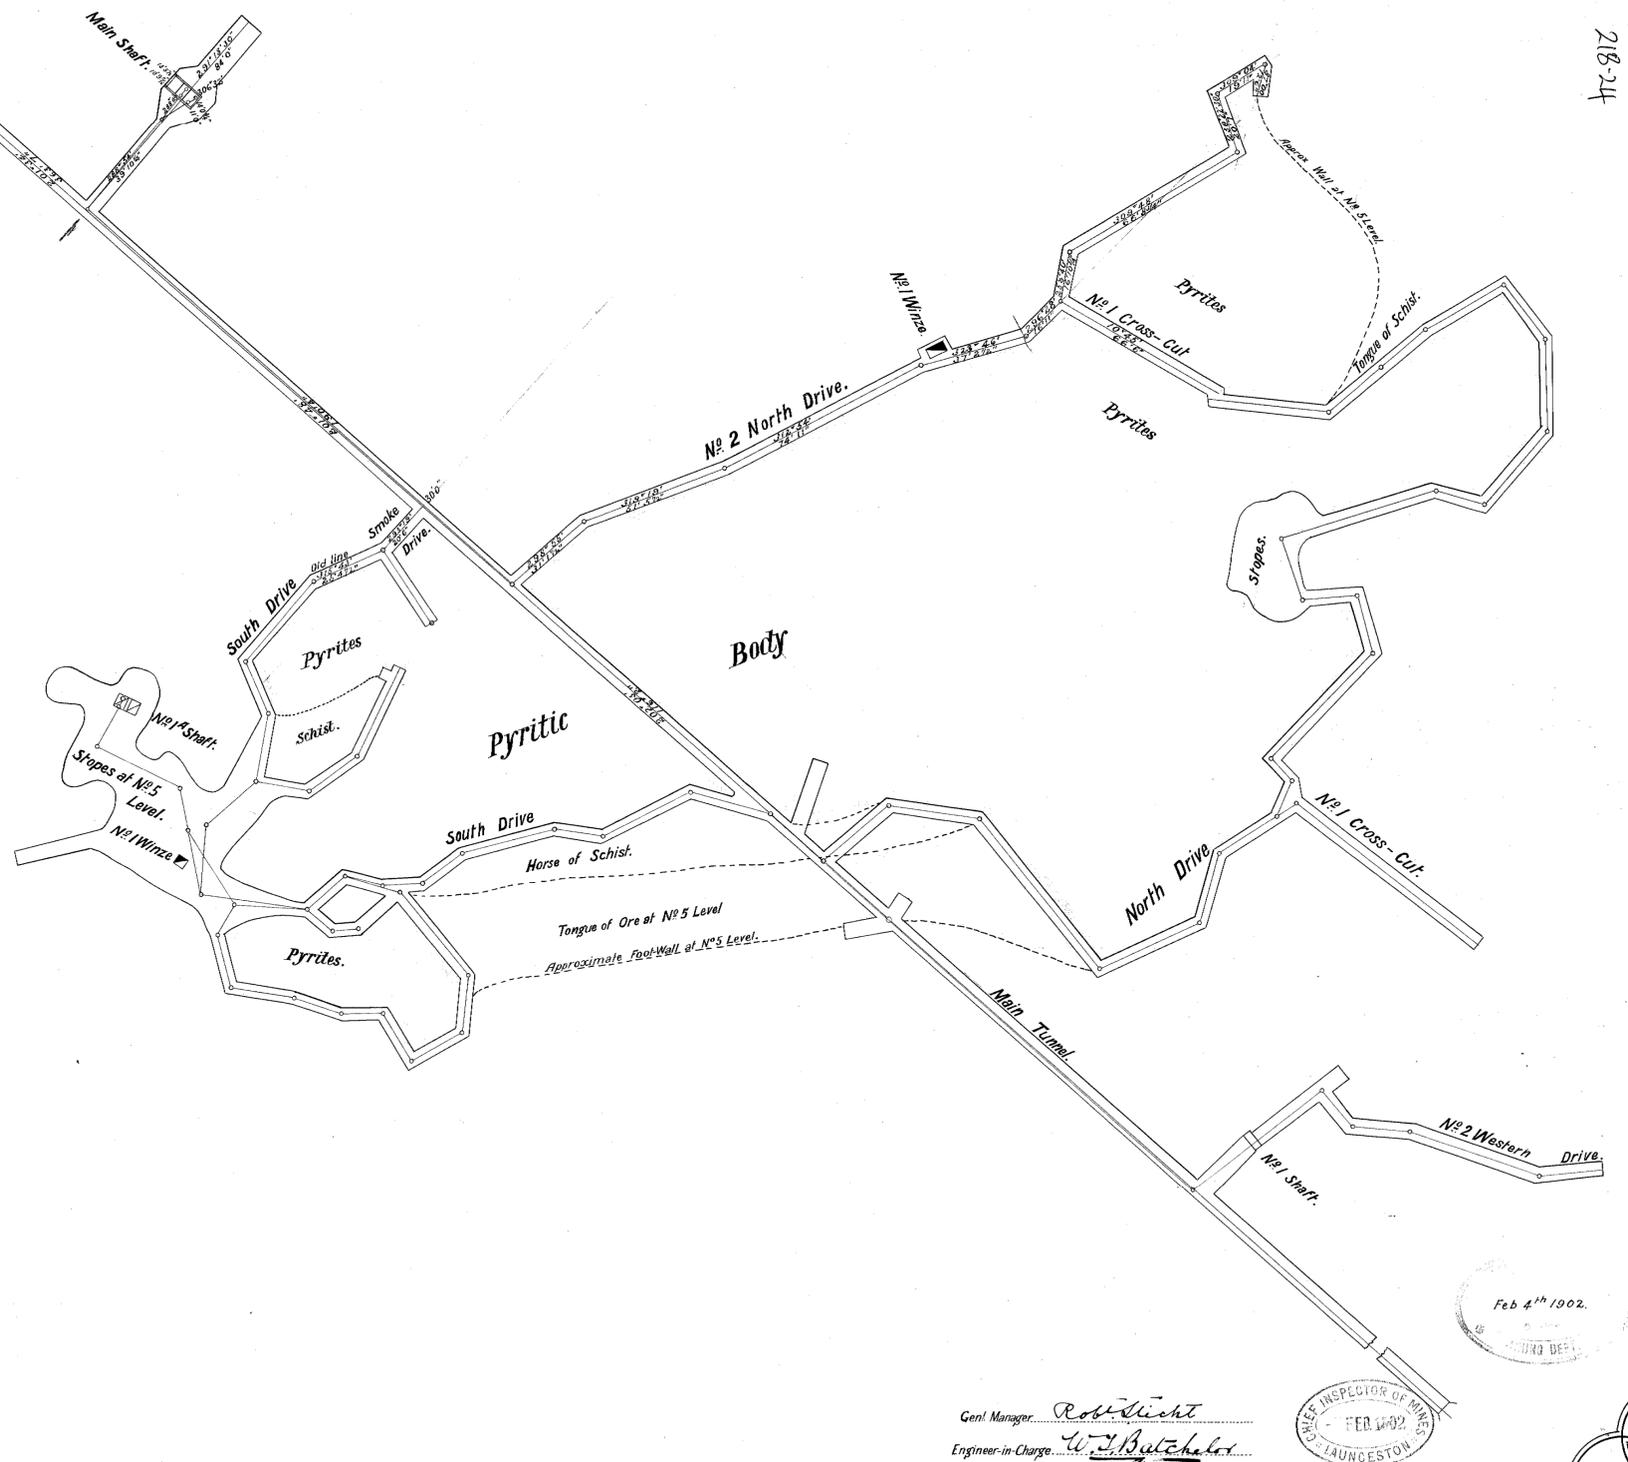

218-24

50m

218-24

Feb 4th 1902.

Genl. Manager. *Robt. Slicht*
Engineer-in-Charge. *W. J. Butcher*

