


218-28

218-28

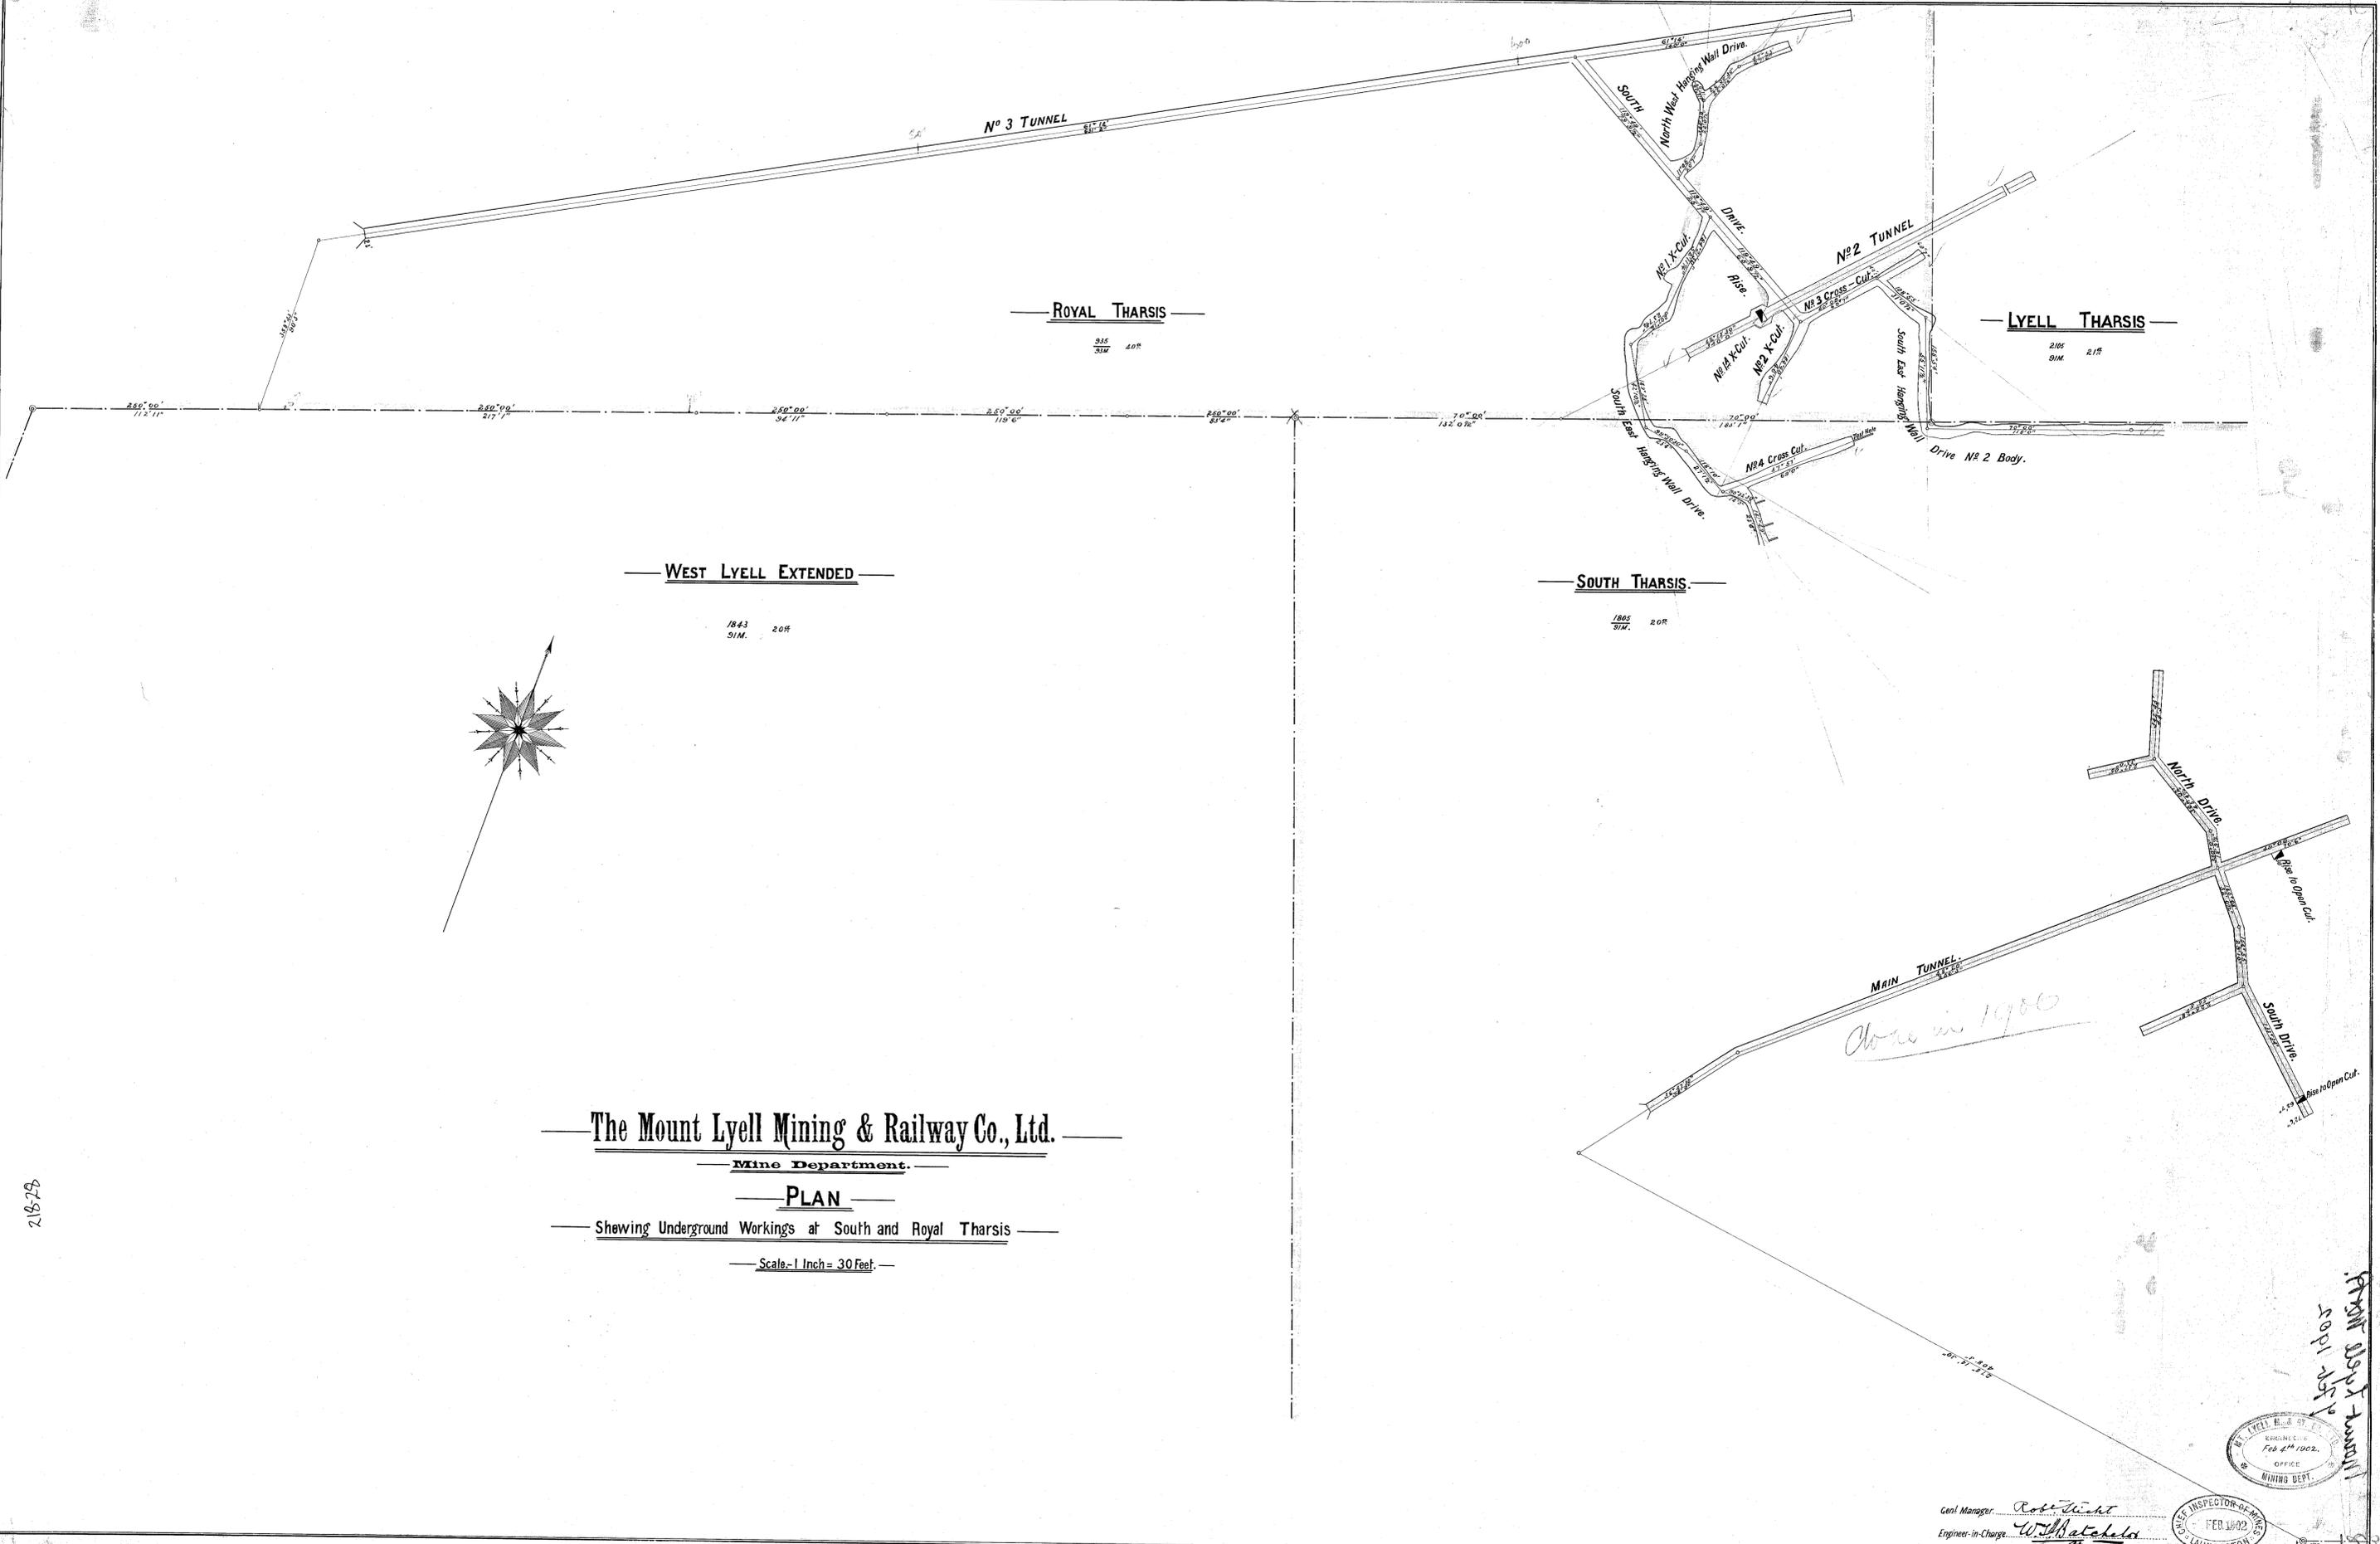

The Mount Lyell Mining & Railway Co., Ltd.

Mine Department.

PLAN

Showing Underground Workings at South and Royal Tharsis

Scale - 1 Inch = 30 Feet.



Genl. Manager: *Robert Smith*
 Engineer-in-Charge: *W. H. Hatchell*



*Printed by J. H. Smith
 2001, 2012*