

GLEN LYELL

1854
91M.

The Mount Lyell Mining & Railway Co., Ltd.

Mine Department.



Plan of Underground Workings Glen Lyell Section

Scale - 1 Inch = 30 Feet

Sheet No. 1.

THE MOUNT LYELL M & R CO. LTD.

23
53.

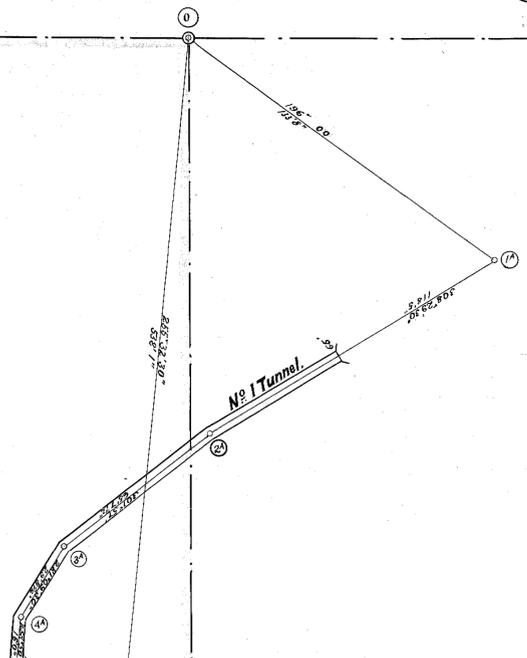
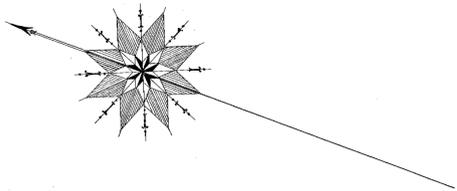


218-30

5 cm

THE MOUNT LYELL COPPER ESTATES LTD.

3
93.

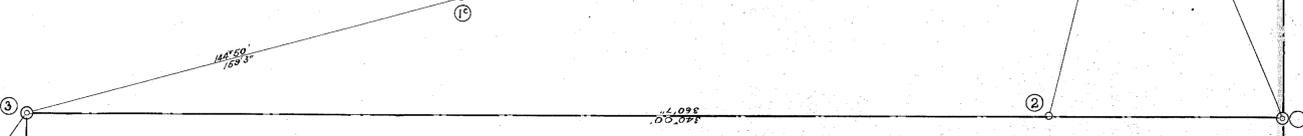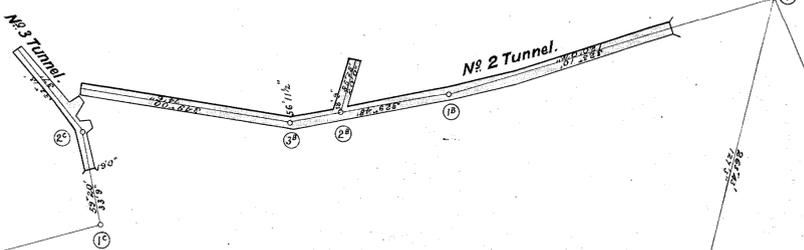

GLEN LYELL

117
98.



Genl Manager: R. G. ...
Engineer in Charge: W. ...

218-30