


5 cm

218-35

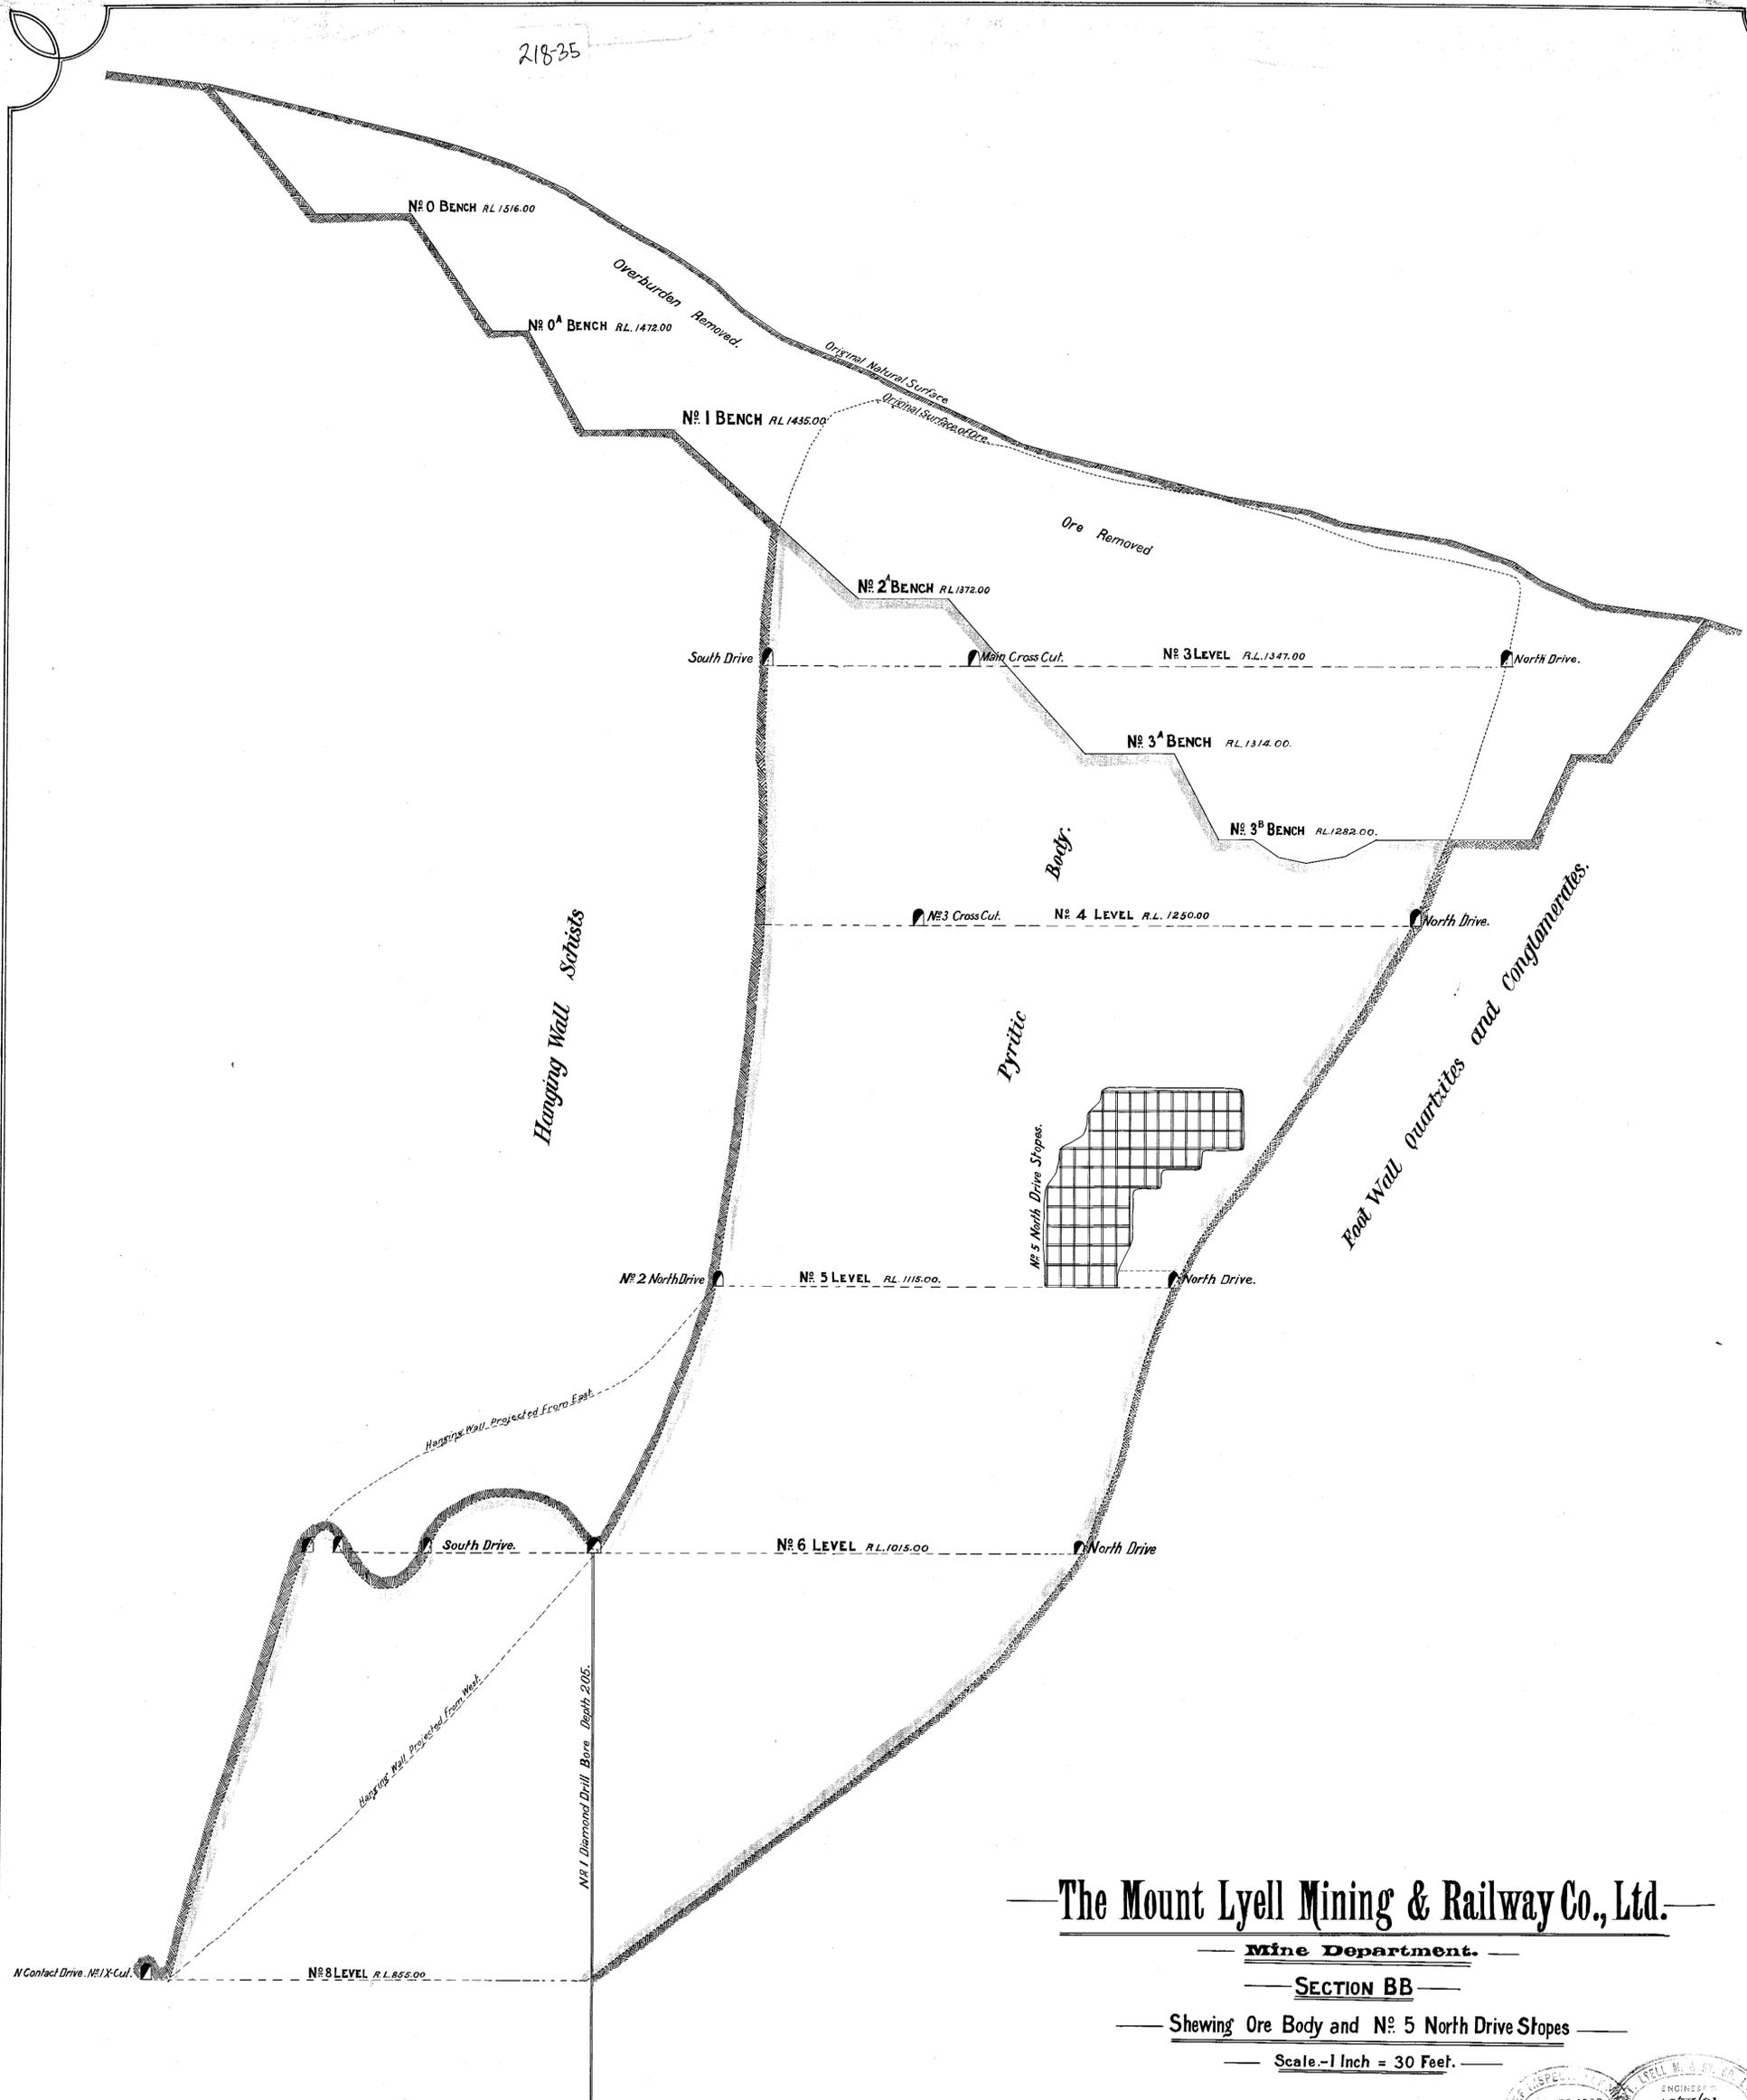

# The Mount Lyell Mining & Railway Co., Ltd.

Mine Department.

SECTION BB

Shewing Ore Body and Nº 5 North Drive Stopes

Scale.—1 Inch = 30 Feet.—



Genl. Manager *R. J. Light*  
 Engineer-in-Charge *W. W. Hatchel*