

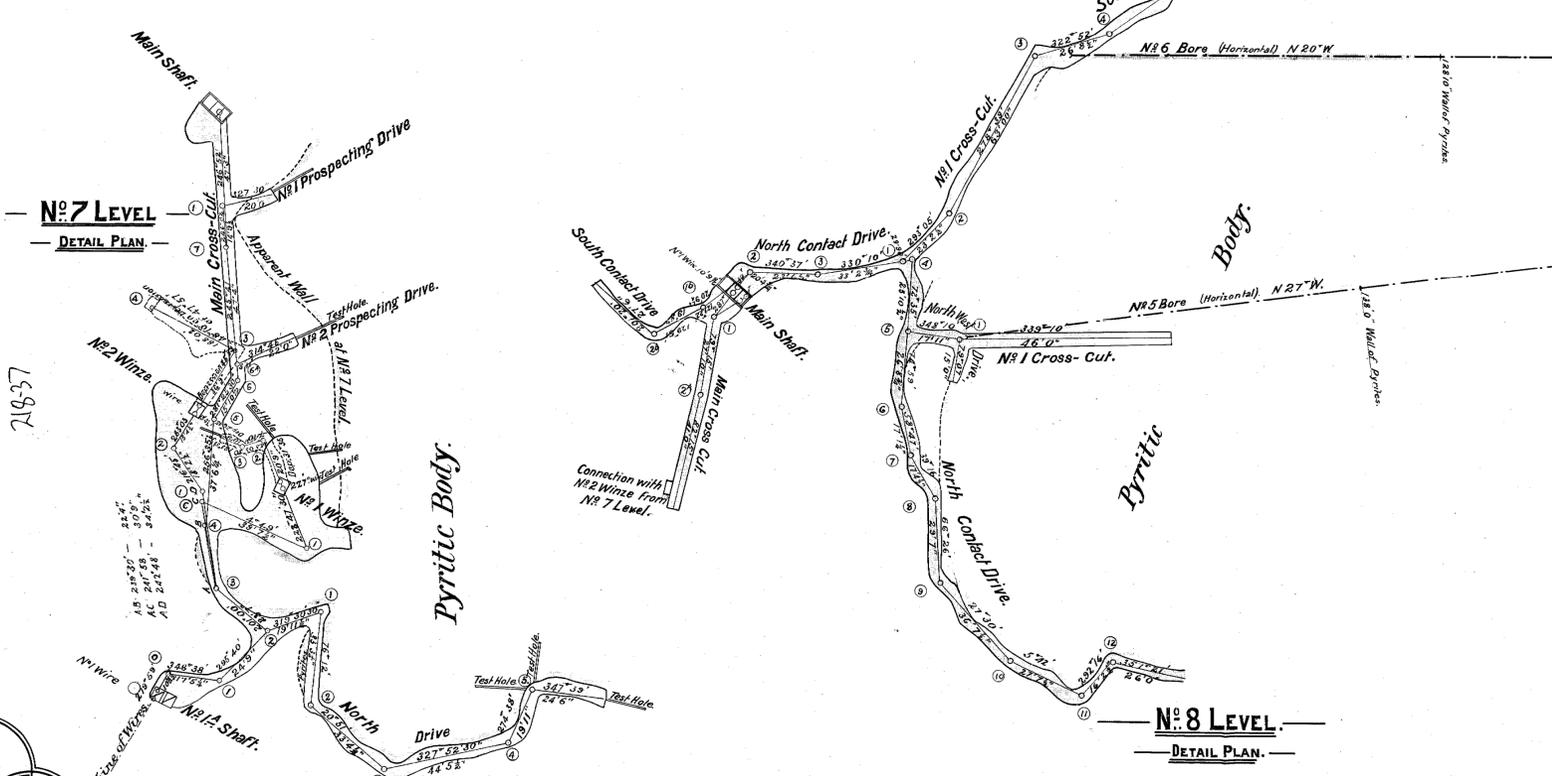
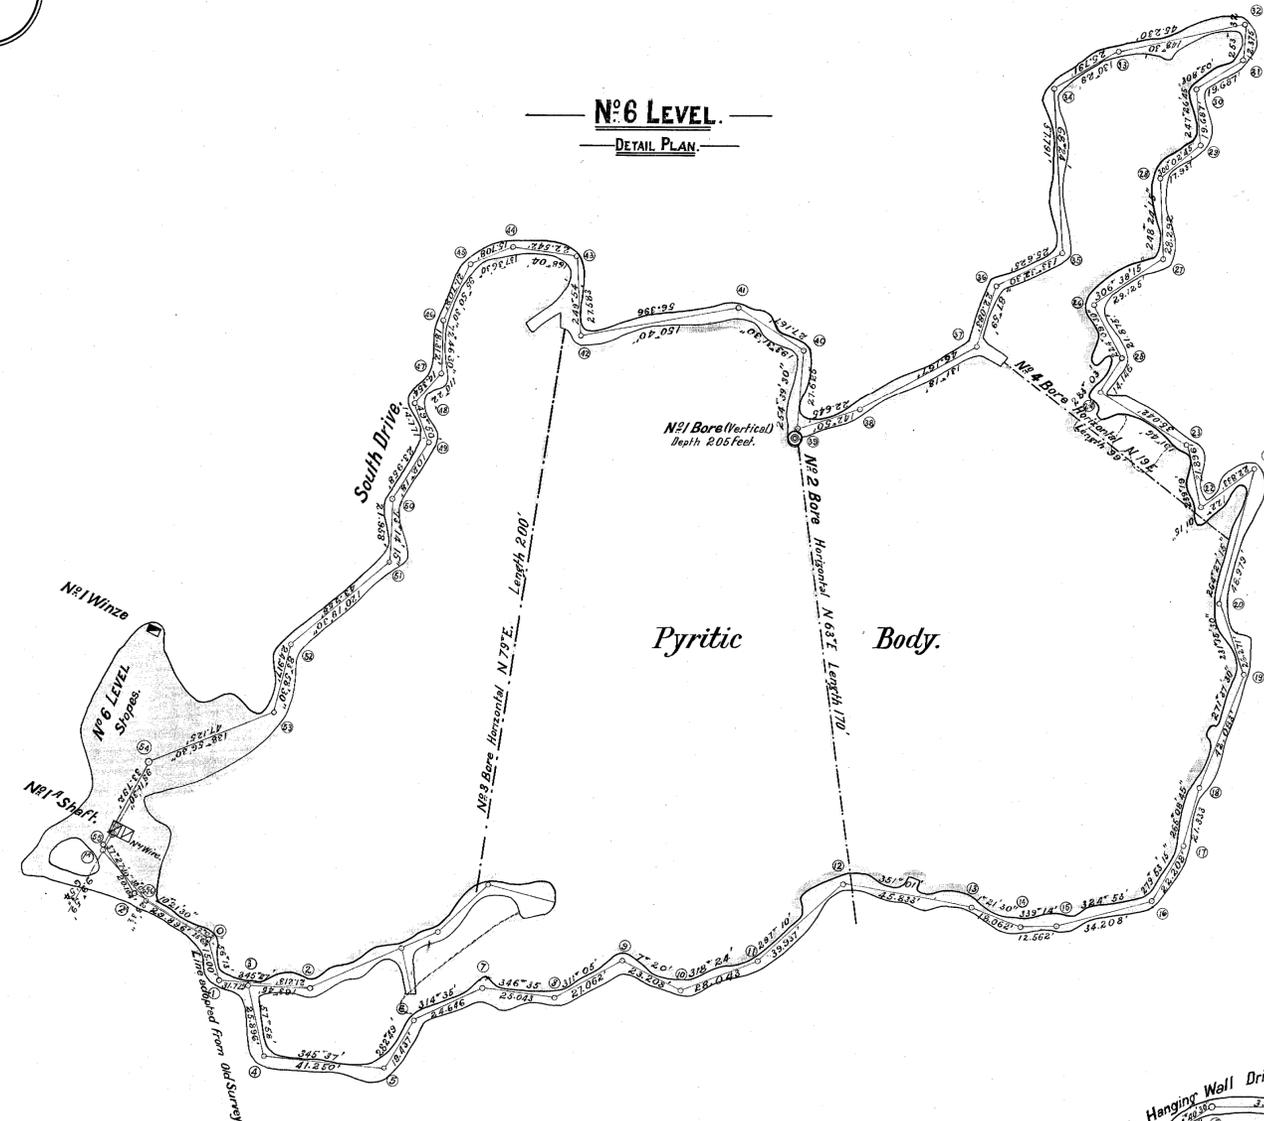


218-37

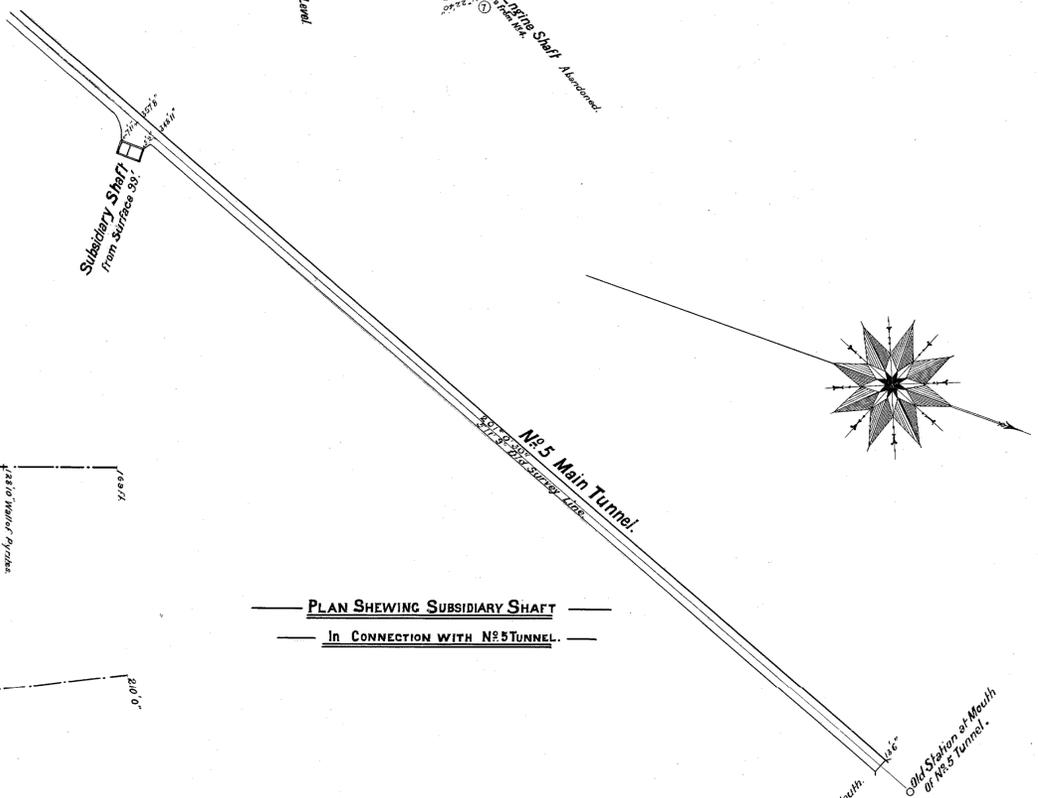

218-37

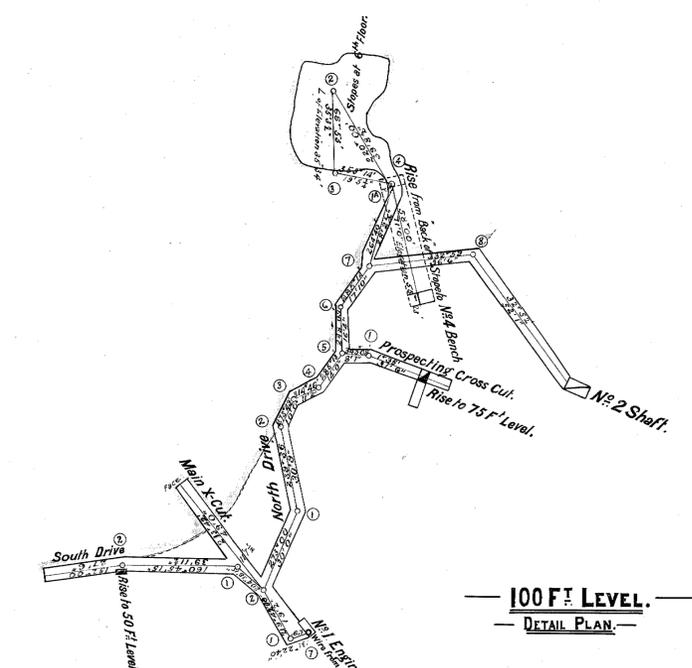

**The Mount Lyell Mining & Railway Co., Ltd.**

Mine Department.

**DETAILS OF UNDERGROUND WORKINGS**

SCALE, 1 INCH = 30 FEET.

Genl. Manager, *Robert Licht*  
Engineer-in-Charge, *W. H. Hatch*

