

The Mount Lyell Mining & Railway Co., Ltd.


Mine Department.

Plan Shewing Royal Tharsis N^o 1 and 4 Tunnels

Scale - 1 Inch = 30 Feet.

N.M.L. LYELL CONSOLIDATED.

M.L. LYELL RESERVE.

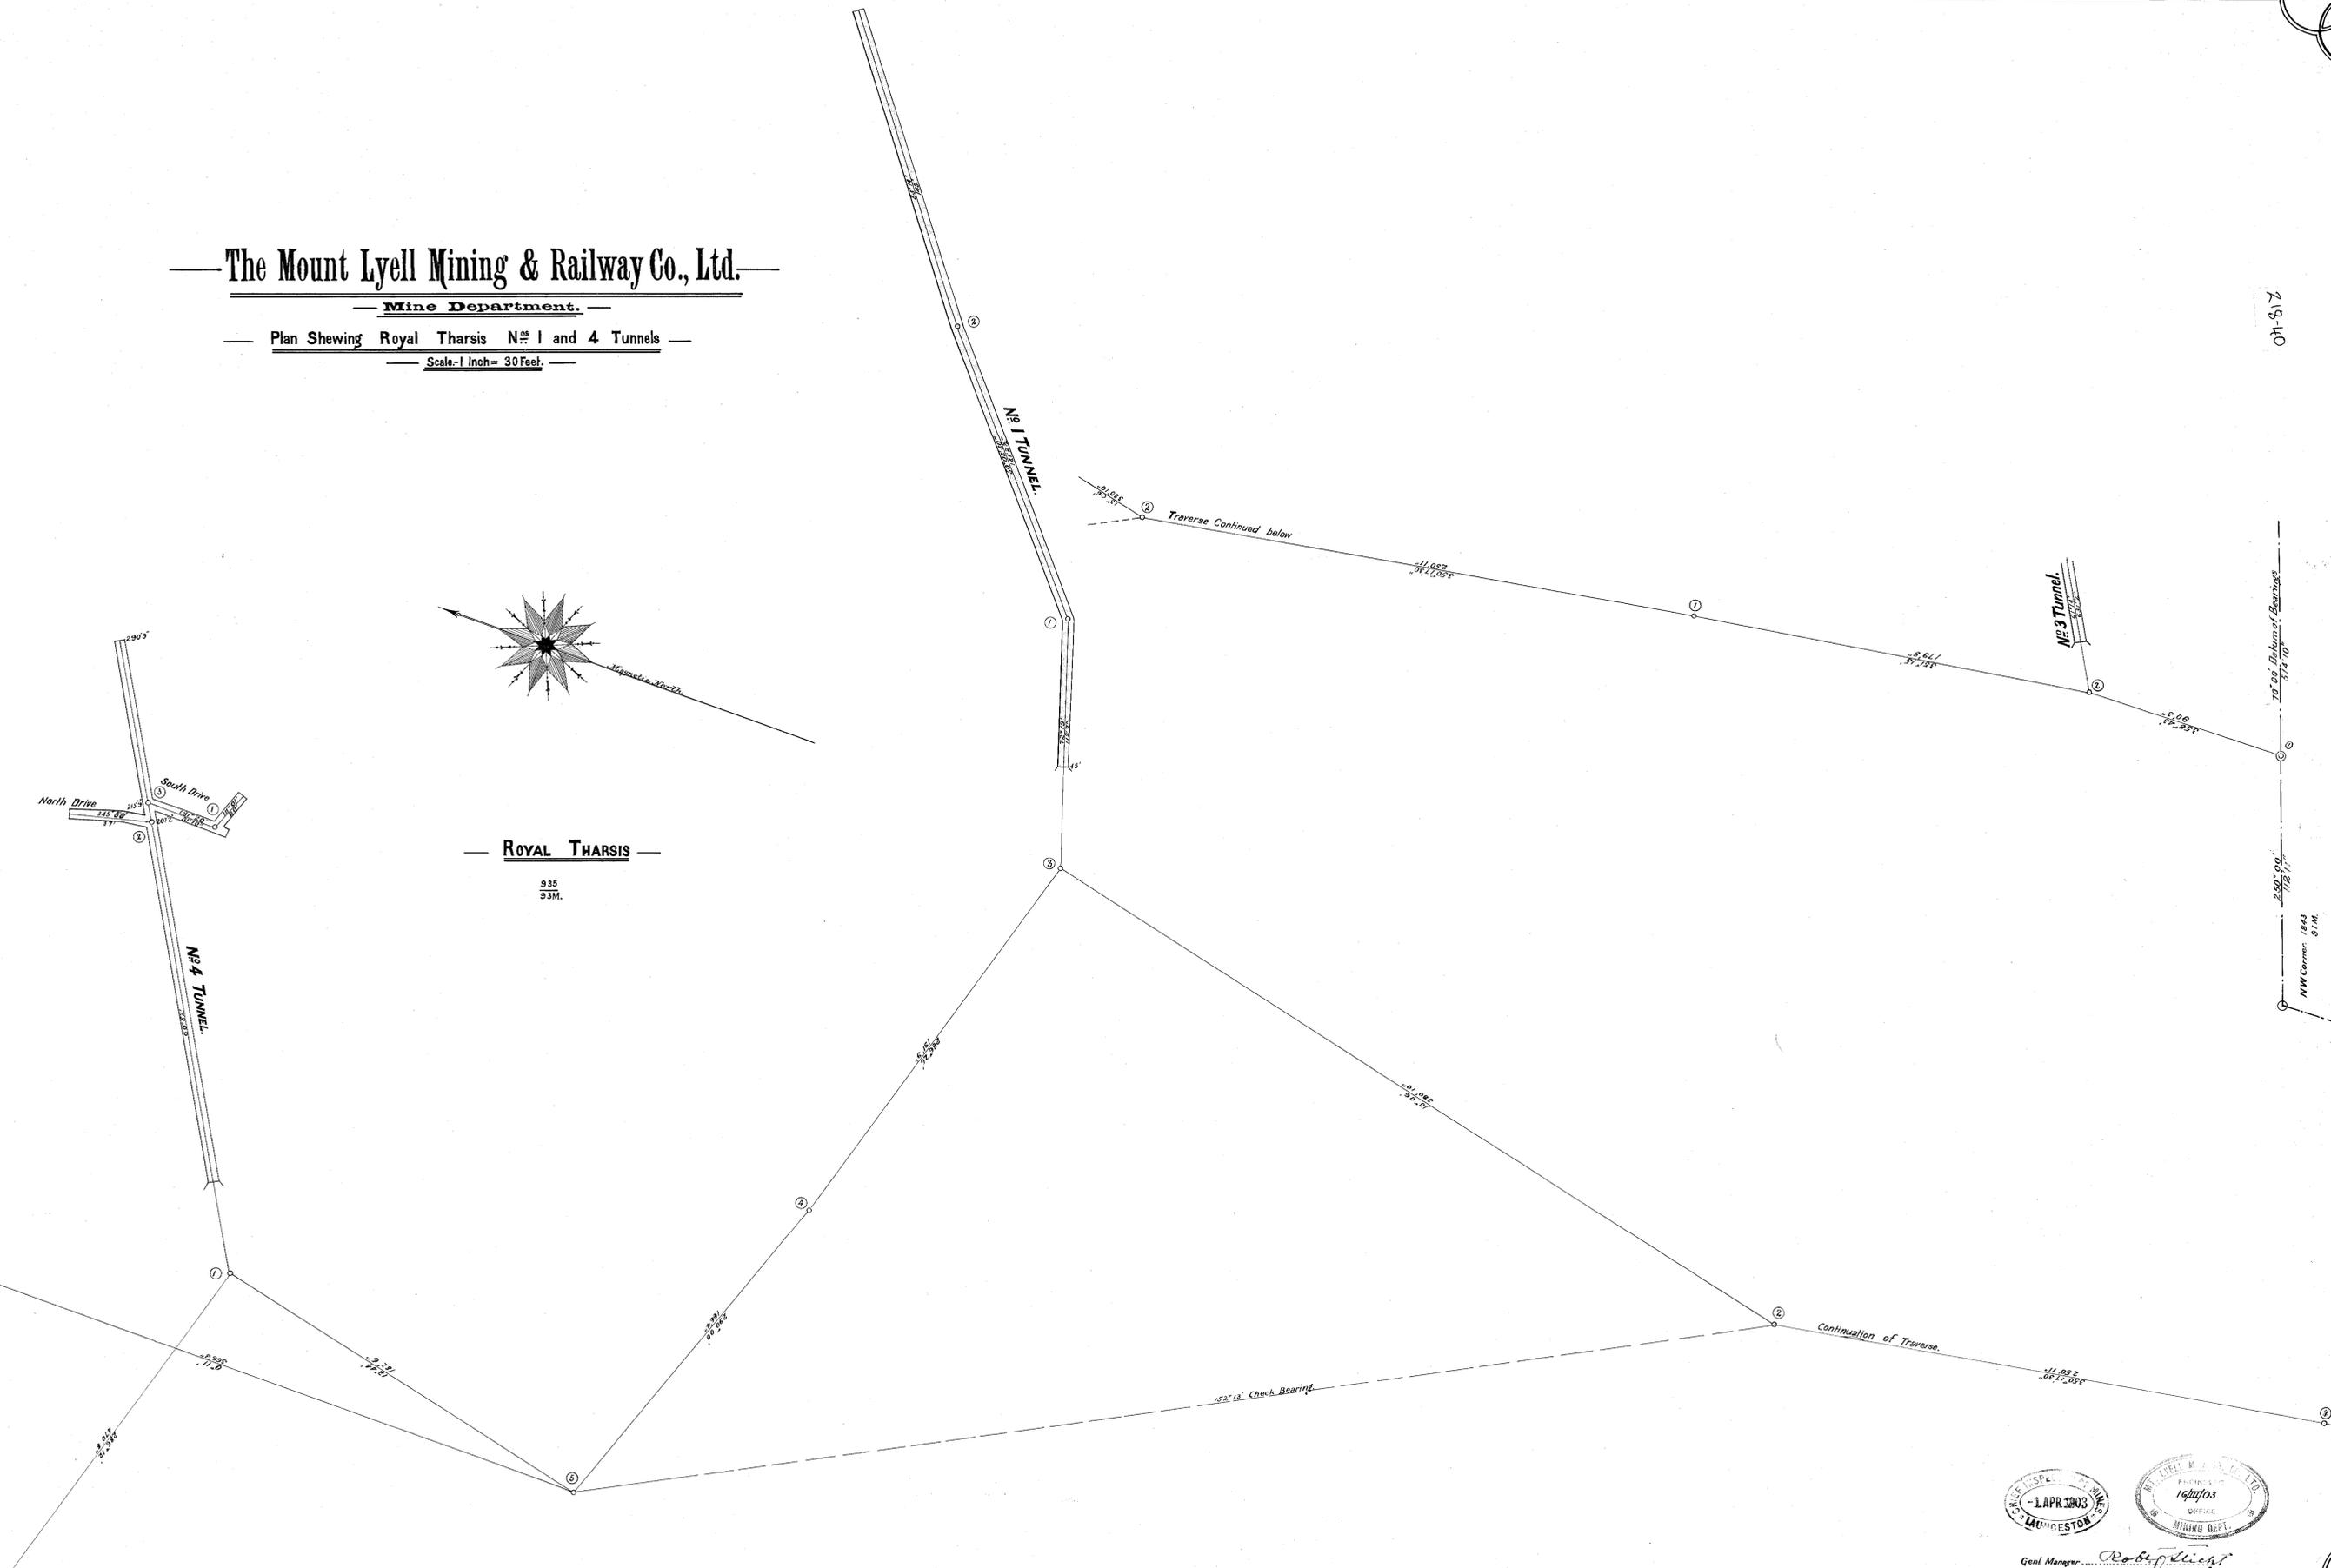

Genl Manger.....
Engineer-in-Charge.....

218-110

218-110