


50m

218-41

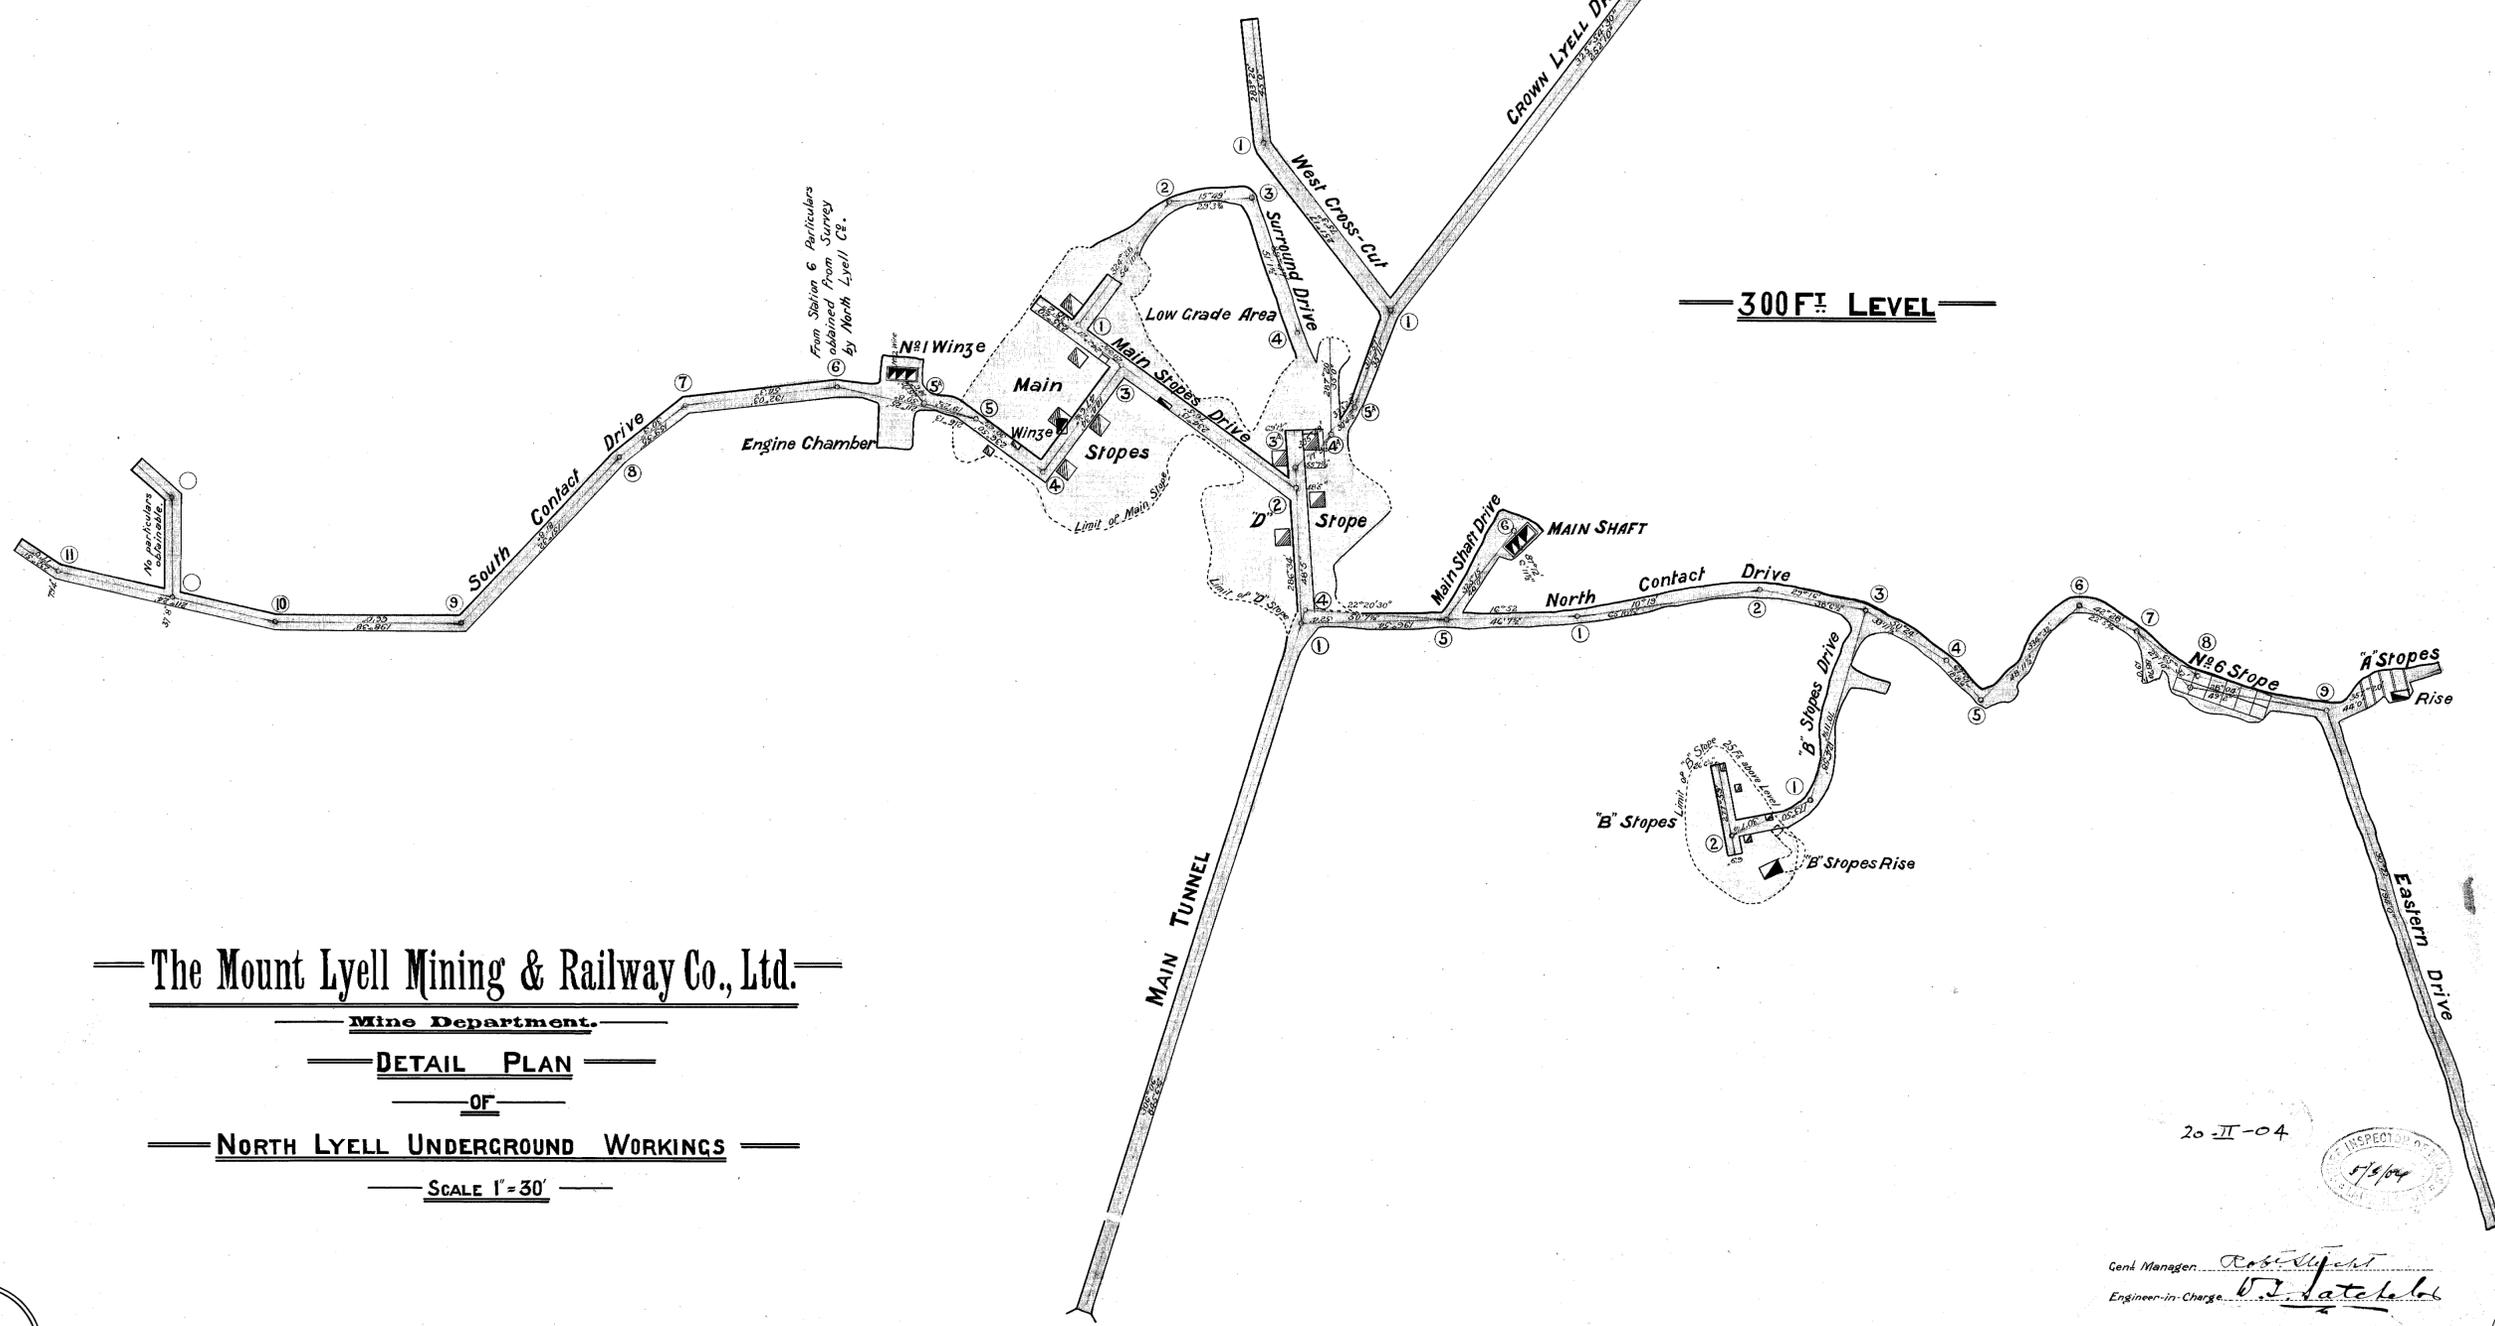

The Mount Lyell Mining & Railway Co., Ltd.
 Mine Department.
DETAIL PLAN
 OF
NORTH LYELL UNDERGROUND WORKINGS
 SCALE 1" = 30'

20-II-04



Genl. Manager. *R. J. ...*
 Engineer-in-Charge. *V. J. ...*

218-41