


218-43

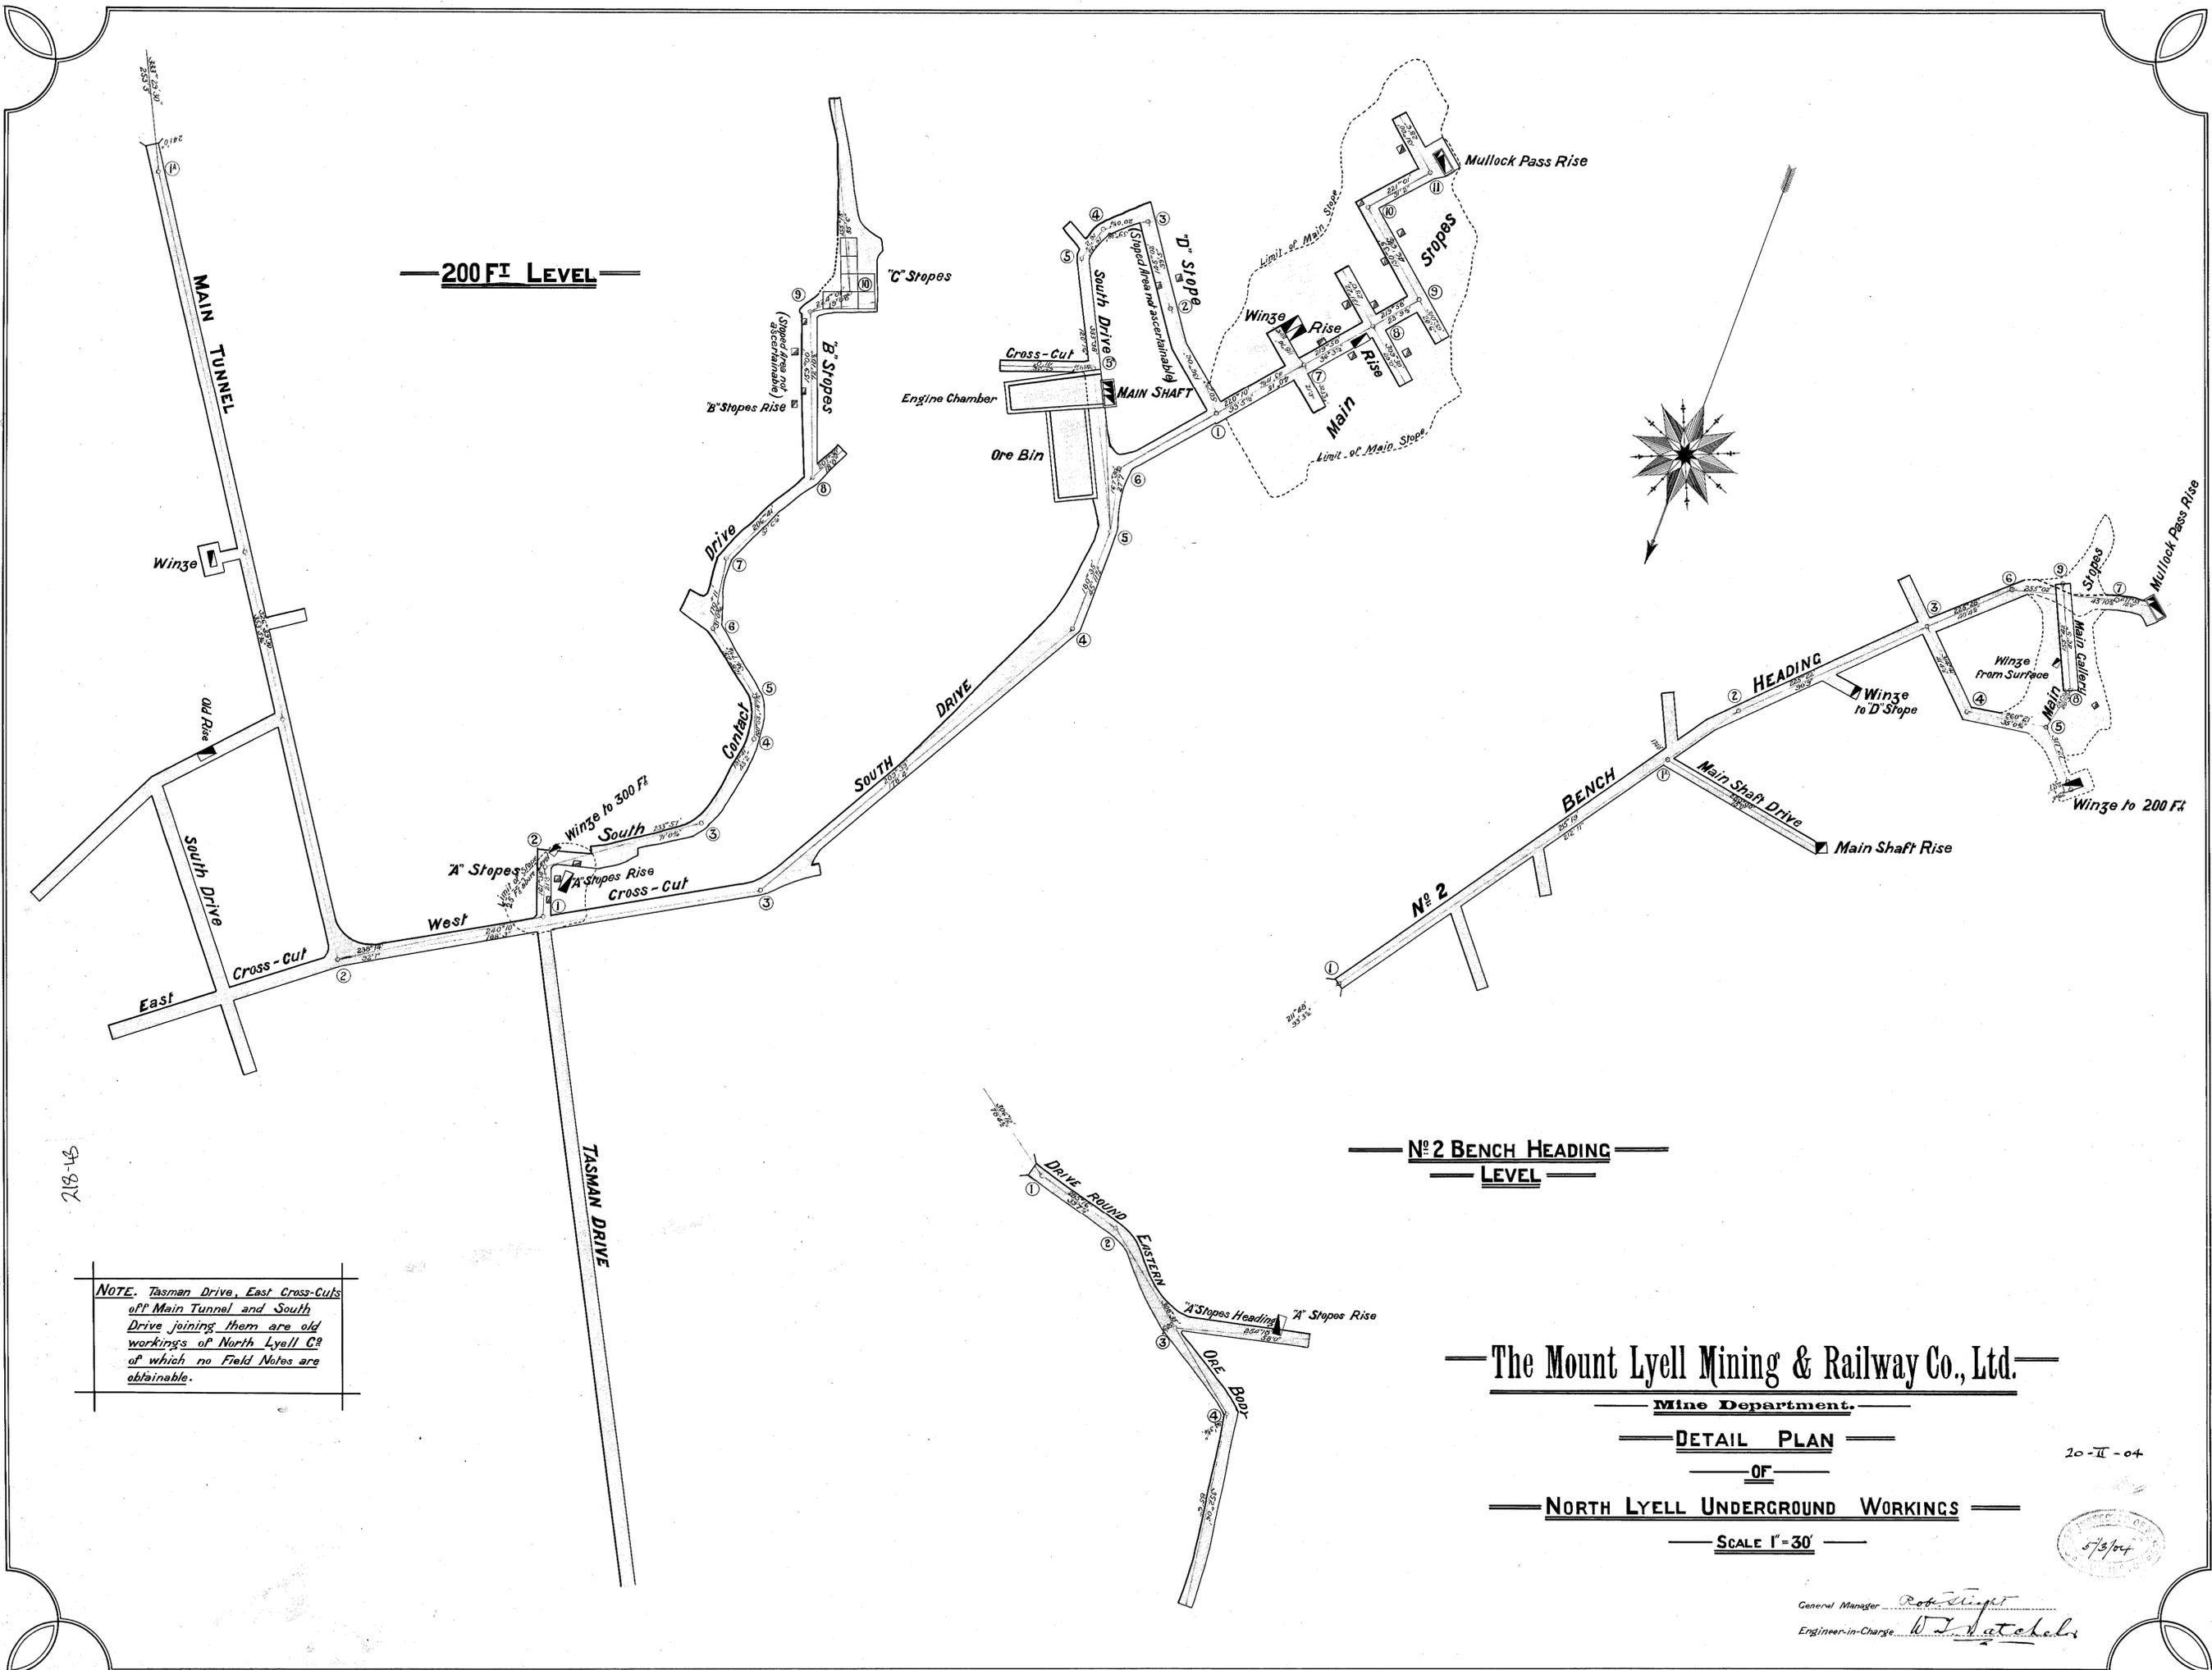

200 FT LEVEL

No. 2 BENCH HEADING LEVEL

218-45

NOTE. Tasman Drive, East Cross-Cuts off Main Tunnel and South Drive joining them are old workings of North Lyell Co. of which no Field Notes are obtainable.

The Mount Lyell Mining & Railway Co., Ltd.

Mine Department.

DETAIL PLAN

OF

NORTH LYELL UNDERGROUND WORKINGS

SCALE 1" = 30'

20-II-04



General Manager *Robert Sturt*  
 Engineer-in-Charge *W. J. Kitchin*