



ES1

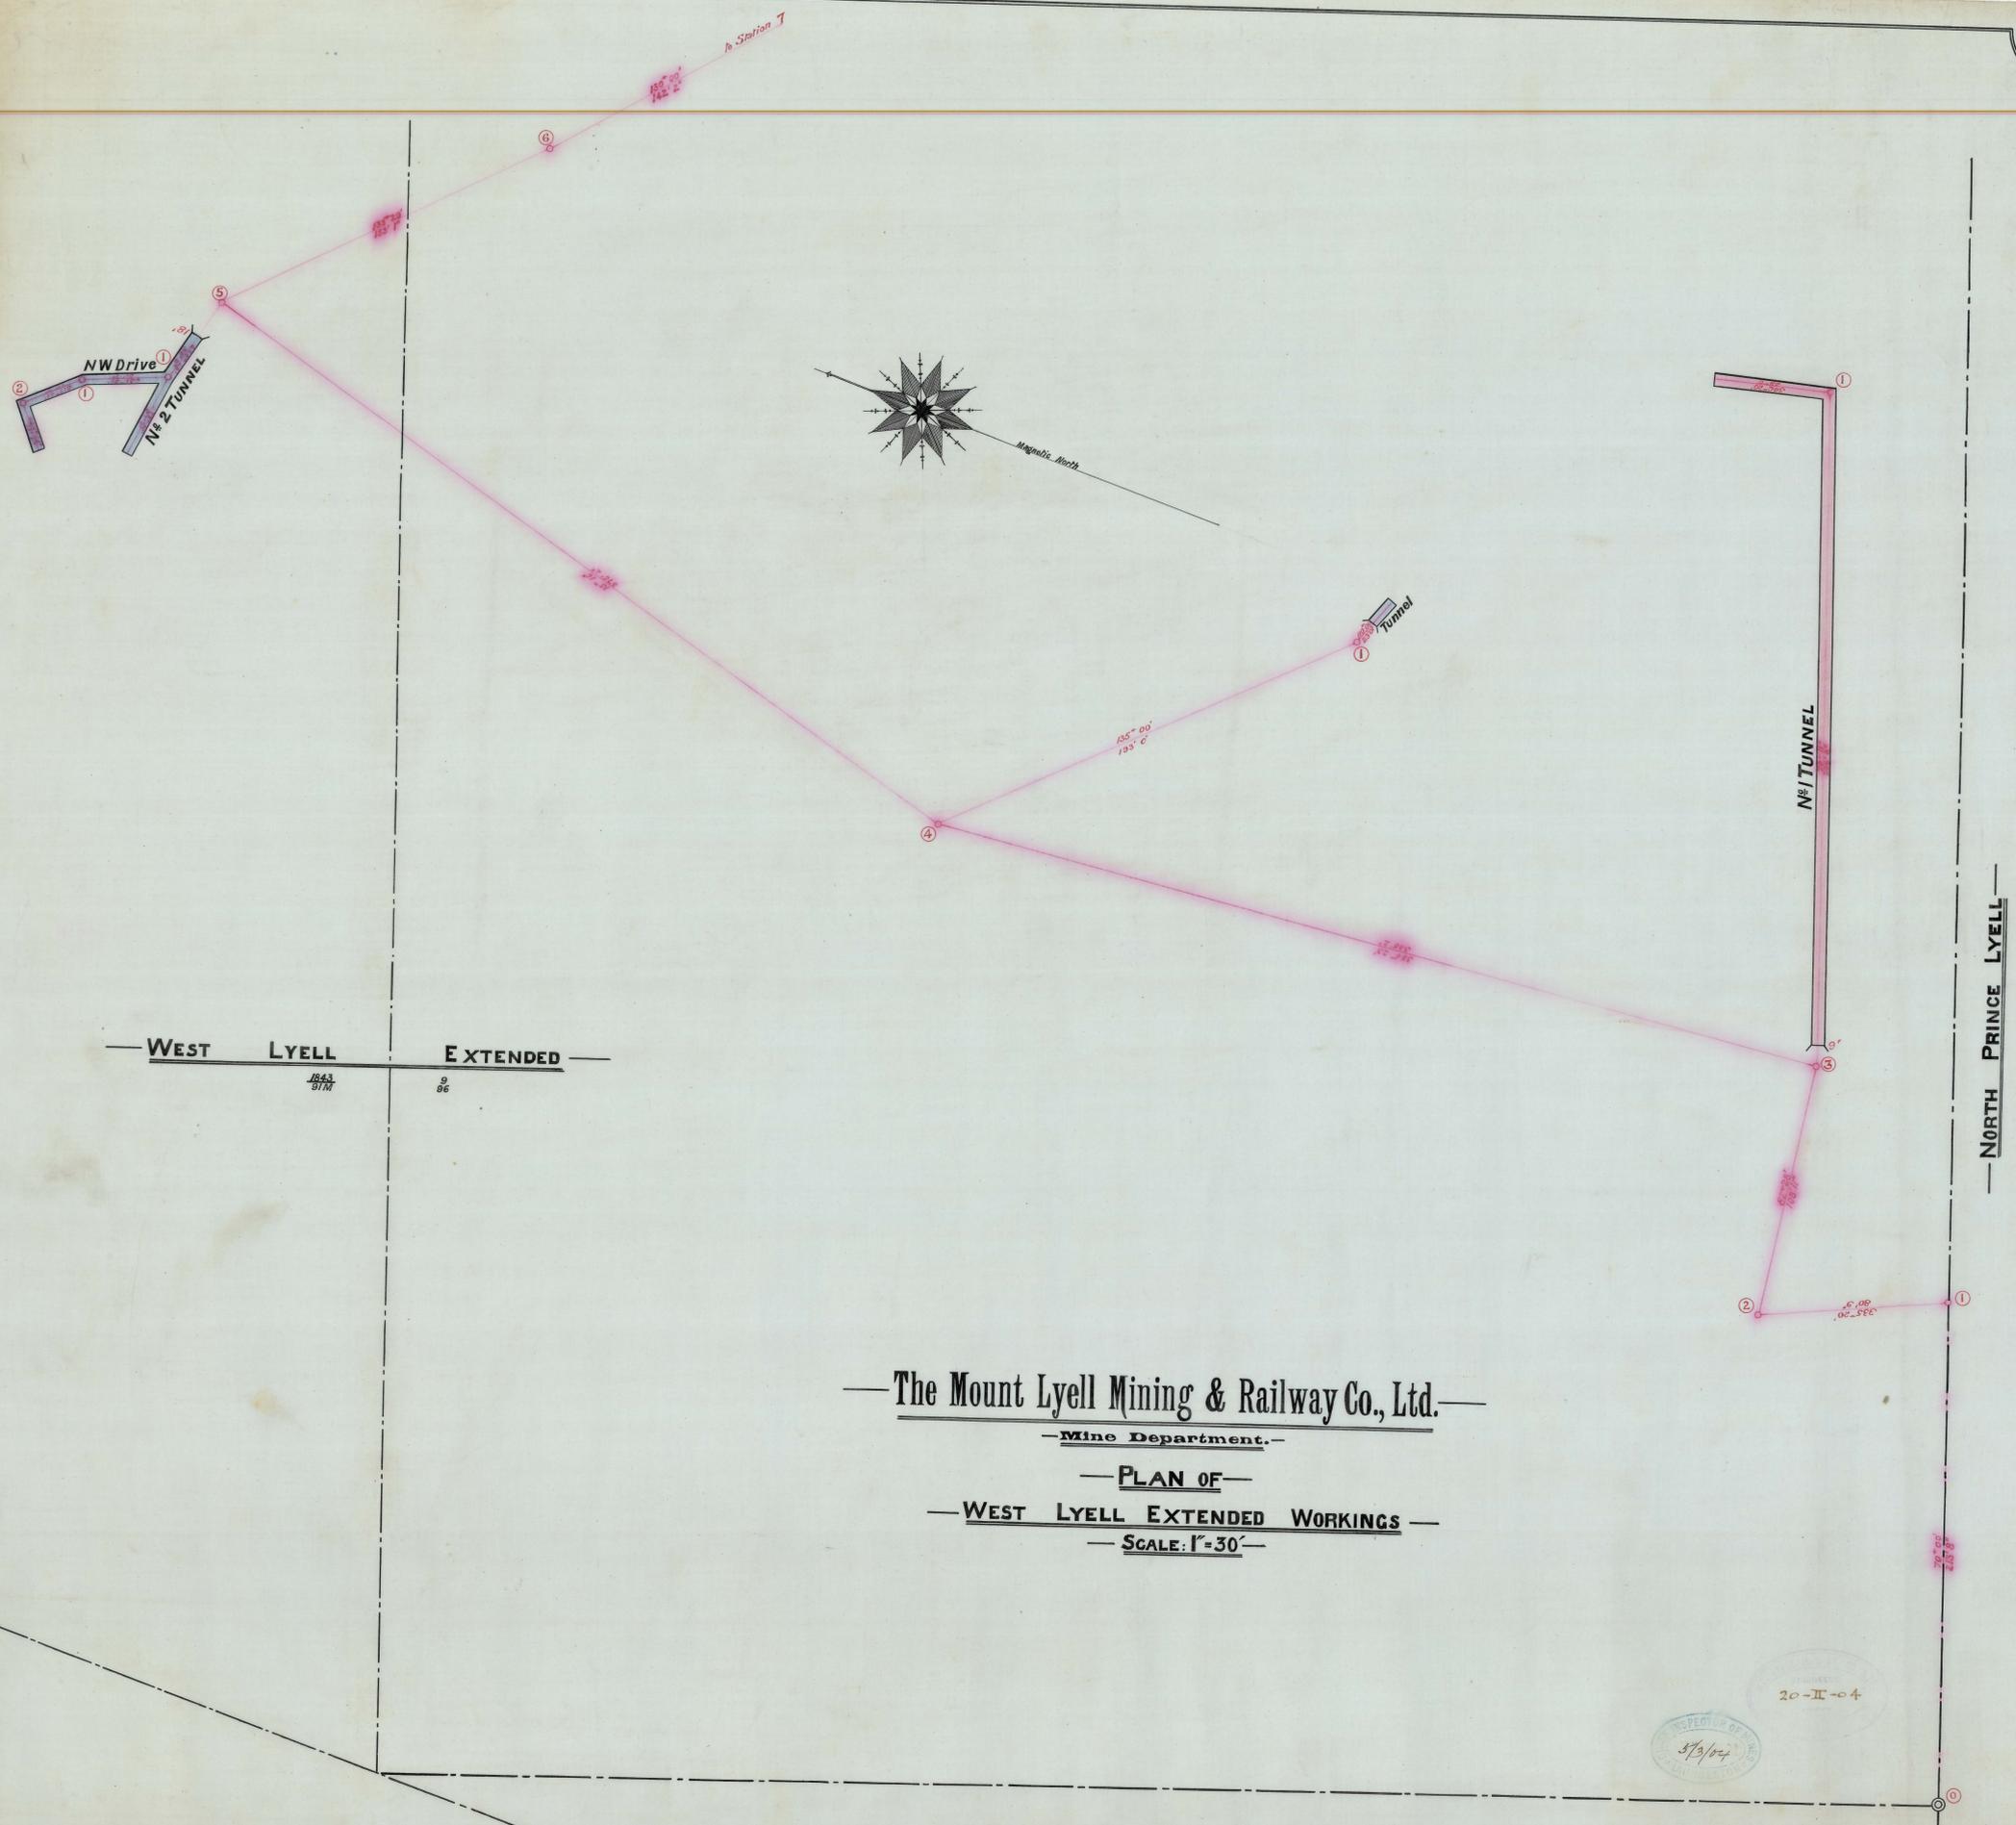

218-45

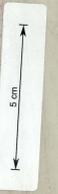

—The Mount Lyell Mining & Railway Co., Ltd.—
 —Mine Department.—
 —PLAN OF—
 —WEST LYELL EXTENDED WORKINGS—
 —SCALE: 1"=30'—

20-II-04
 INSPECTOR OF MINES
 3/3/04

—WEST LYELL EXTENDED—
 1843
 91M

Genl Manager *R. S. Smith*
 Engineer-in-Charge *H. J. Atcheli*