


218-46

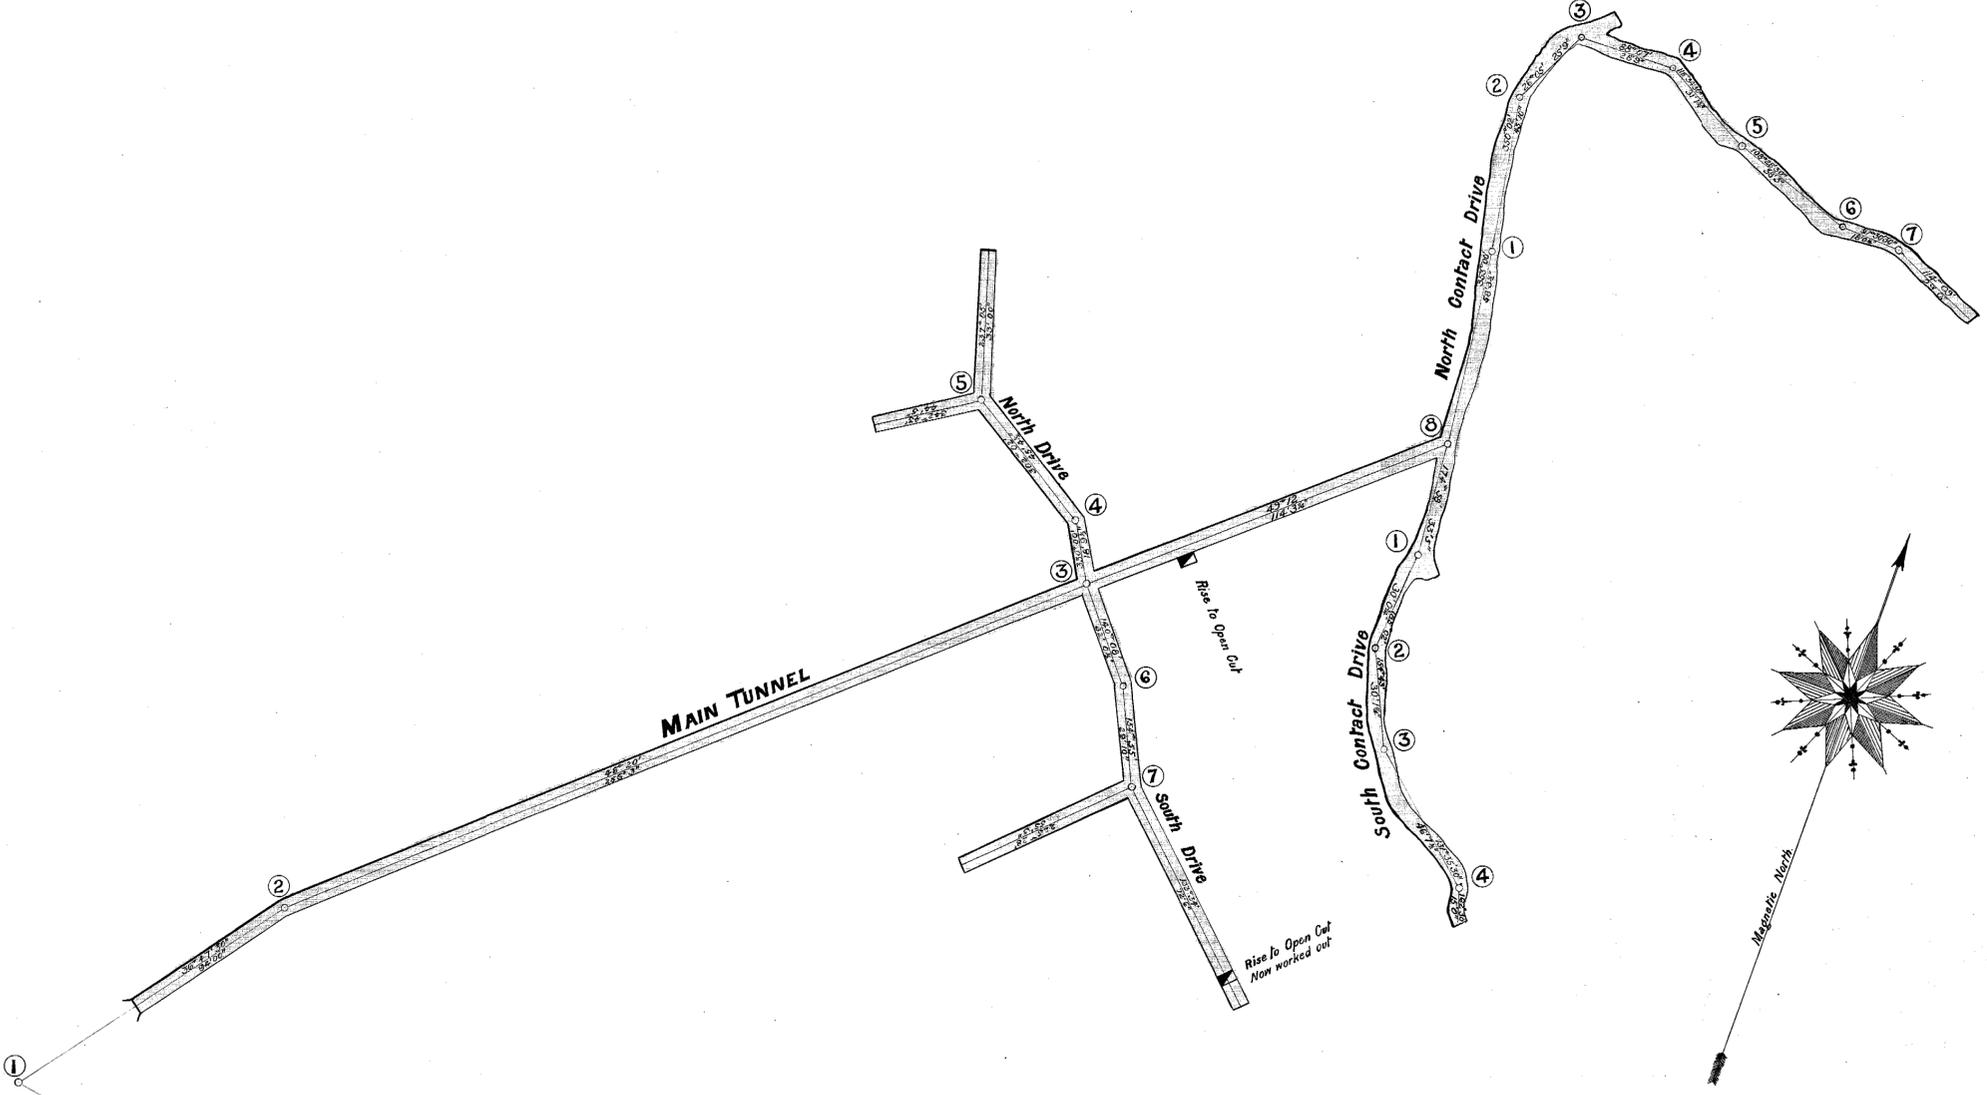

218-46

5 cm

SOUTH THARSIS

— **The Mount Lyell Mining & Railway Co., Ltd.** —
 — **Mine Department.** —
 — **PLAN OF** —
 — **SOUTH THARSIS UNDERGROUND WORKINGS** —
 — **SCALE 1"=30'** —



20-II-04

1805
91M

170
91

COPPER MINES OF M^T LYELL WEST LIM.

Cont. Manager *Robert V. ...*
 Engineer-in-Charge *W. J. ...*