

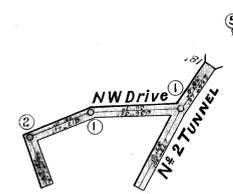


21846

ES1

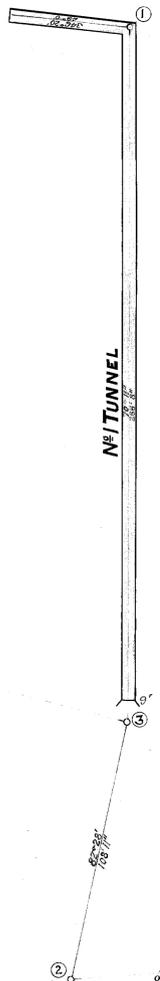

Station 7

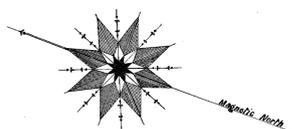


— WEST LYELL EXTENDED —  
 1863 S.M. 9 06

— NORTH PRINCE LYELL —

— The Mount Lyell Mining & Railway Co., Ltd. —  
 — Mine Department. —  
 — PLAN OF —  
 — WEST LYELL EXTENDED WORKINGS —  
 — SCALE: 1"=30' —

21845

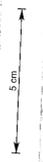

20-II-04



— WEST LYELL EXTENDED —  
 1863 S.M.

Genl. Manager *Robertson*  
 Engineer-in-Charge *D. J. Atchley*