


218-49

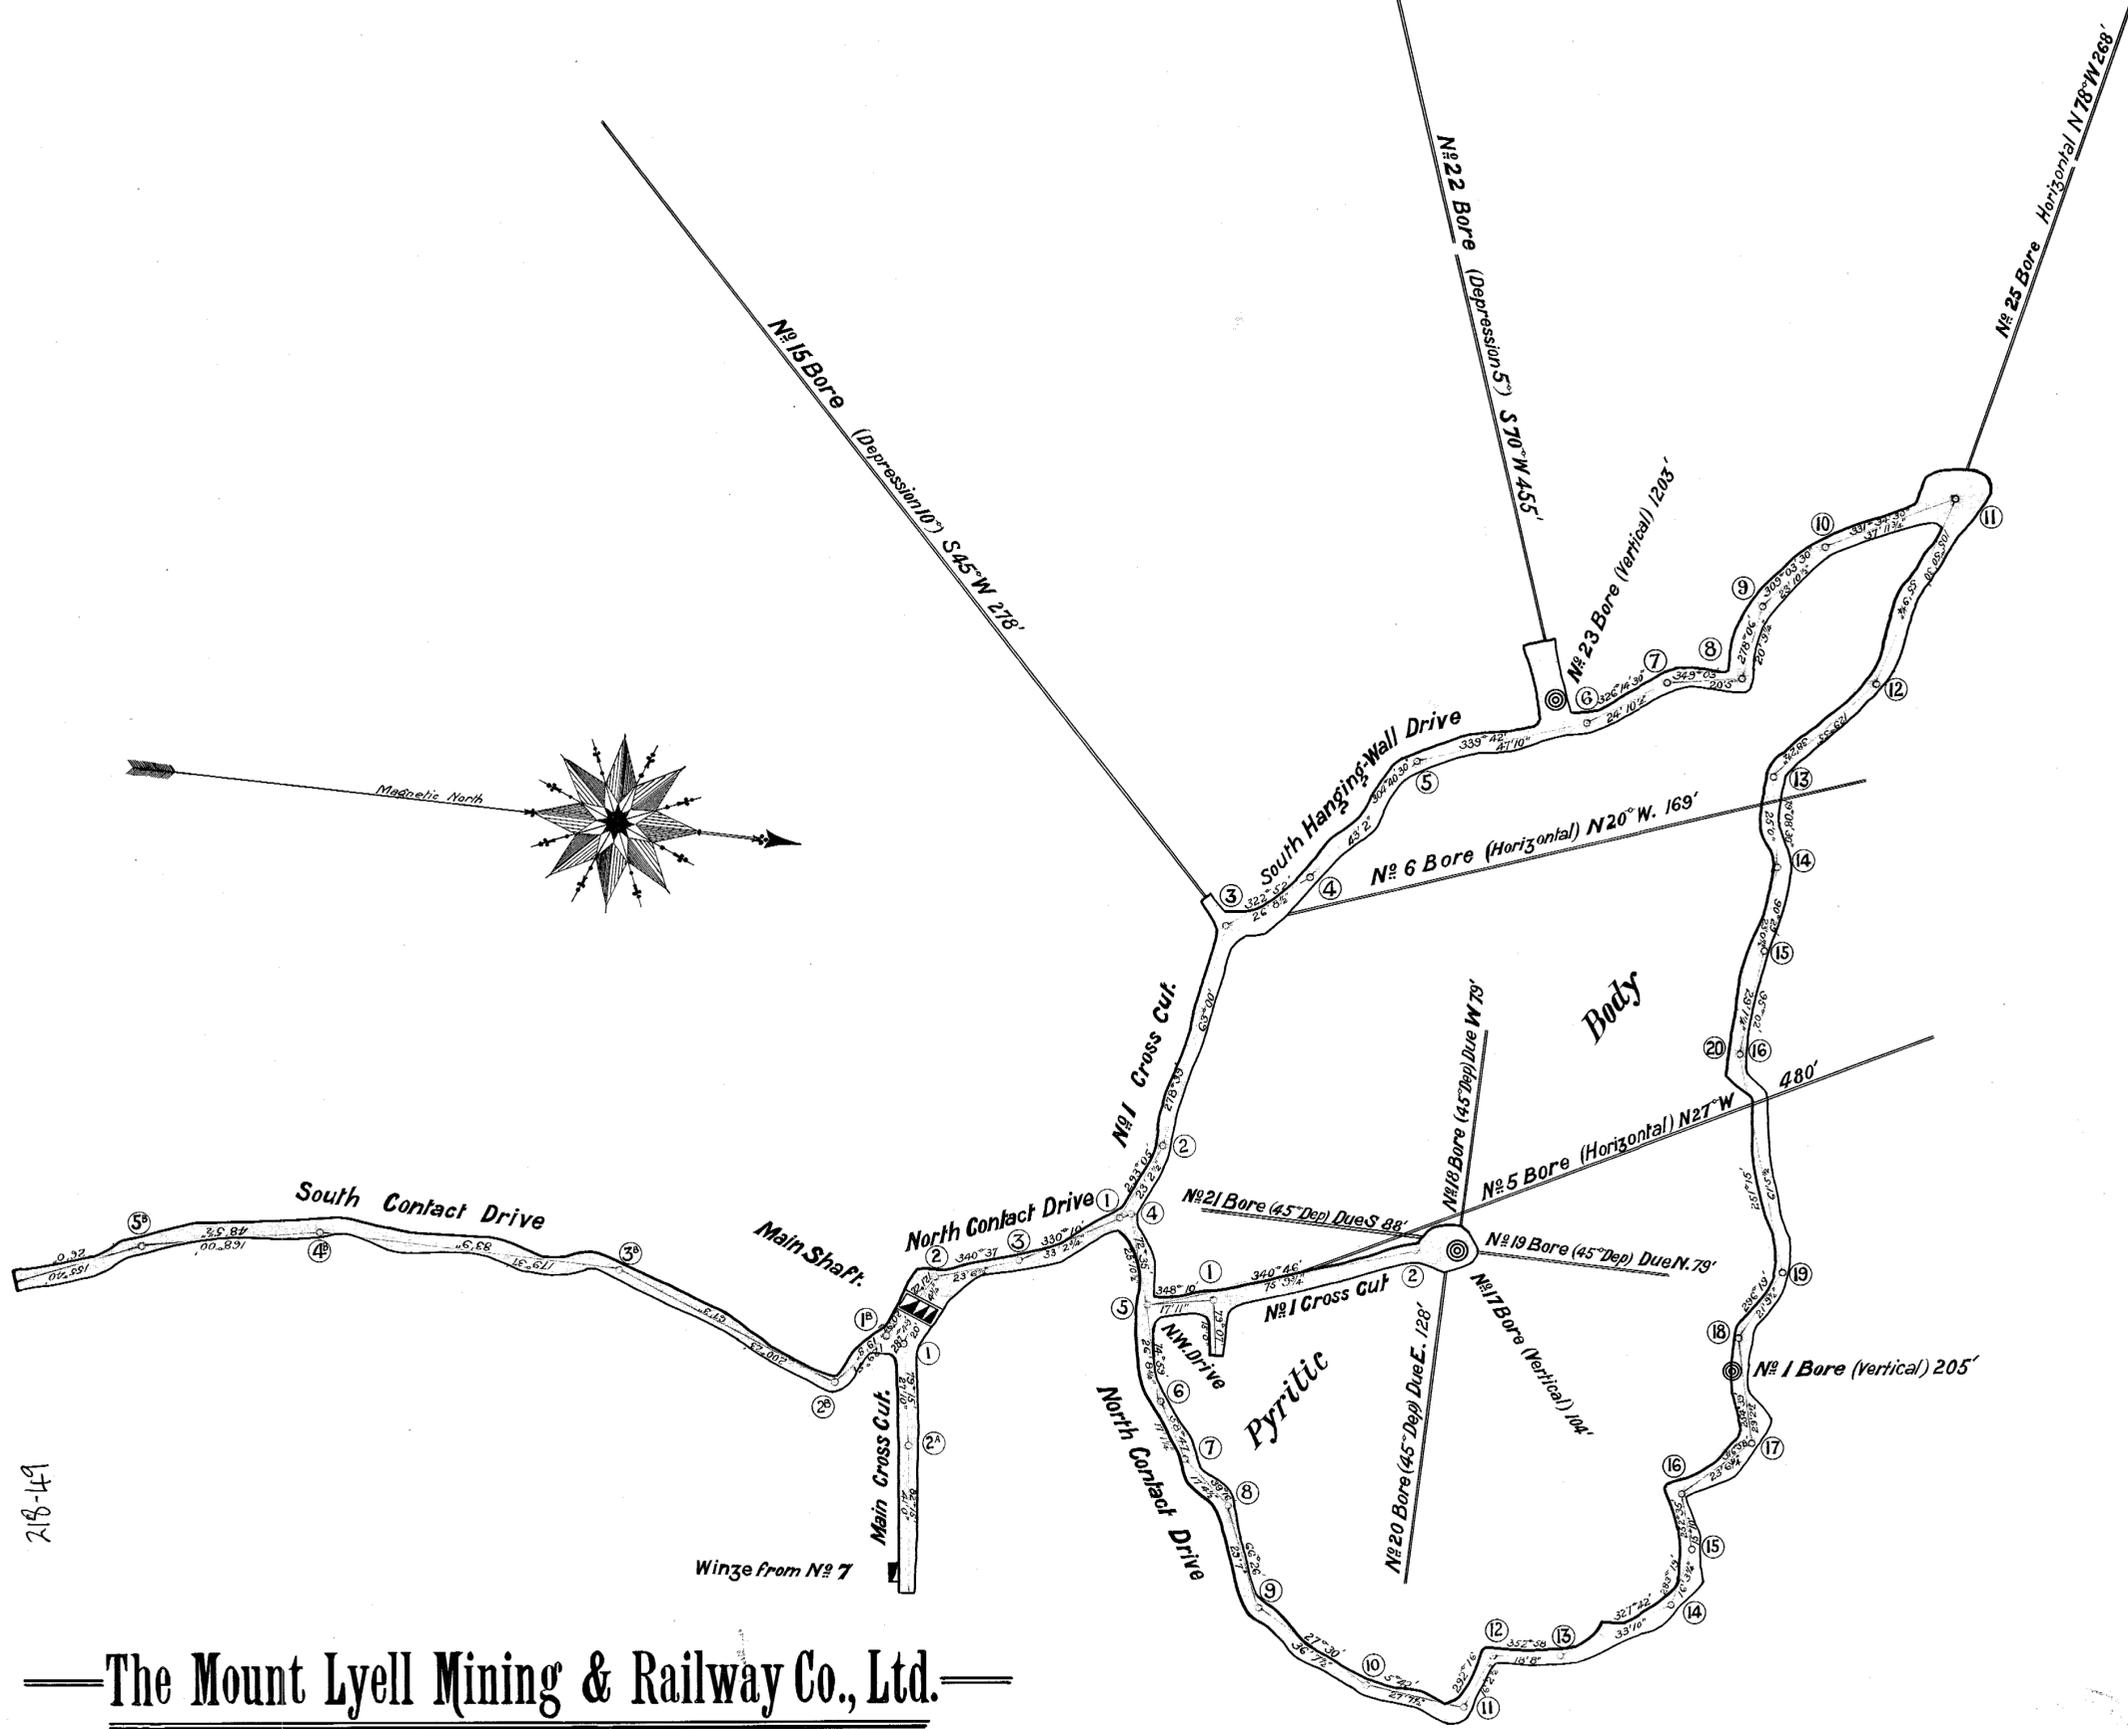

218-49

The Mount Lyell Mining & Railway Co., Ltd.

Mine Department.

DETAIL PLAN

OF

No. 8 LEVEL, MOUNT LYELL MINE

SCALE 1" = 30'



Genl. Manager *Robertson*
 Engineer-in-Charge *D. Satchel*

20-II-04