


5 cm

218-50

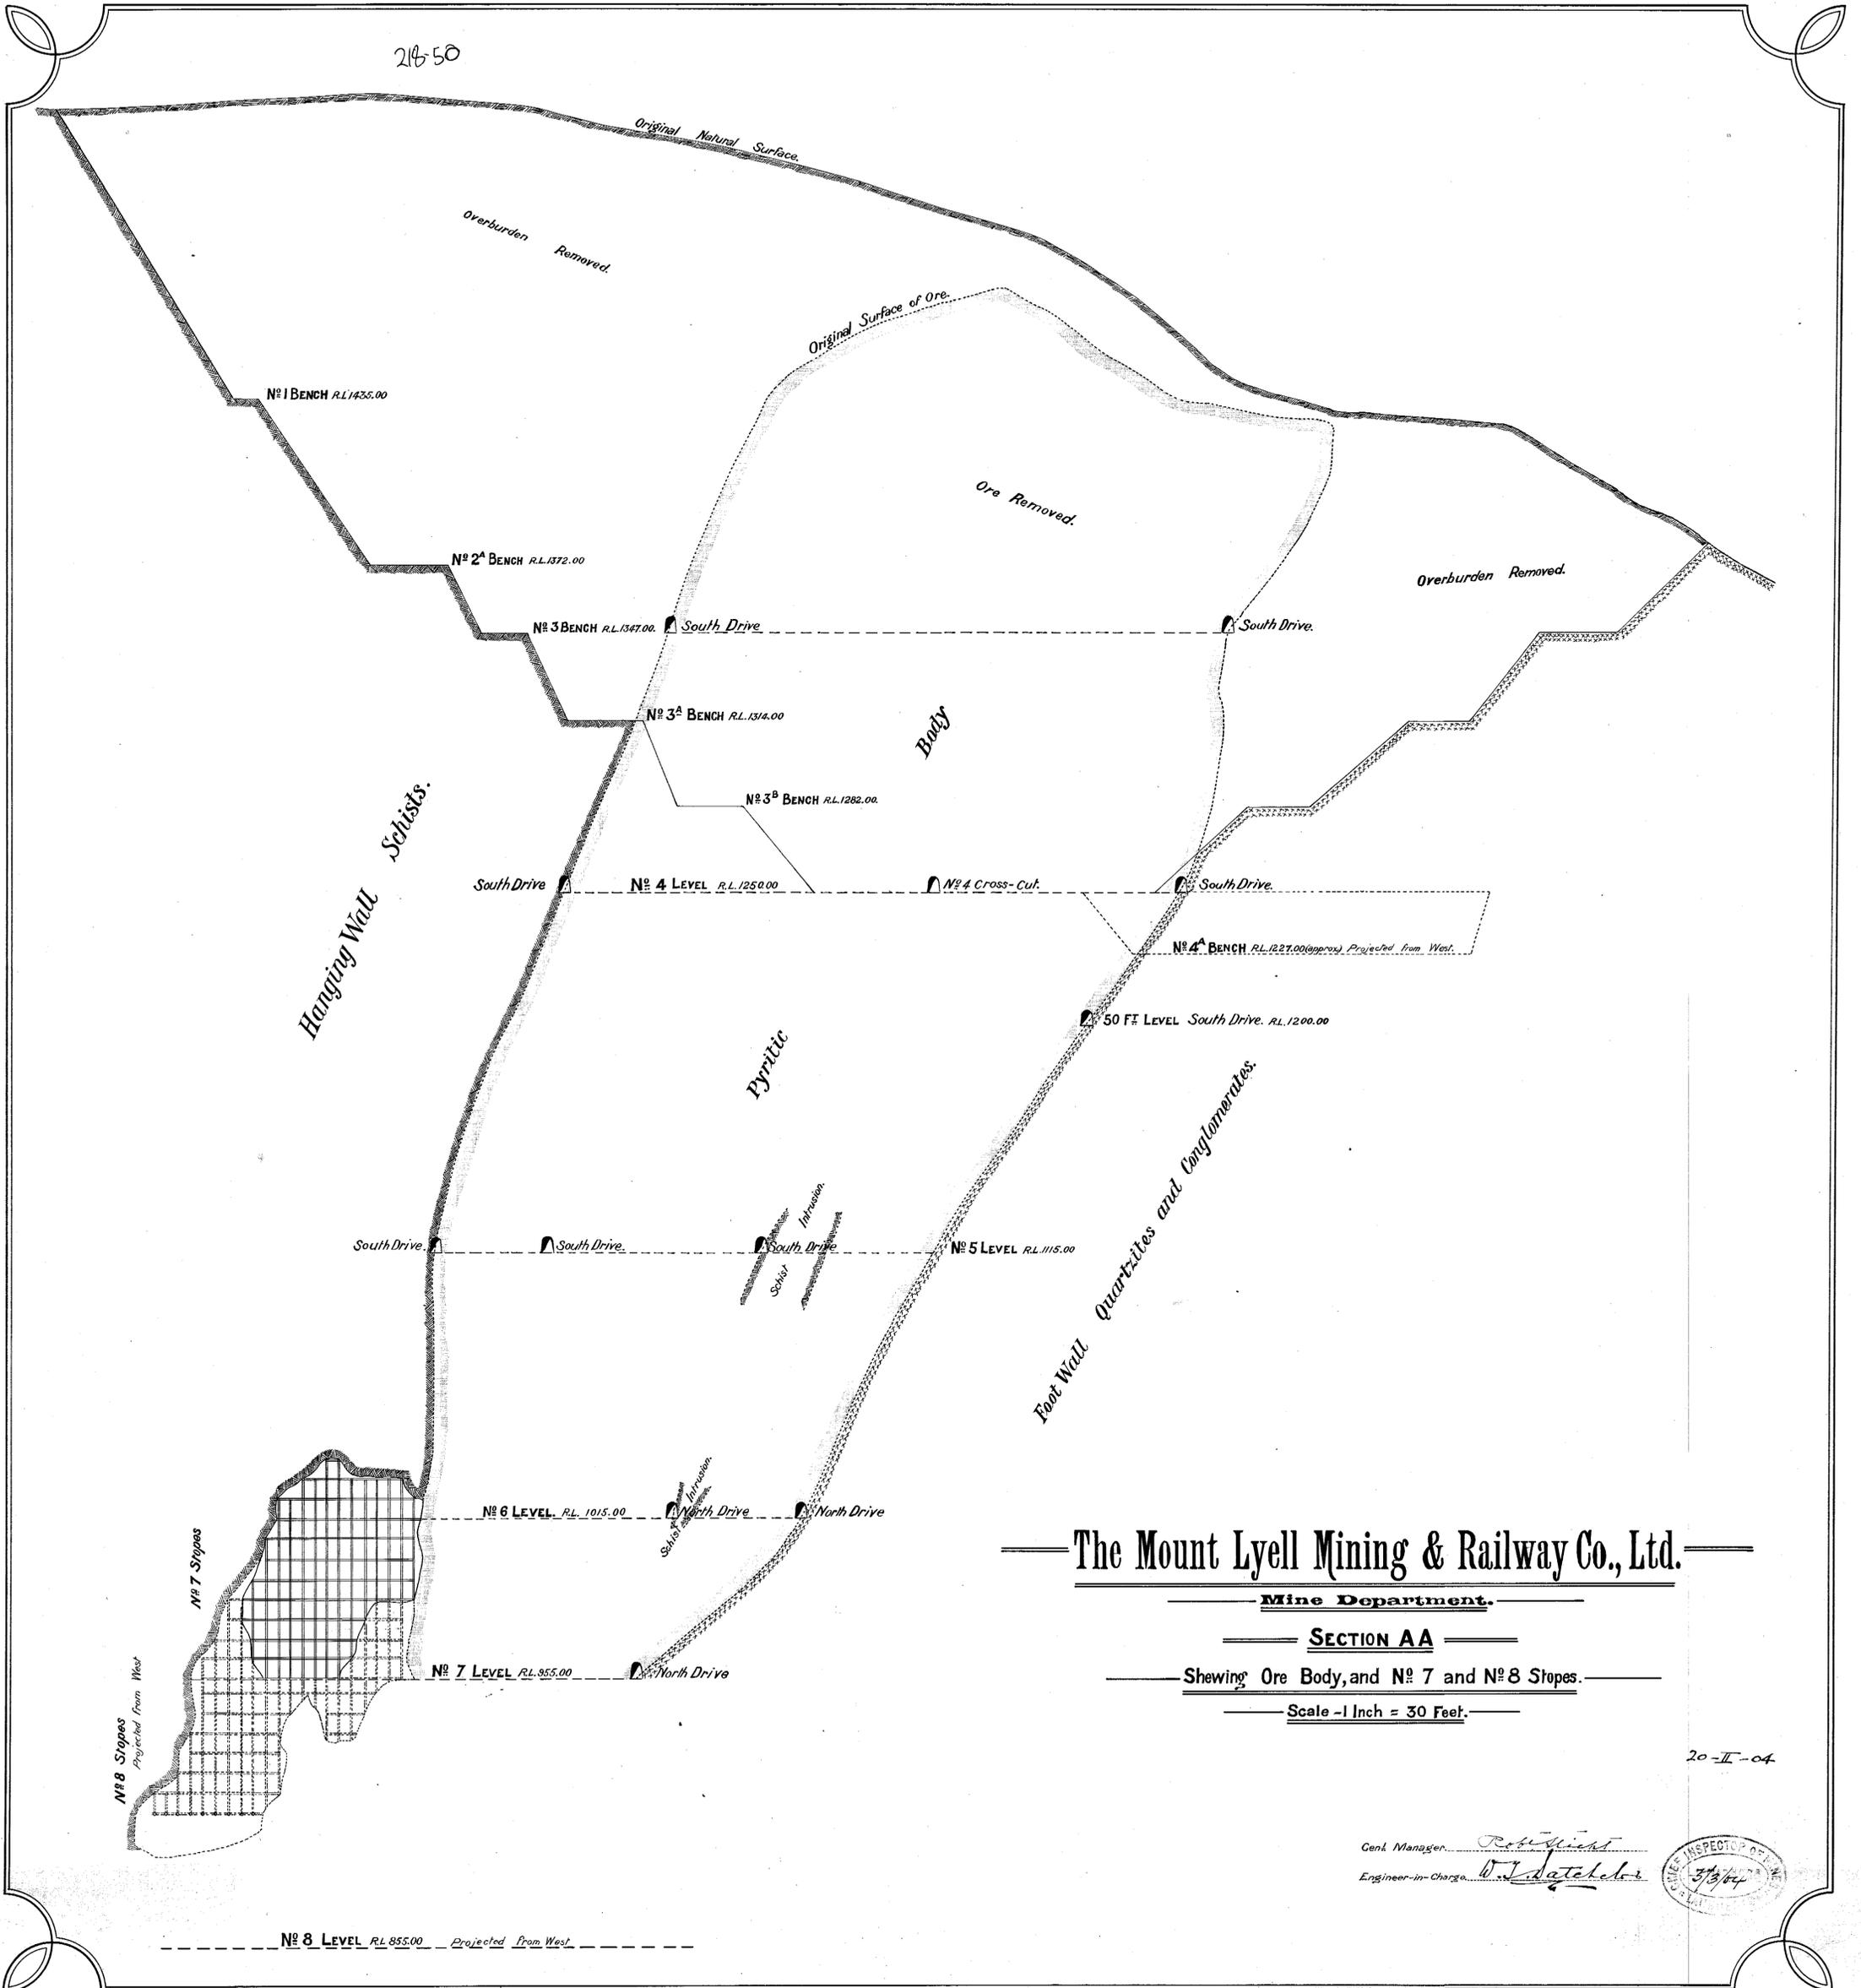

The Mount Lyell Mining & Railway Co., Ltd.

Mine Department.

SECTION AA

Showing Ore Body, and No 7 and No 8 Stopes.

Scale - 1 Inch = 30 Feet.

20-II-04

Genl. Manager Robinson
Engineer-in-Charge W. J. Datchler



No 8 LEVEL R.L. 855.00 Projected from West