

M<sup>Y</sup> LYELL M. AND R. CO. LTD.  
13  
86




KING LYELL

90  
92

M<sup>Y</sup> LYELL M. AND R. CO. LTD.  
20  
89

218-51

5 cm

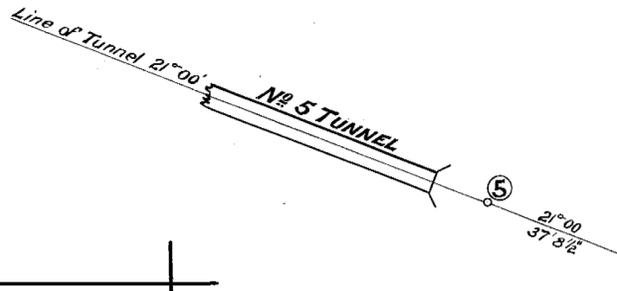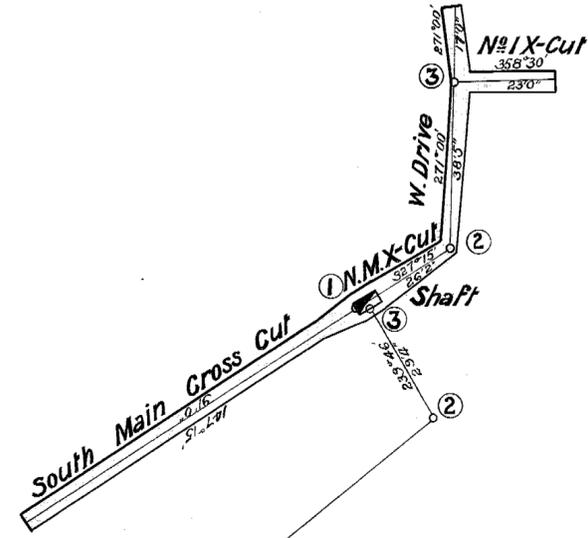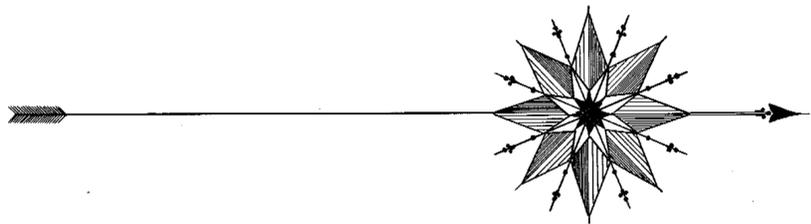

**The Mount Lyell Mining & Railway Co., Ltd.**

Mine Department.

PLAN OF

KING LYELL WORKINGS

SCALE 1" = 30'

Note. Compass traverse only of Underground Workings which were lost before Permanent Survey was made.

20-II-04



Genl. Manager *Robt. Duff*  
Engineer-in-Charge *W. J. Watcher*

218-51