
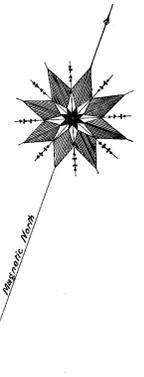


10001

WEST LYELL
293 M. 70a.

218-52

5 m

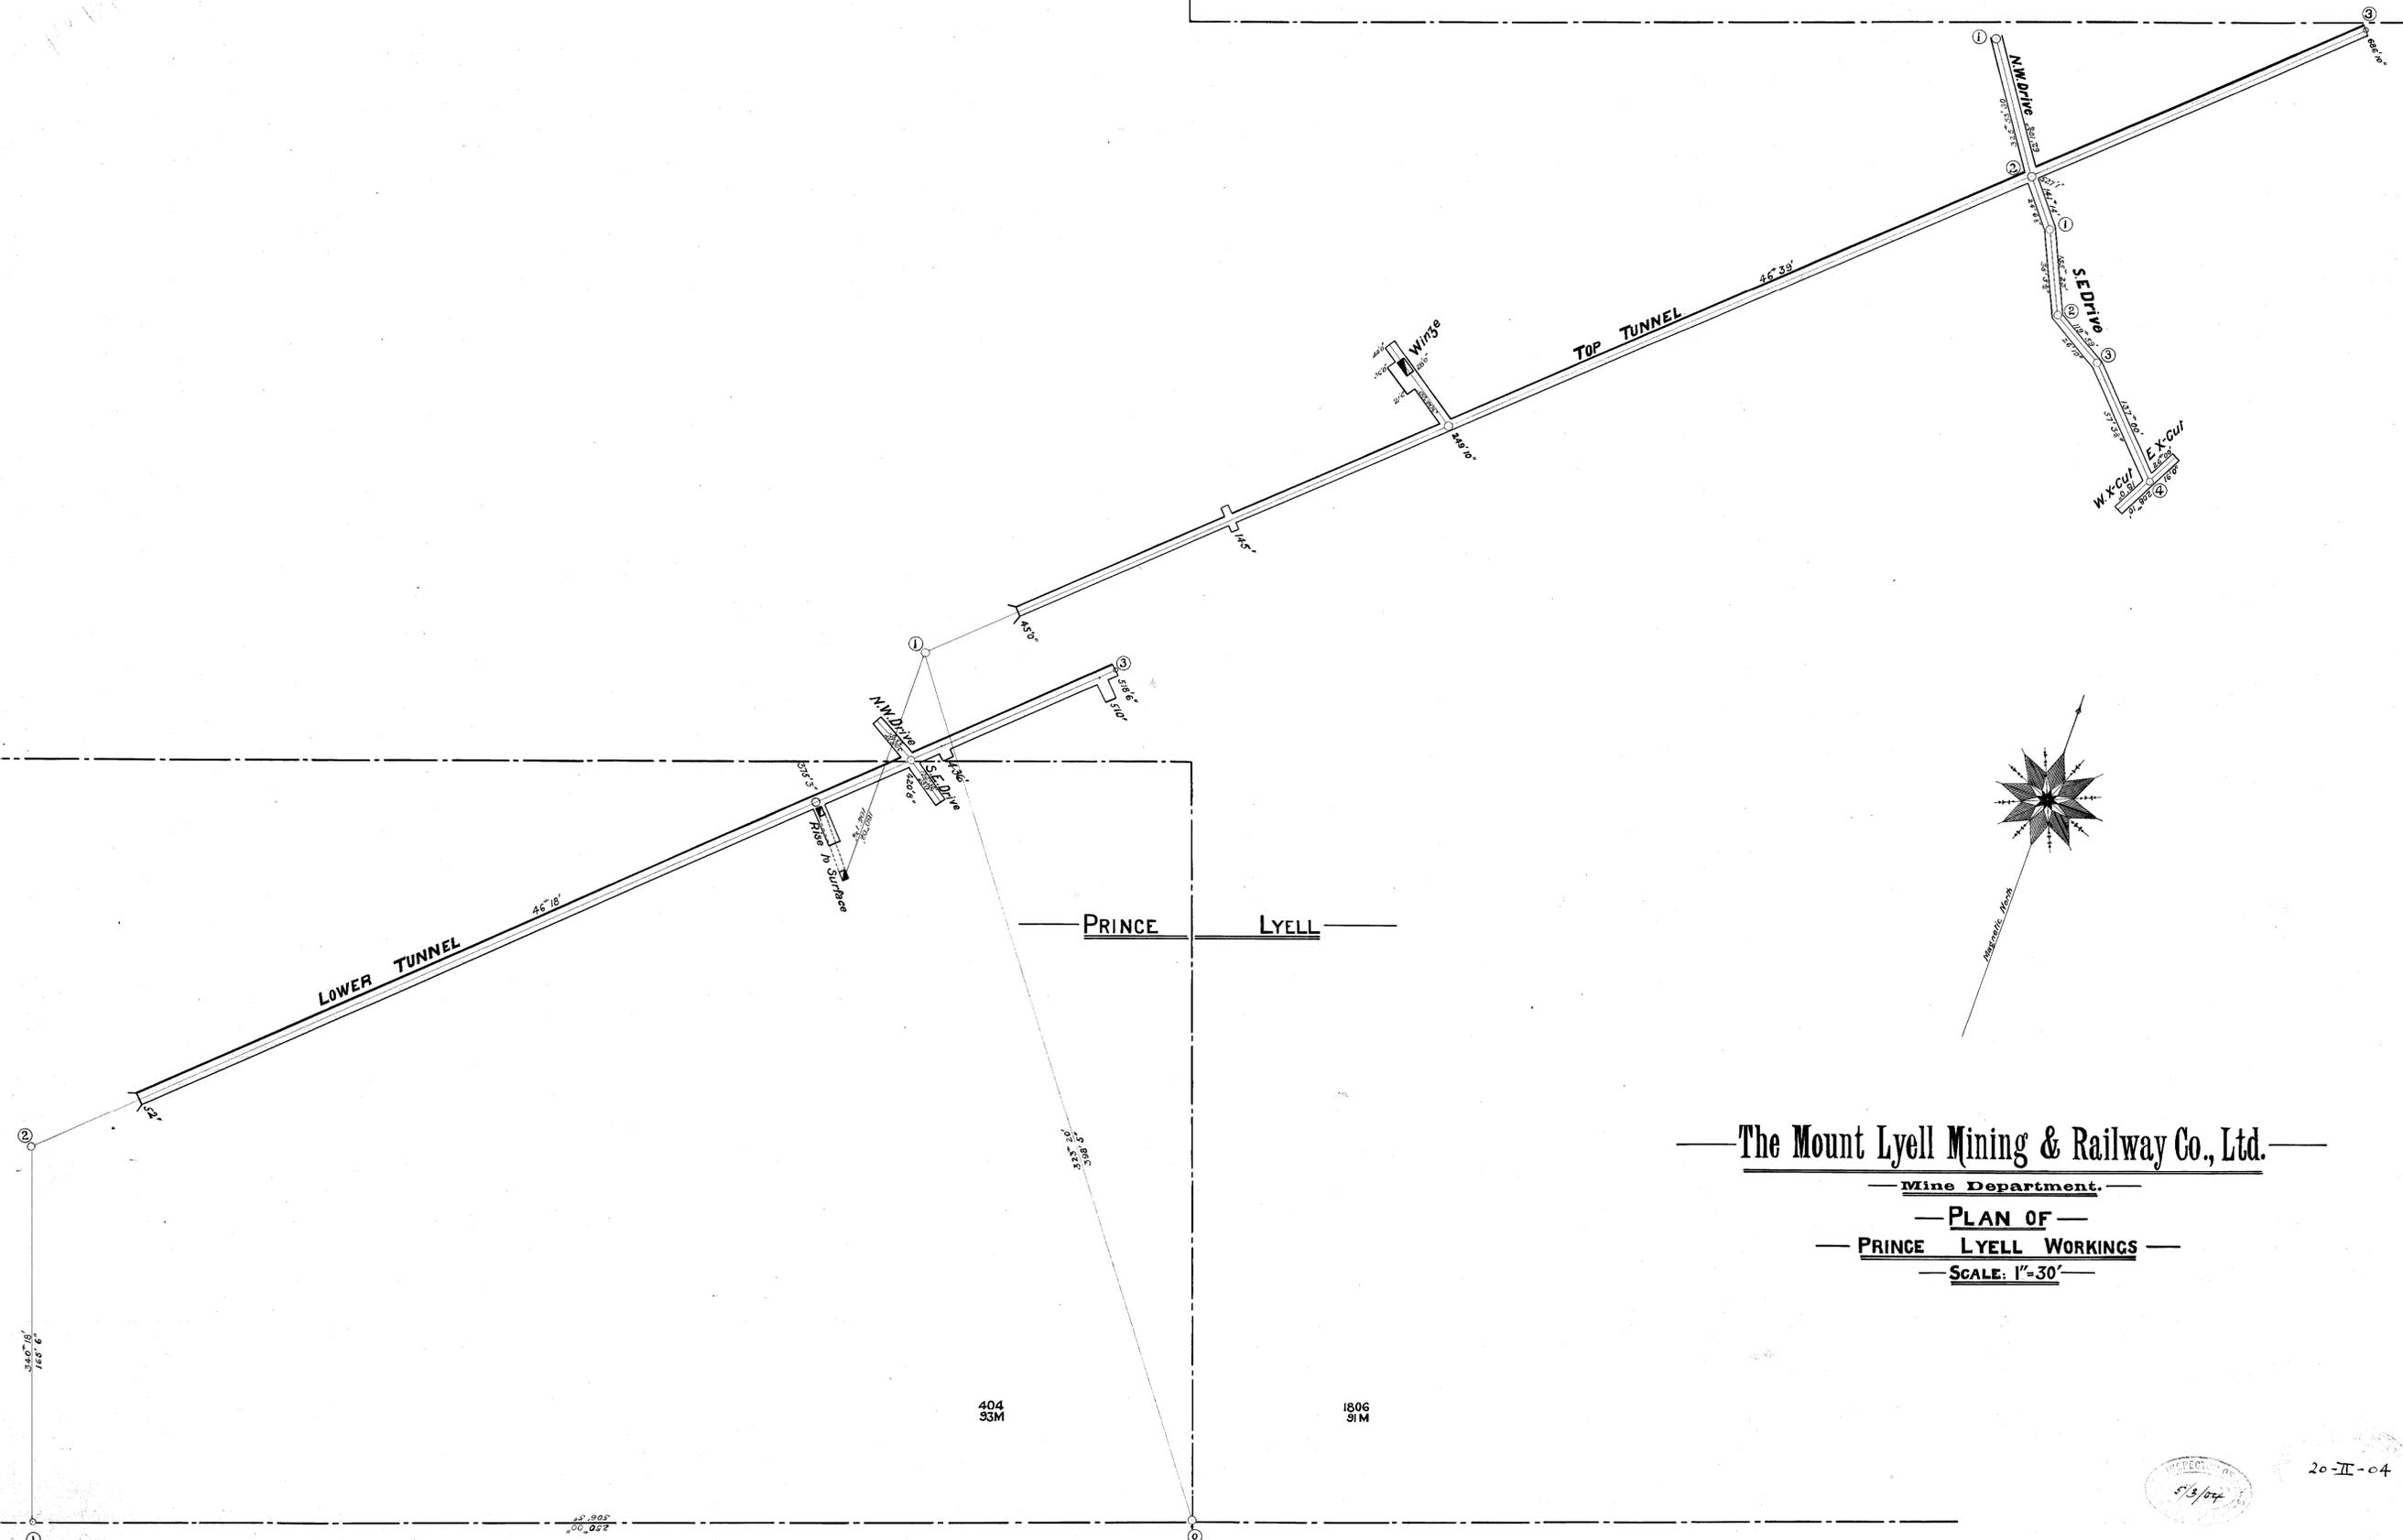

The Mount Lyell Mining & Railway Co., Ltd.

Mine Department.

PLAN OF
PRINCE LYELL WORKINGS

SCALE: 1"=30'

404
33M

1806
91M

THE MOUNT LYELL M. AND R. CO. LTD.

20
93

21
93



20-II-04

Genl Manager...
Engineer-in-Charge...
Roselliff
W. J. Hatchels

218-52