

218-53

J. P. Madden

604
93M





1857
31M

NTH. MT. LYELL CON. MIN. CO. N.L.

160° 00'
297° 5'

1959
35M

WESTERN THARSIS

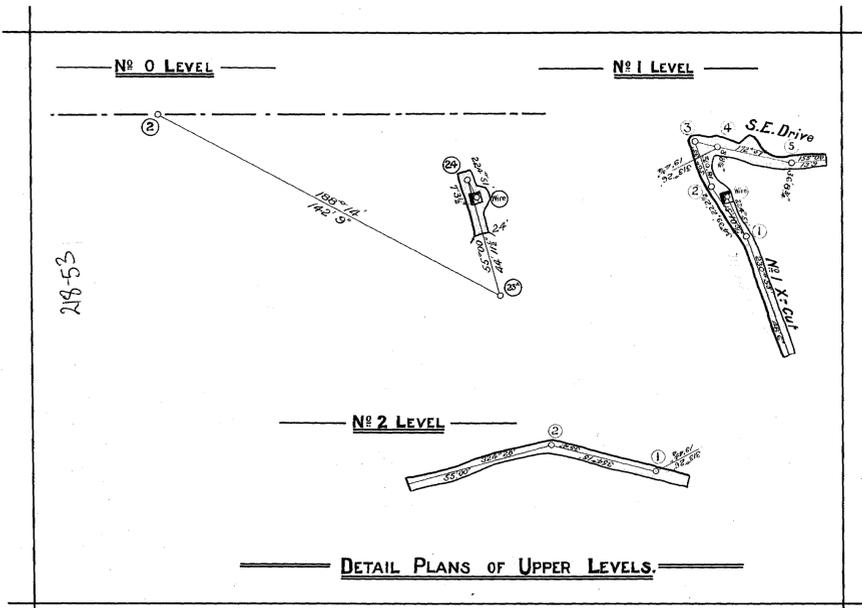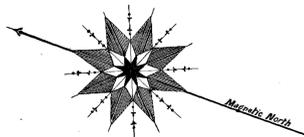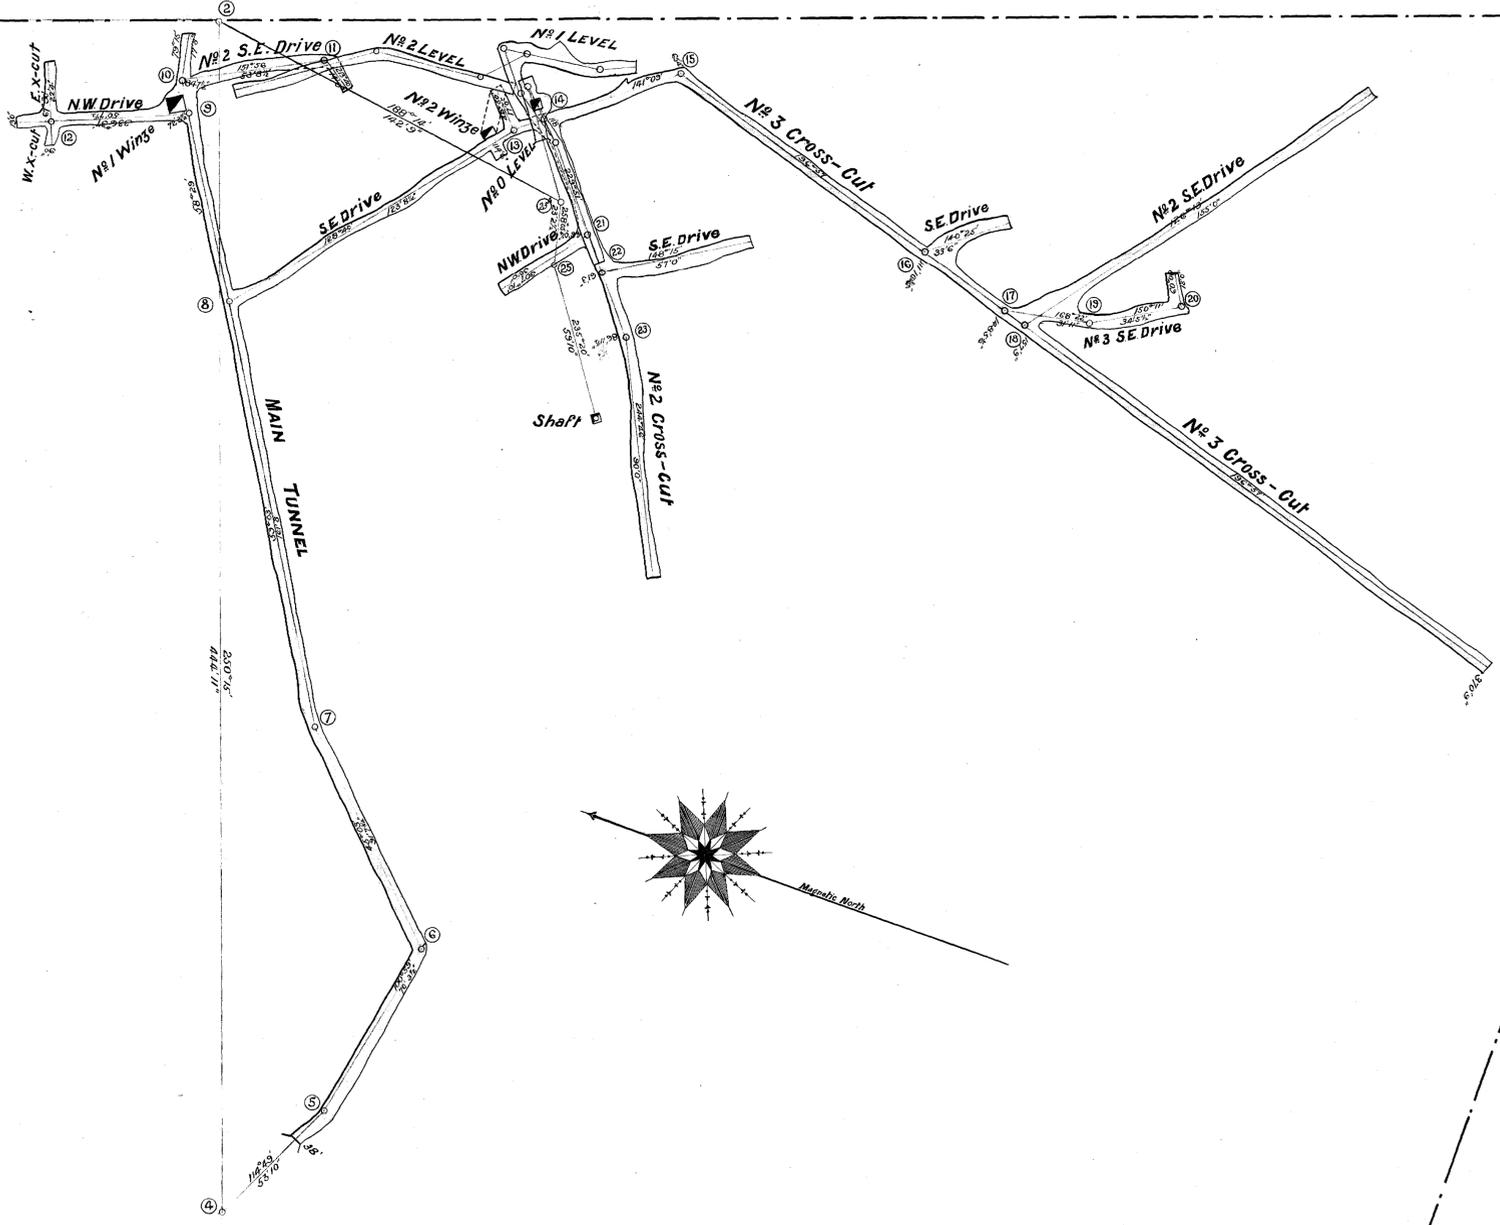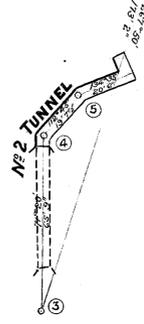

The Mount Lyell Mining & Railway Co., Ltd.

Mine Department.

PLAN OF

WESTERN THARSIS WORKINGS

SCALE: 1" = 30'



20-II-04

Genl. Manager *Robt. Stirling*
 Engineer-in-Charge *W. J. Hutchins*

5 cm