


218-56

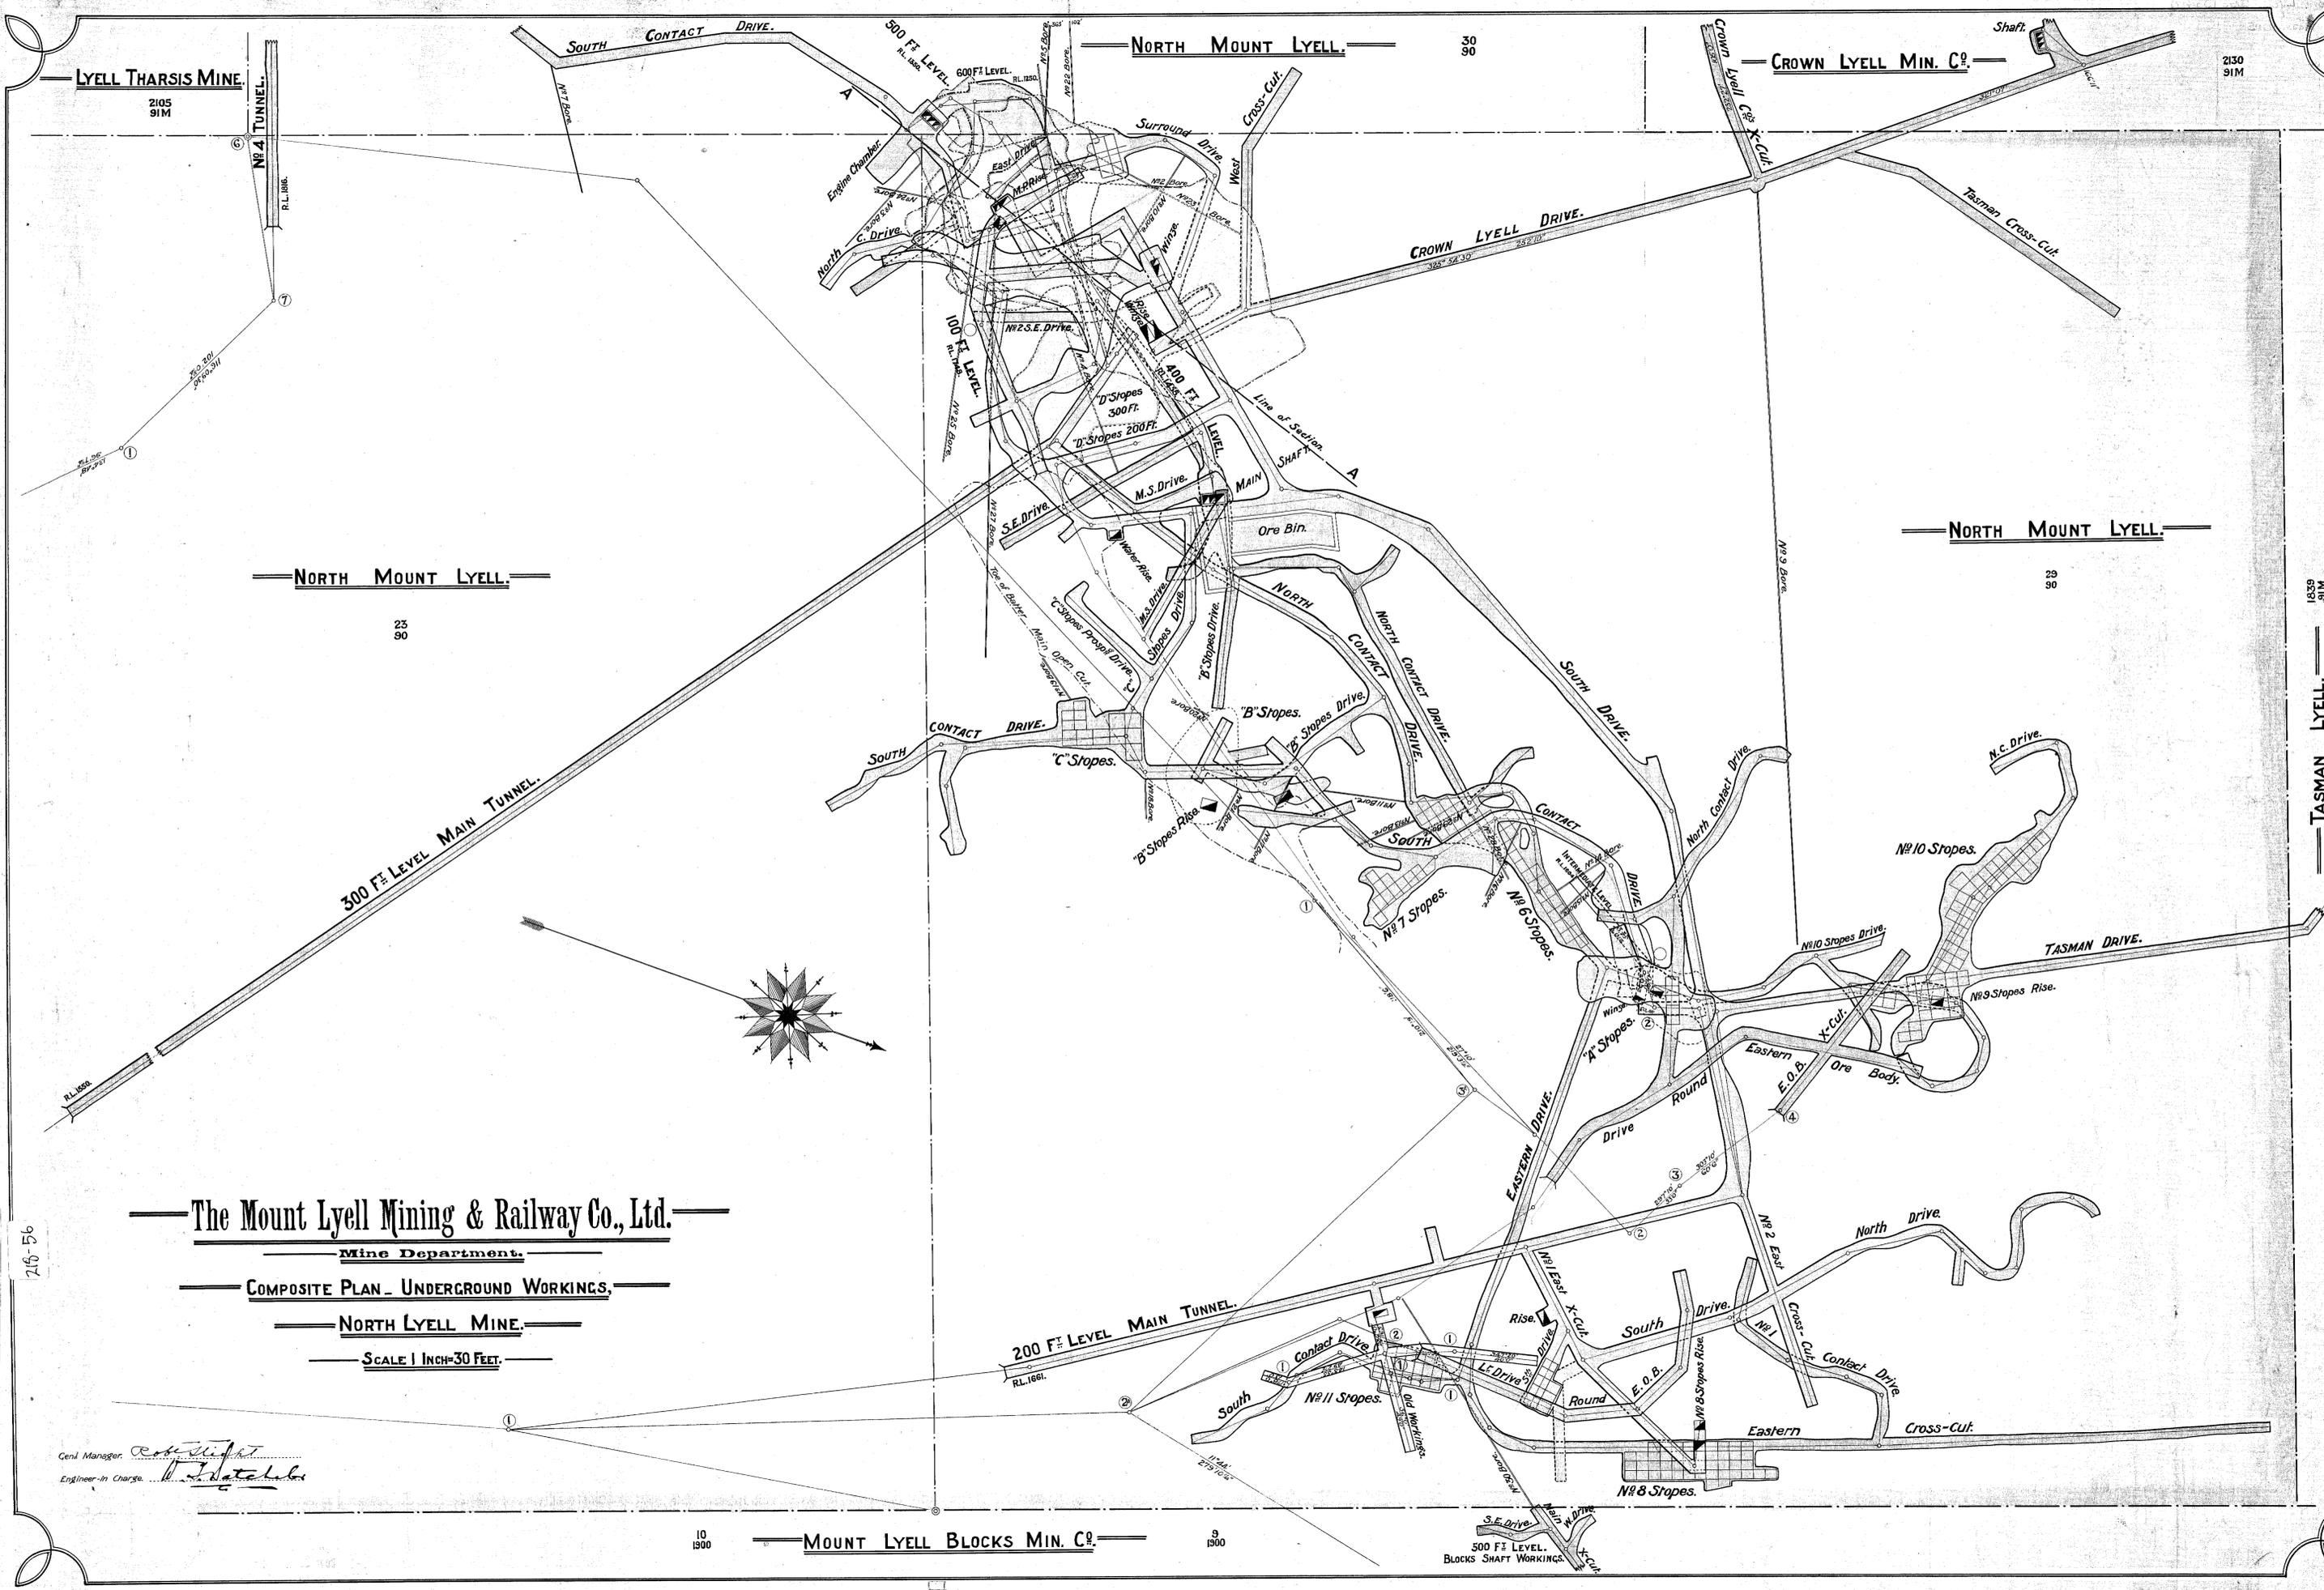

NORTH MOUNT LYELL.

23  
90

NORTH MOUNT LYELL.

30  
90

CROWN LYELL MIN. CO.

2130  
91M

NORTH MOUNT LYELL.

29  
90

1859  
91M

TASMAN LYELL.

The Mount Lyell Mining & Railway Co., Ltd.

Mine Department.

COMPOSITE PLAN - UNDERGROUND WORKINGS.

NORTH LYELL MINE.


SCALE 1 INCH=30 FEET.

MOUNT LYELL BLOCKS MIN. CO.

10  
1900

9  
1900

500 F. LEVEL.  
BLOCKS SHAFT WORKINGS.

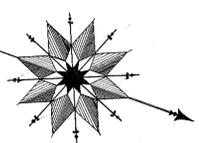

Genl. Manager *Robert Light*  
 Engineer-in-Charge *W. H. H. H.*

218-56

5 cm

133