


5 cm

218-57

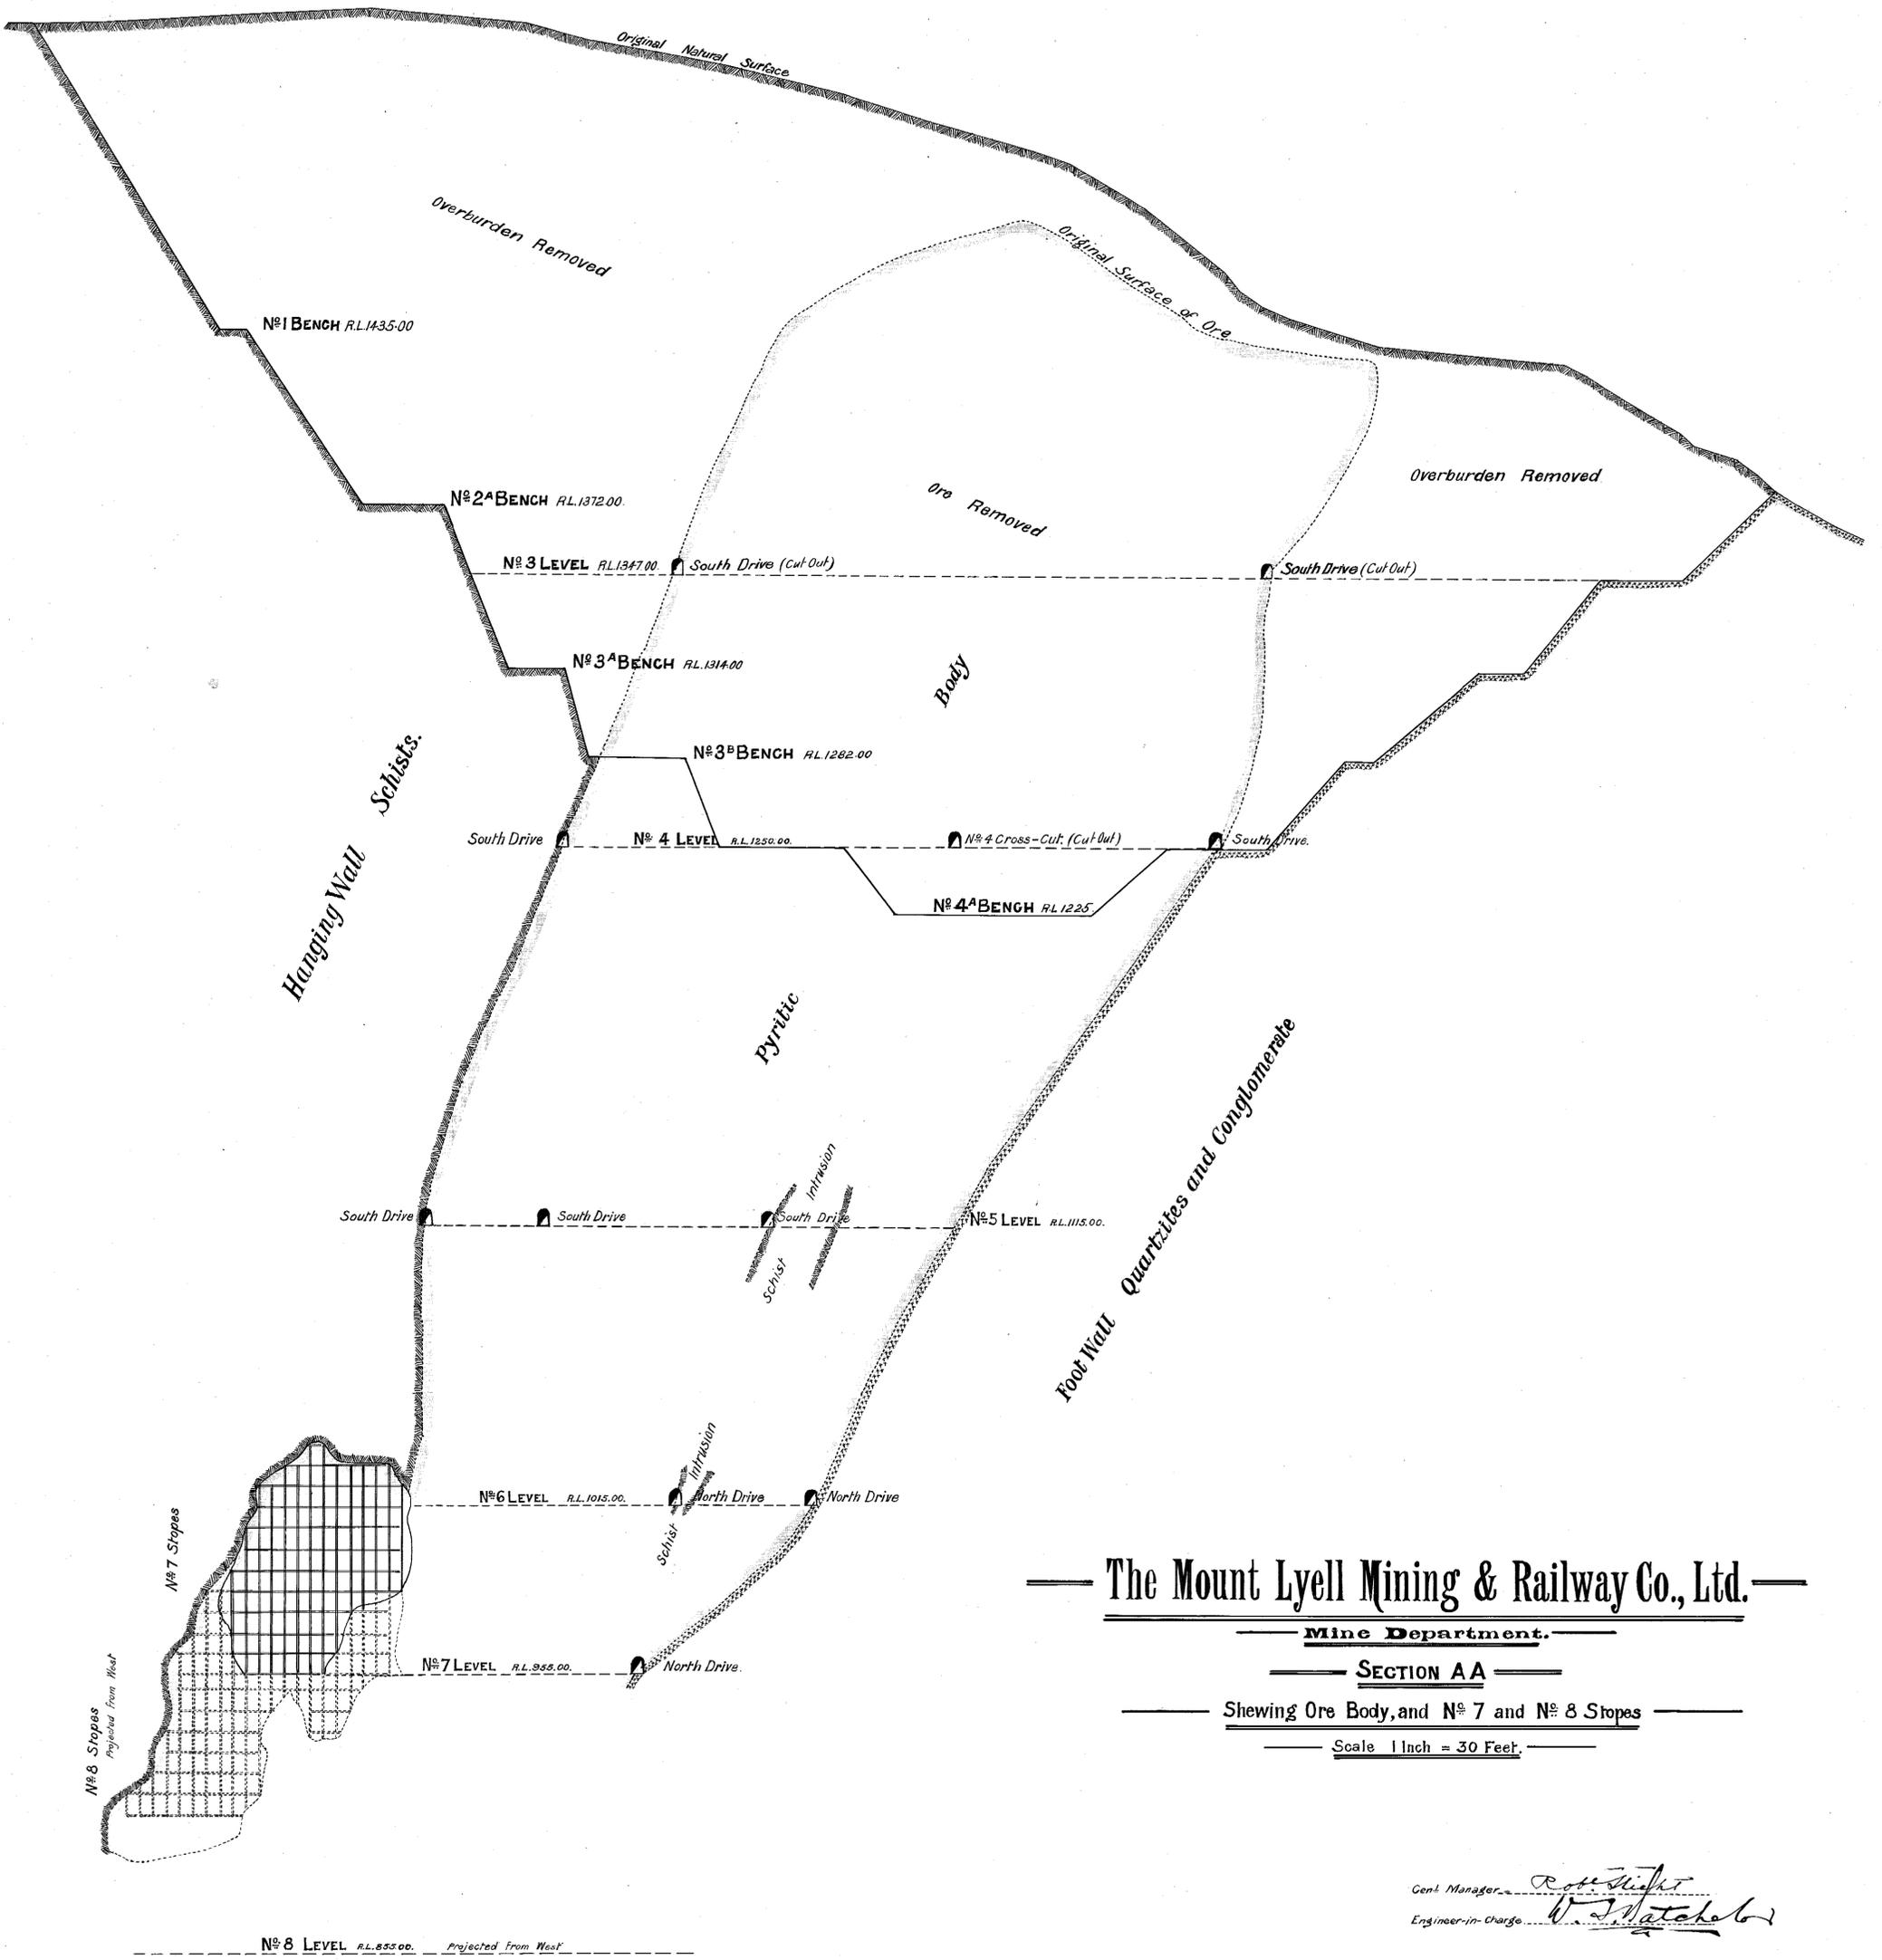

**The Mount Lyell Mining & Railway Co., Ltd.**  
 — Mine Department. —  
 — SECTION AA —  
 — Shewing Ore Body, and N° 7 and N° 8 Stopes —  
 — Scale 1 Inch = 30 Feet. —

Genl. Manager *R. J. ...*  
 Engineer-in-Charge *W. J. Watake*