


5 cm

218-59

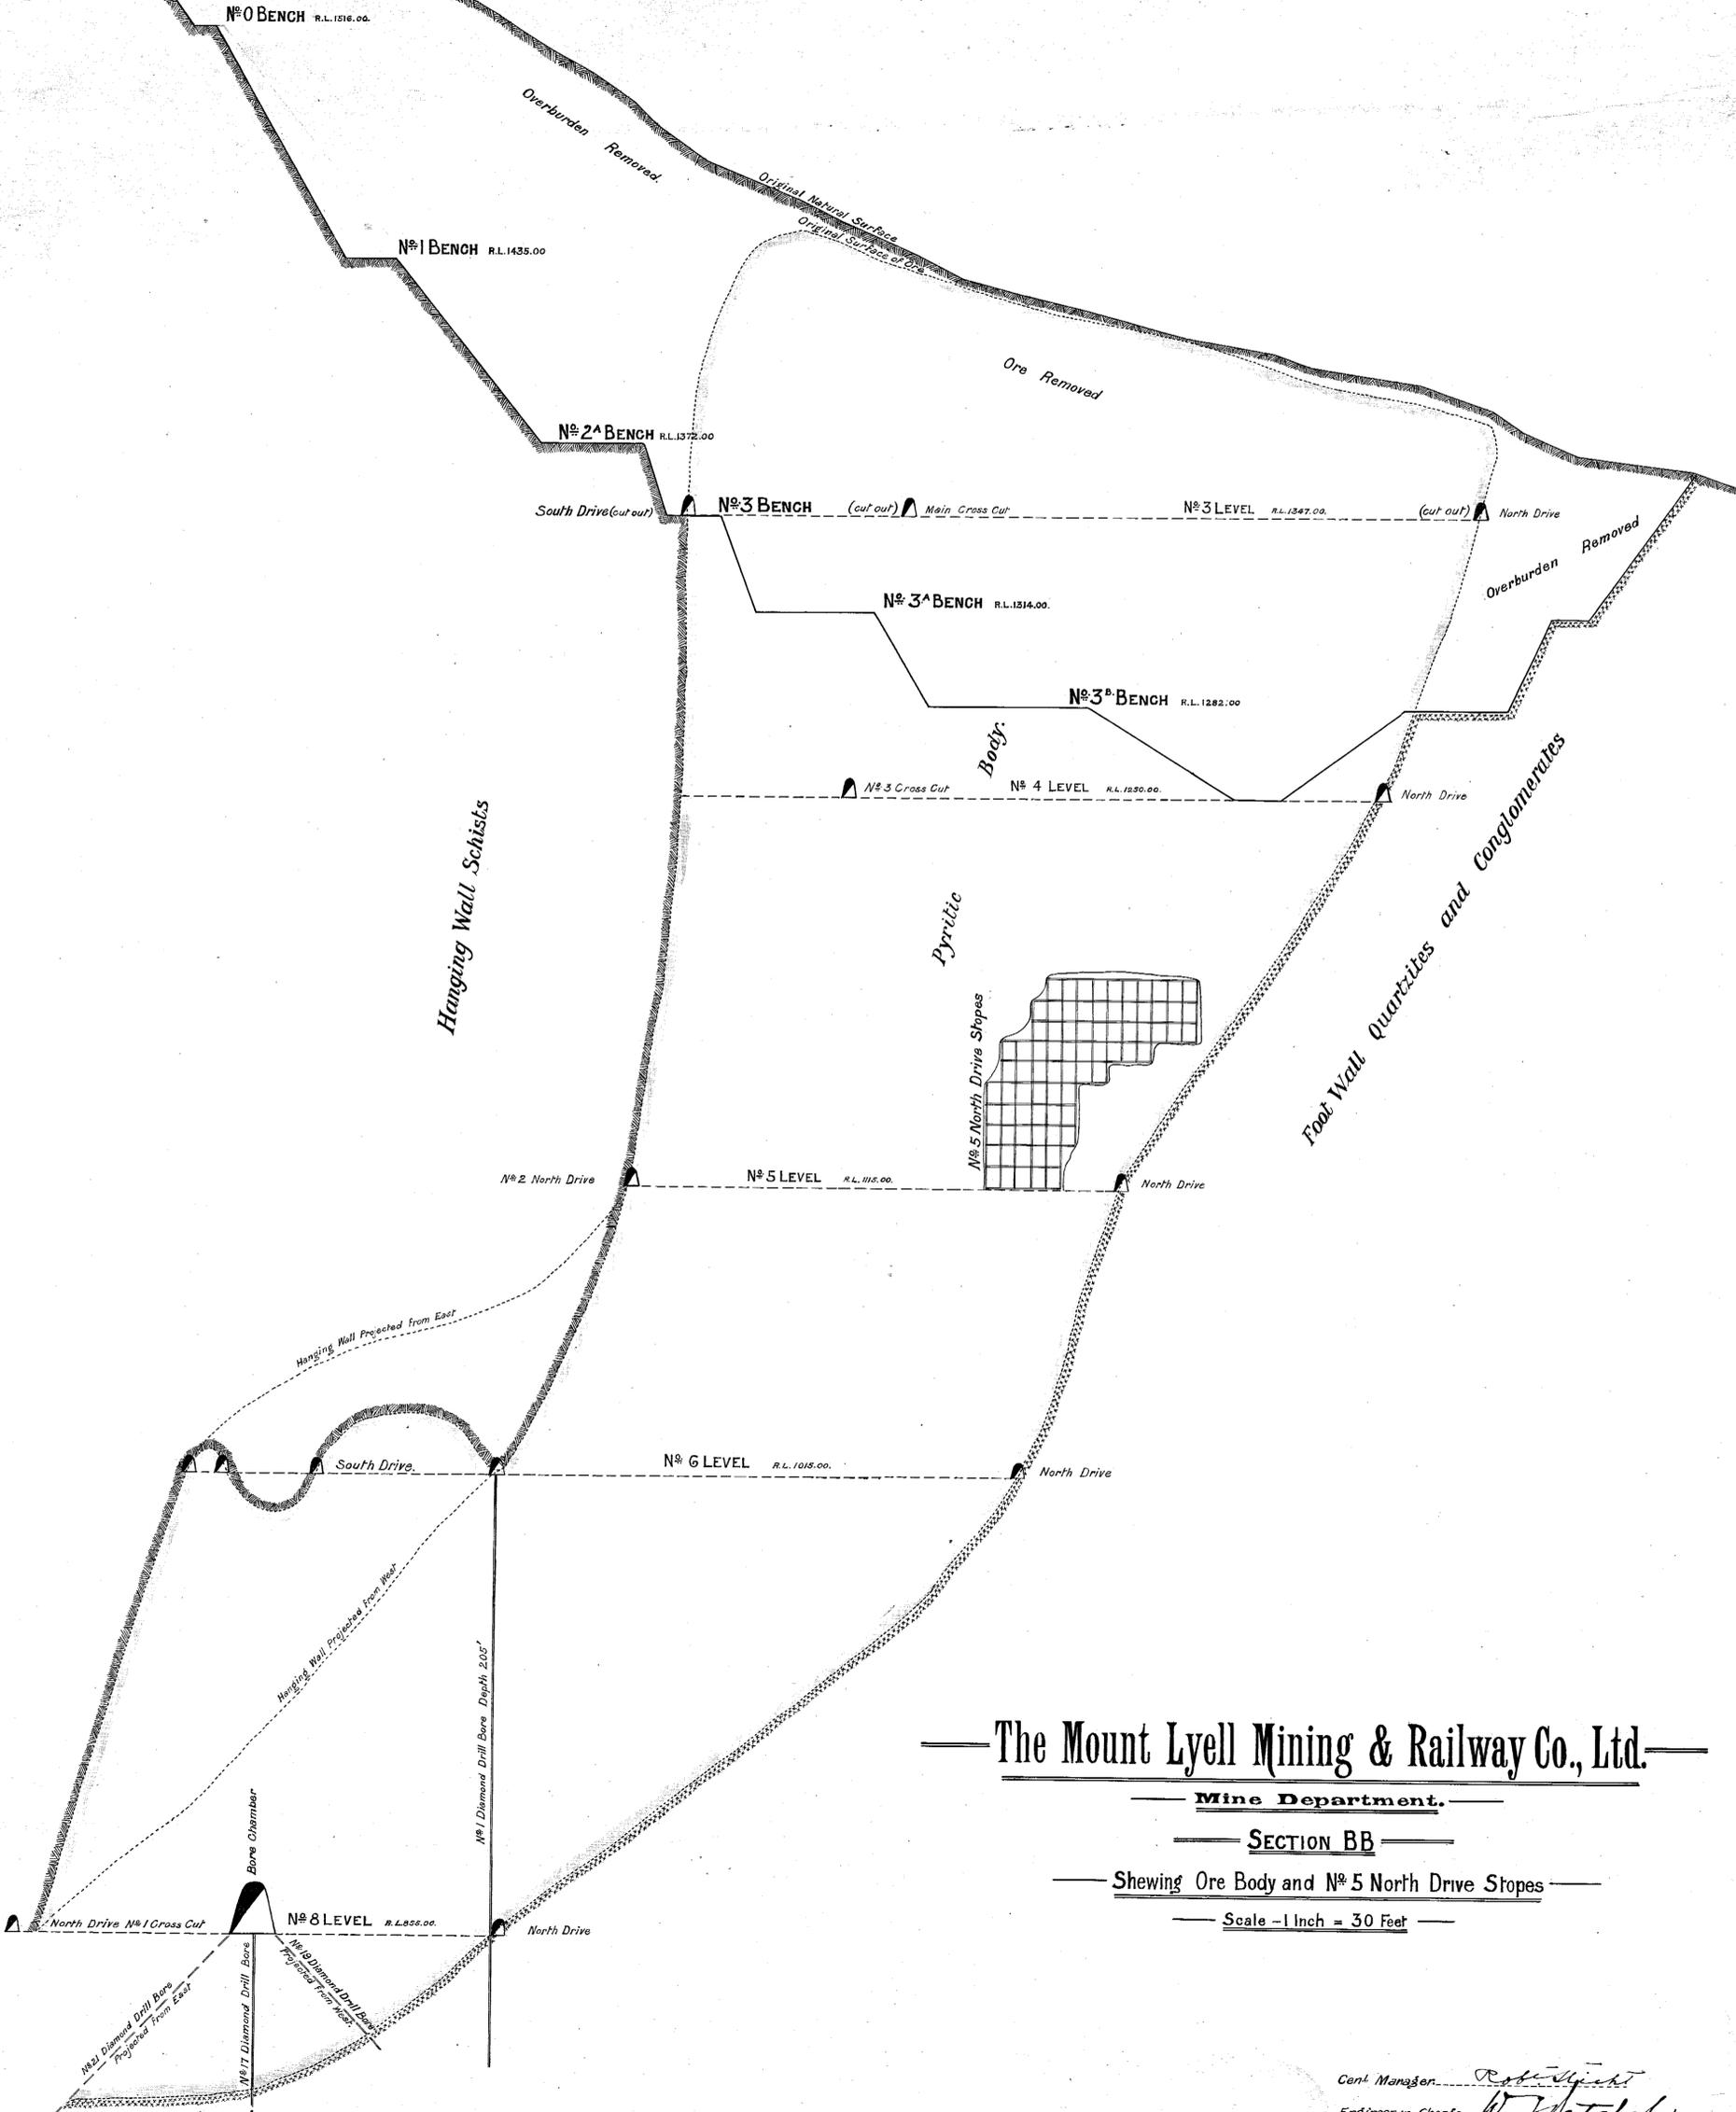

The Mount Lyell Mining & Railway Co., Ltd.

Mine Department.

SECTION BB

Showing Ore Body and N°5 North Drive Stopes

Scale - 1 Inch = 30 Feet

Cent. Manager *Robt. Lyell*
Engineer-in-Charge *W. J. Hatcher*