
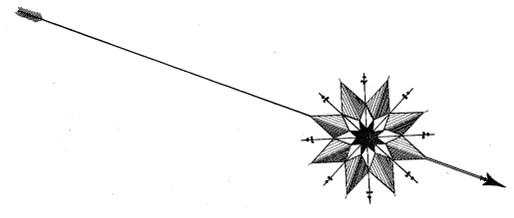
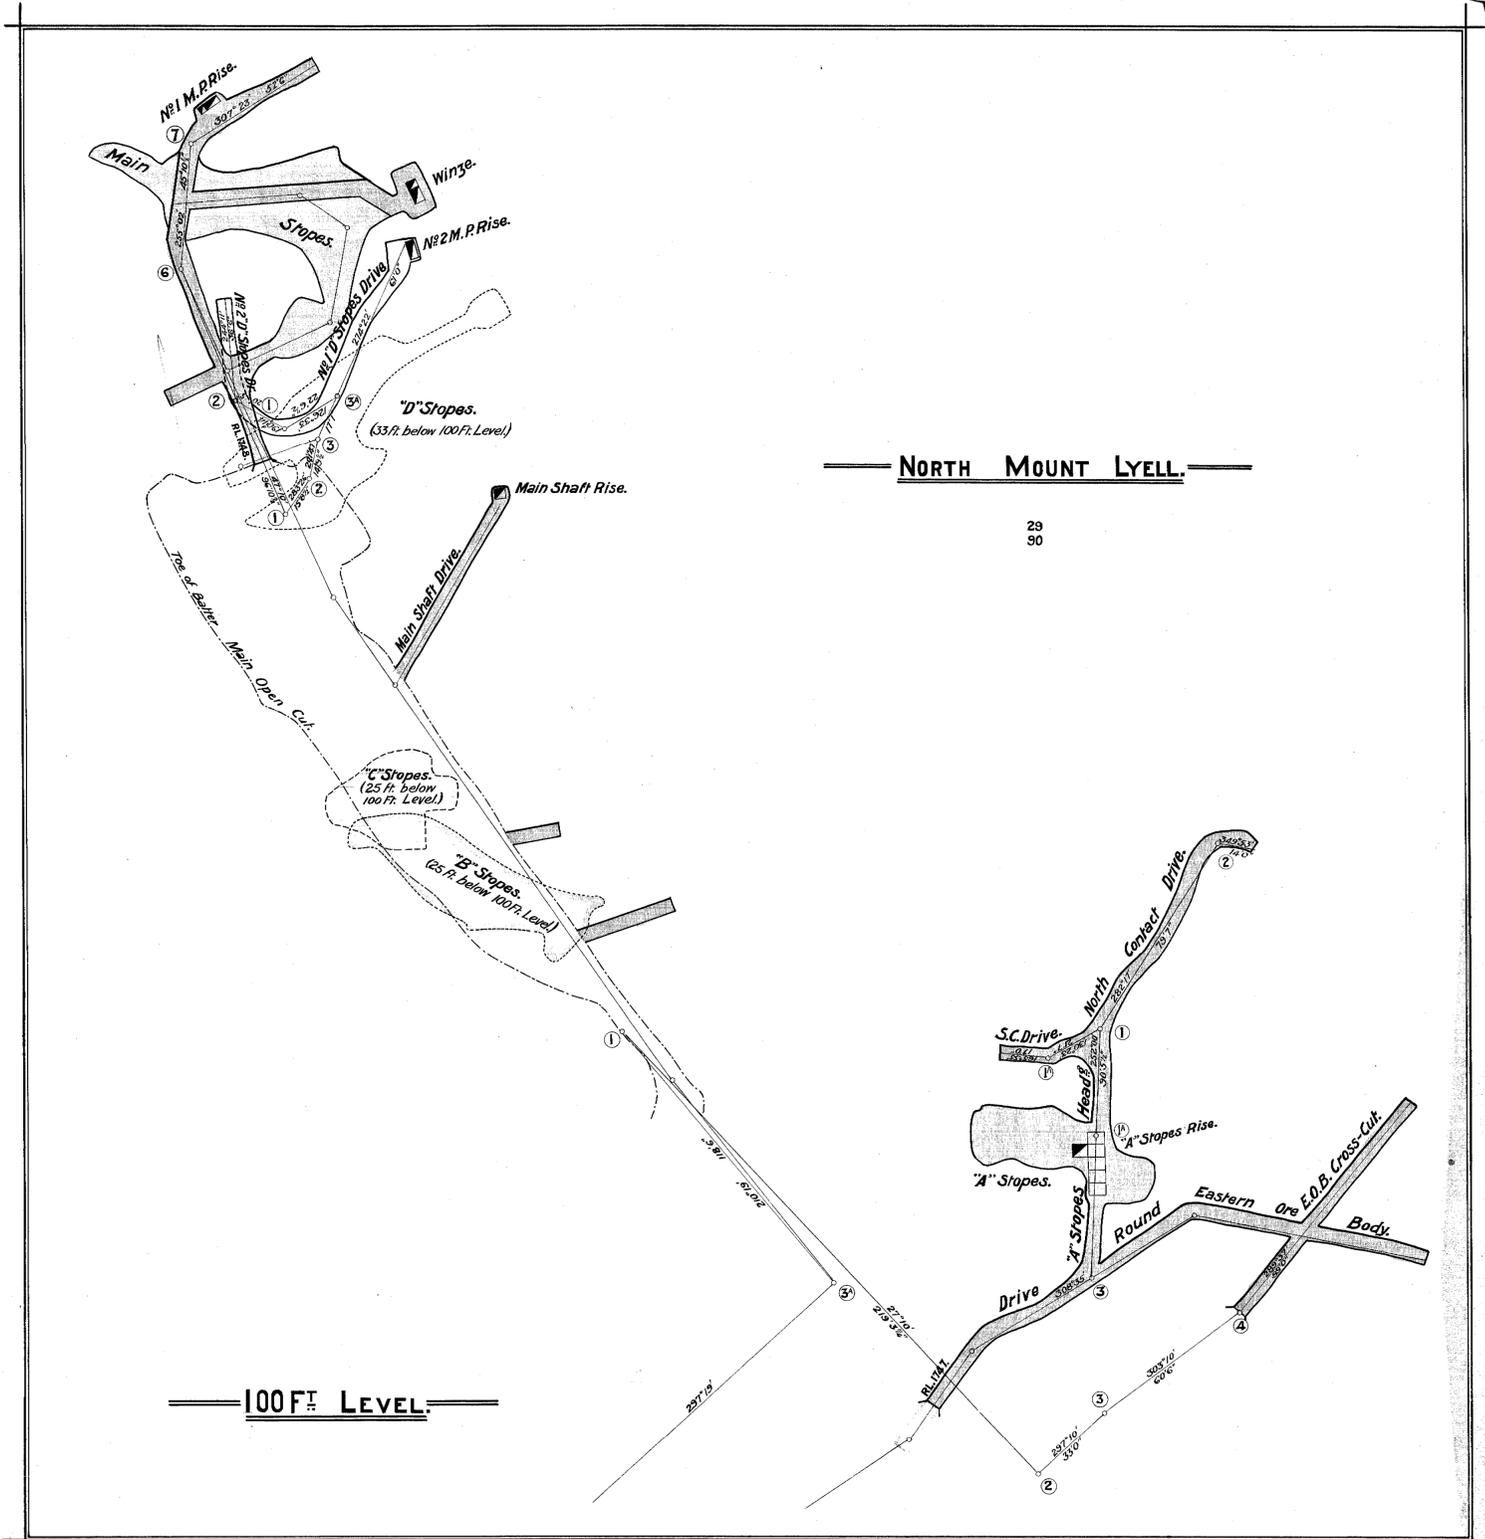
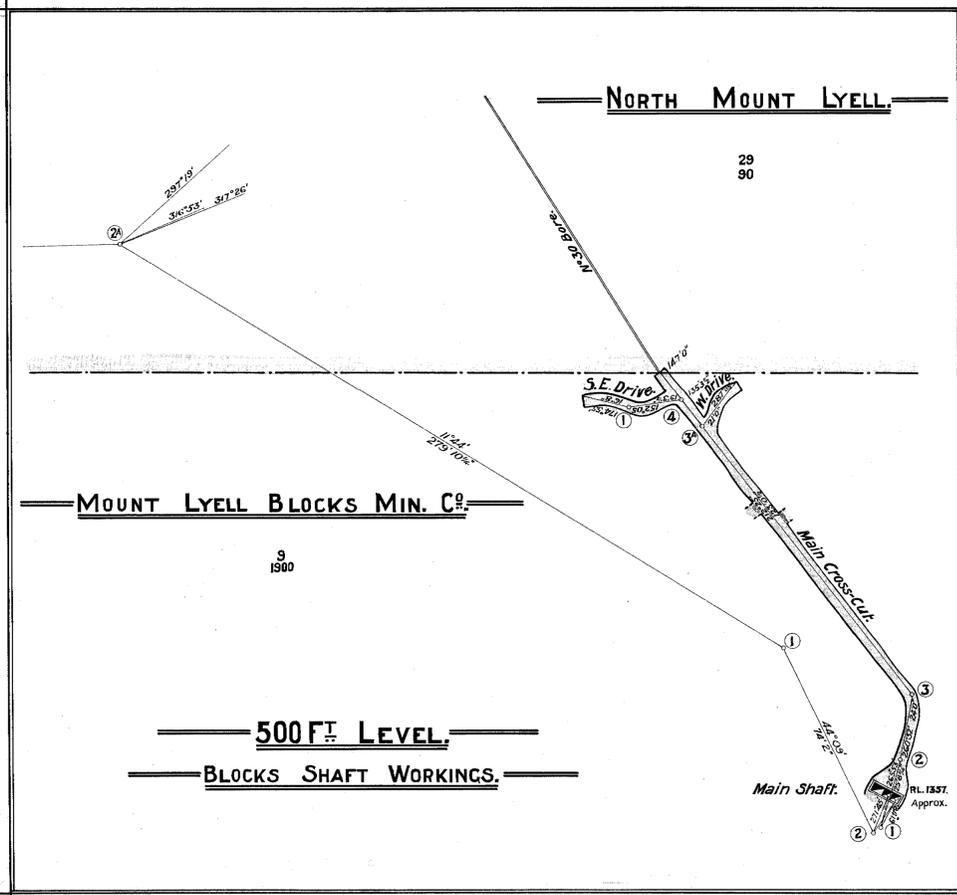


218-60

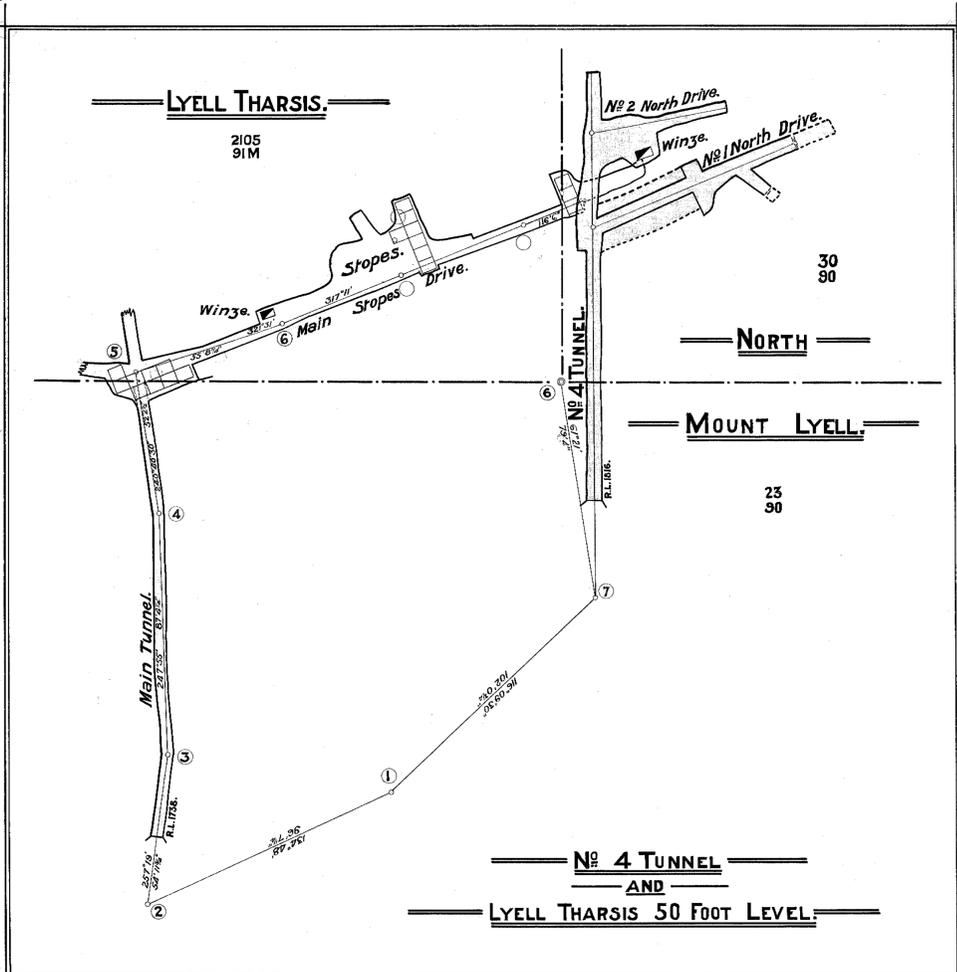

The Mount Lyell Mining & Railway Co., Ltd.

Mine Department.

DETAIL PLAN, UNDERGROUND WORKINGS.

NORTH LYELL MINE.

SCALE 1 INCH=30 FEET.

Genl. Manager. *R. H. King*

Engineer in Charge. *H. J. Watales*

5 cm

216-60