


218-62

218-62

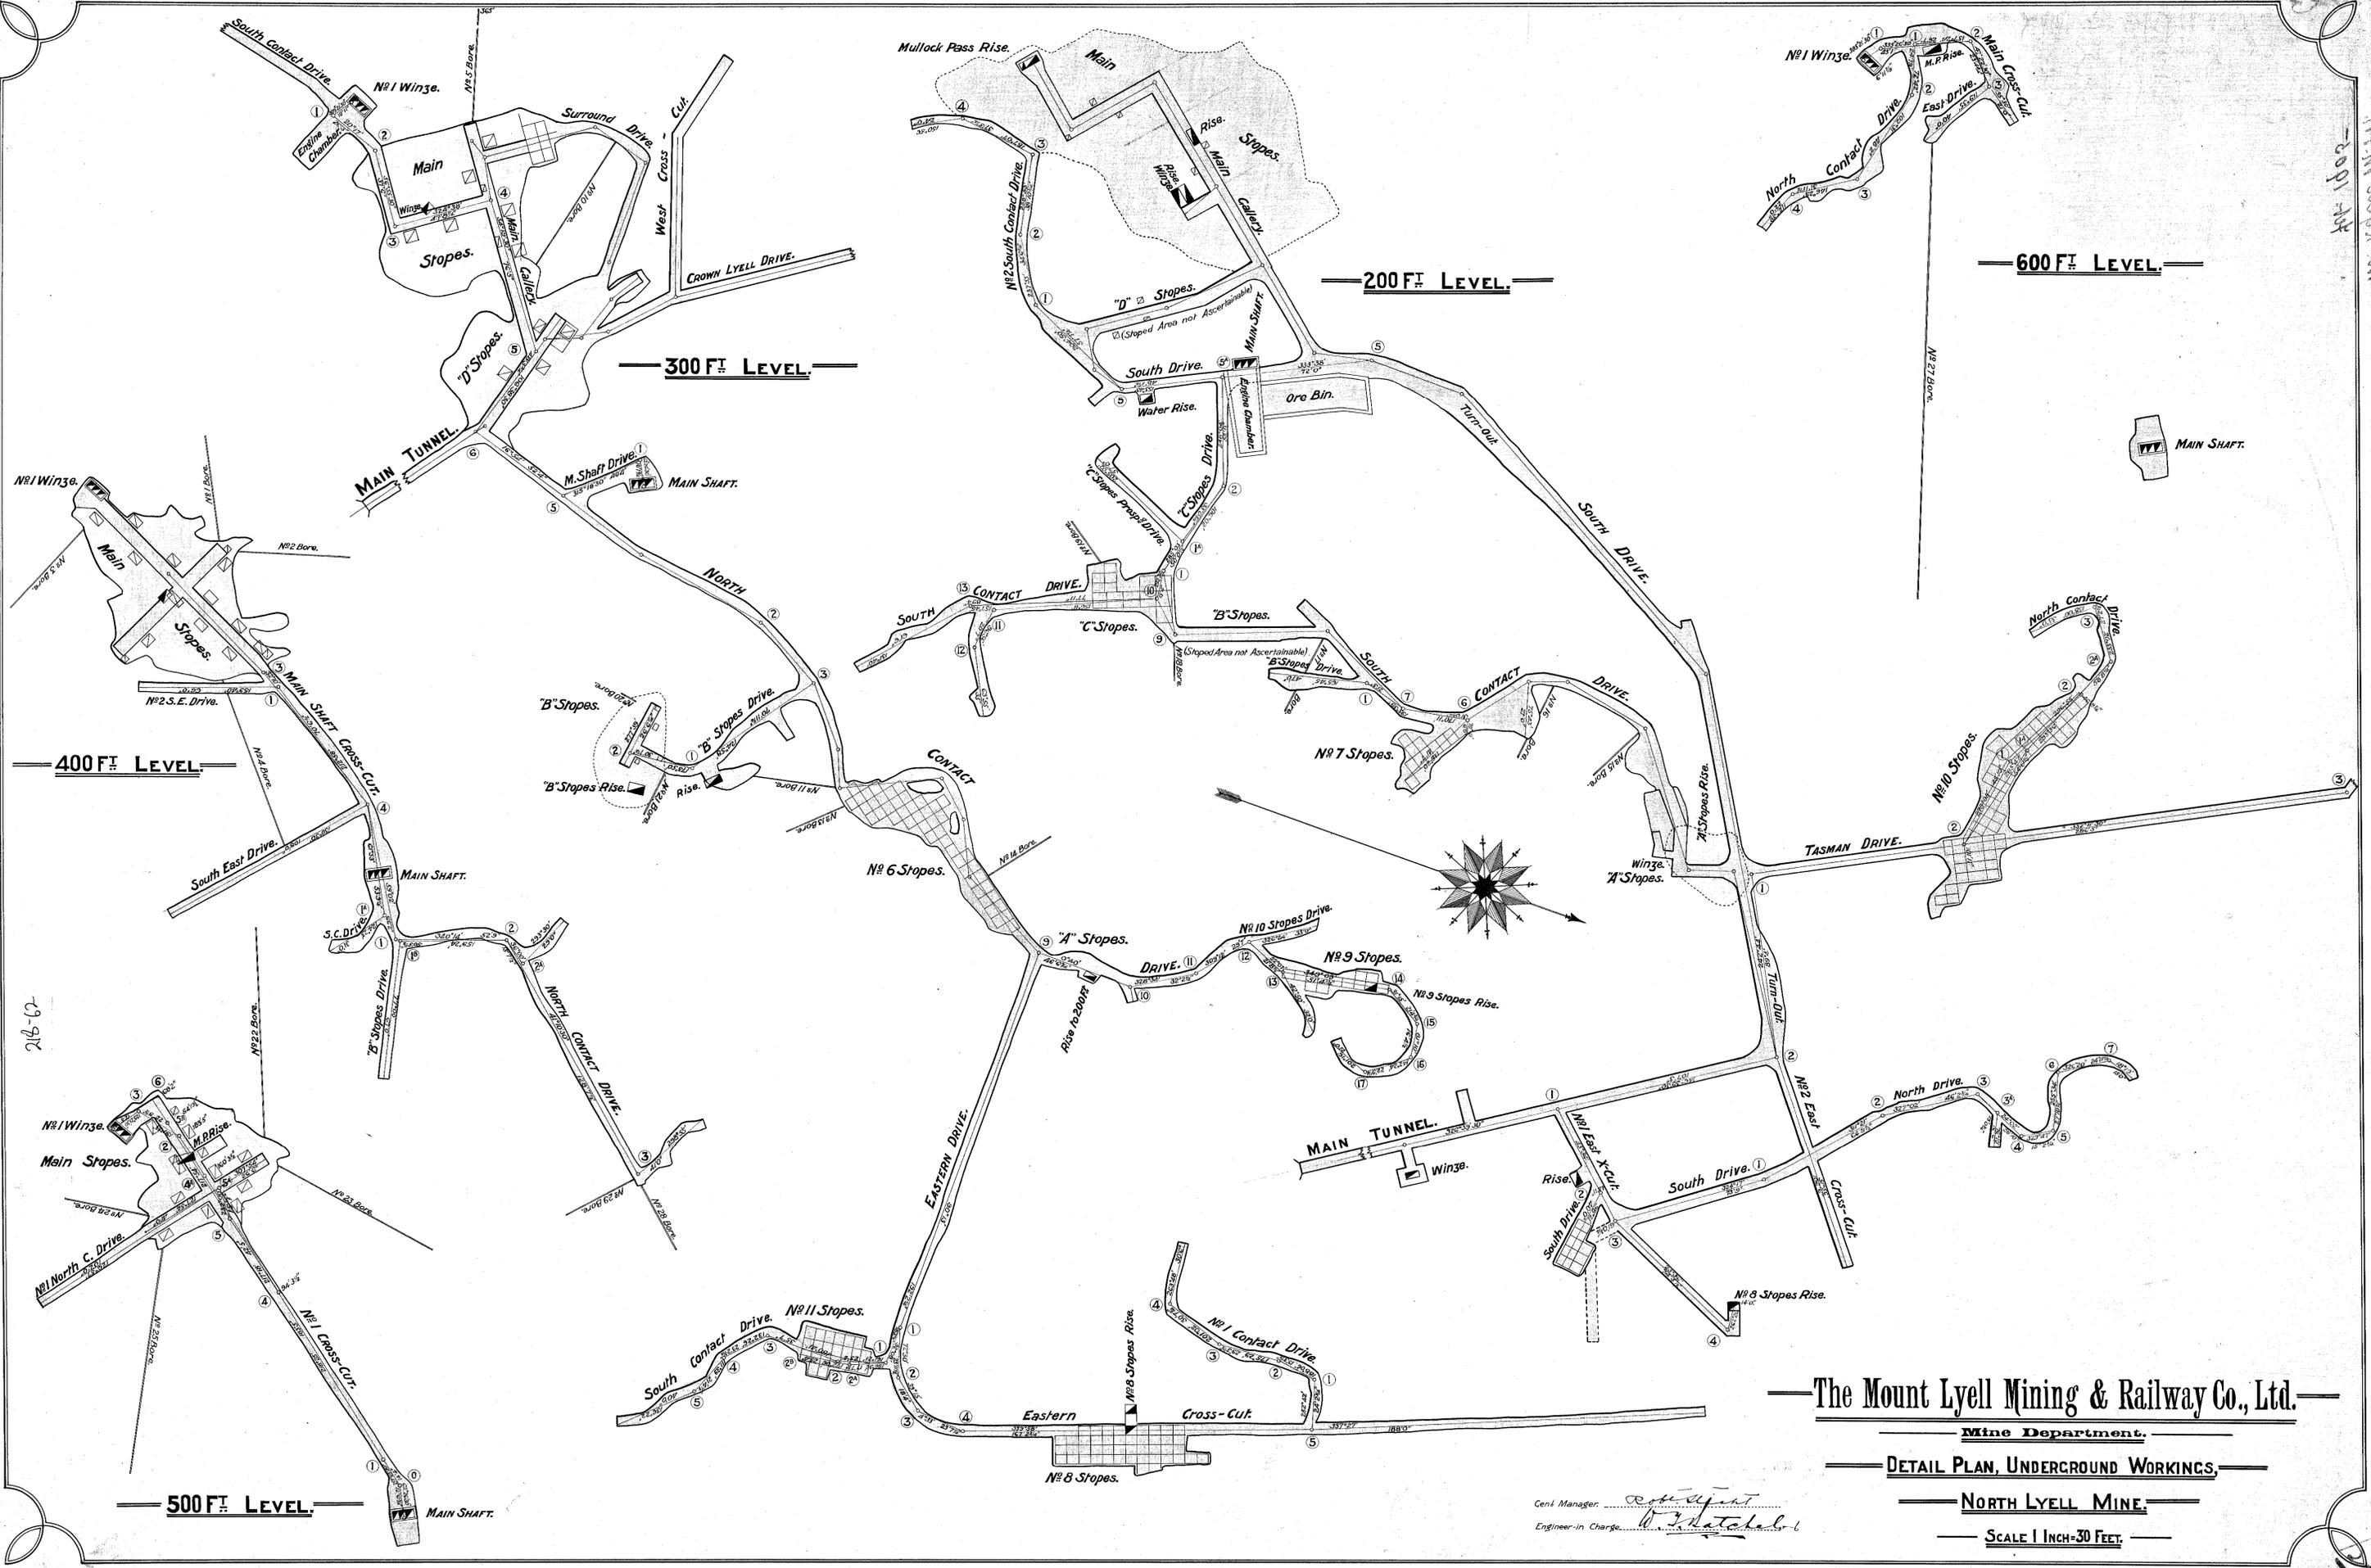

218-62

5 cm

—The Mount Lyell Mining & Railway Co., Ltd.—  
 Mine Department.  
 —DETAIL PLAN, UNDERGROUND WORKINGS—  
 —NORTH LYELL MINE.—  
 —SCALE 1 INCH=30 FEET.—

Genl. Manager *W. J. ...*  
 Engineer-in-Charge *D. J. ...*

3