

LYELL THARSIS


NORTH MOUNT LYELL

CROWN LYELL MIN. CO.

2105  
91M

30  
90

2150  
91M

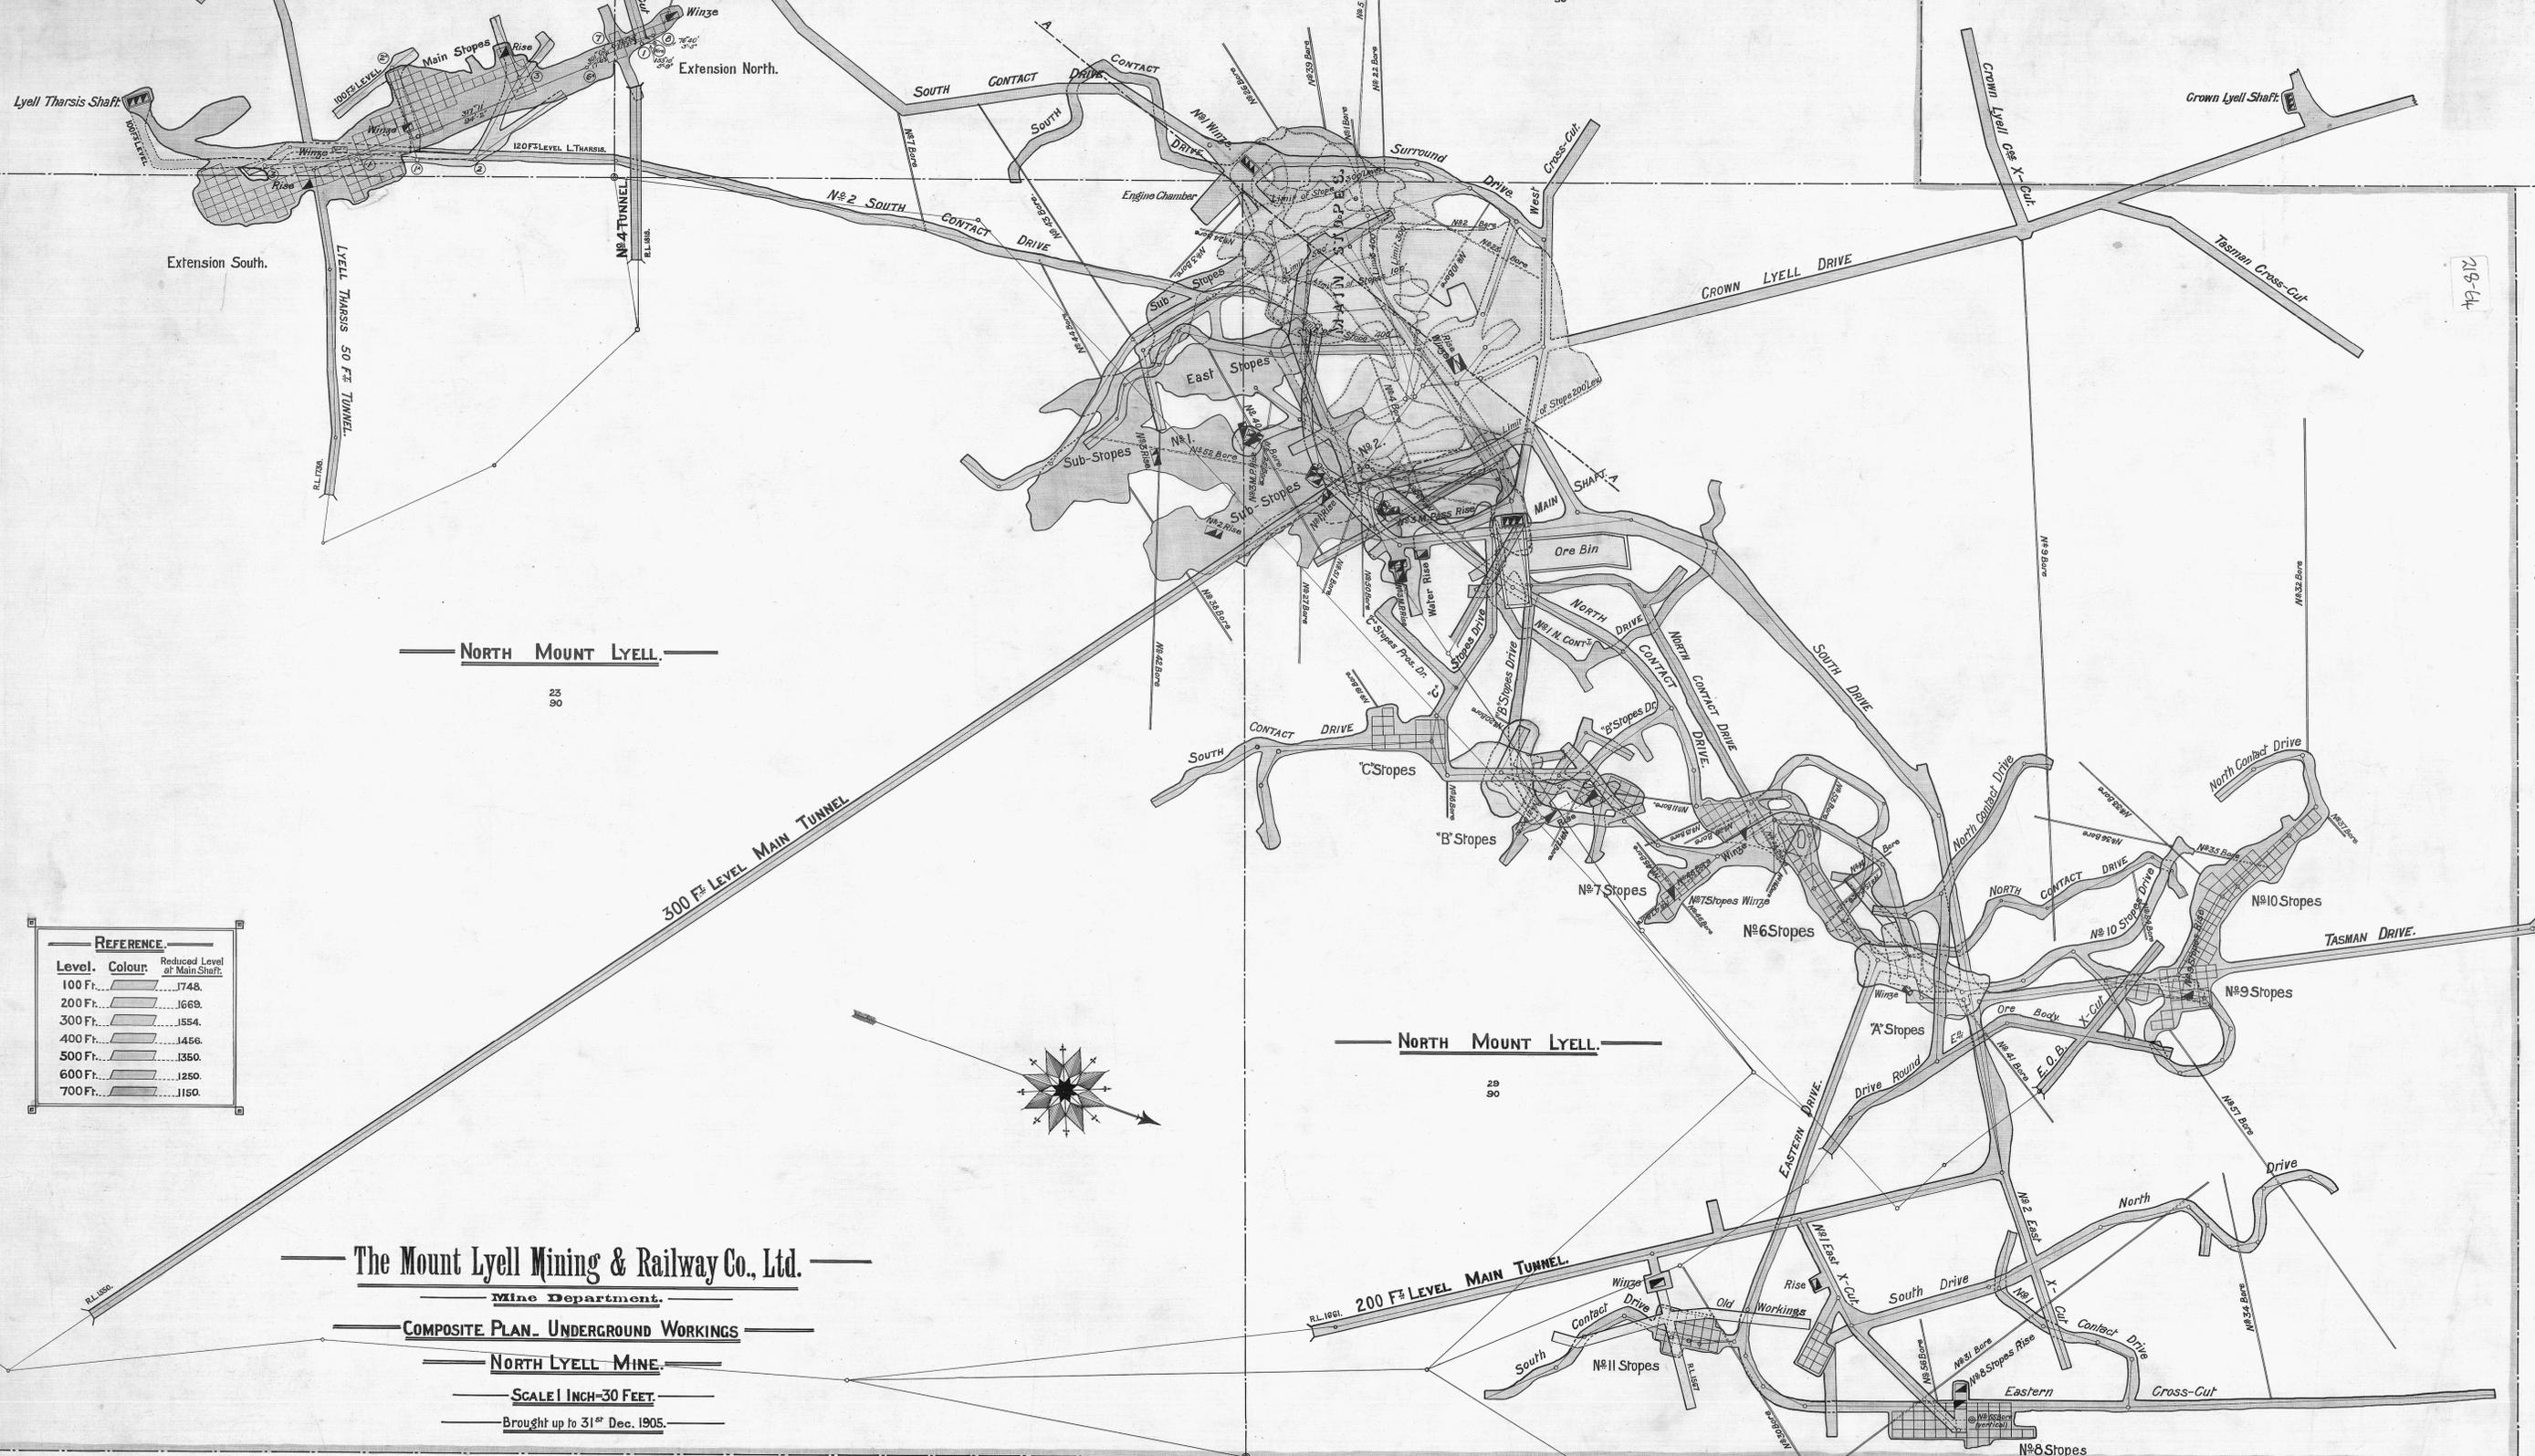

Extension South.

NORTH MOUNT LYELL

25  
90

NORTH MOUNT LYELL

28  
90

MOUNT LYELL BLOCKS MIN. CO.

10  
1900

8  
1900

500 FT LEVEL  
BLOCKS SHAFT WORKINGS

**REFERENCE.**

Level.	Colour.	Reduced Level of Main Shaft.
100 Ft.	—	1748.
200 Ft.	—	1669.
300 Ft.	—	1584.
400 Ft.	—	1486.
500 Ft.	—	1350.
600 Ft.	—	1250.
700 Ft.	—	1150.

The Mount Lyell Mining & Railway Co., Ltd.

Mine Department.

COMPOSITE PLAN. UNDERGROUND WORKINGS

NORTH LYELL MINE.

SCALE 1 INCH=30 FEET.

Brought up to 31<sup>st</sup> Dec. 1905.

Coal Manager...  
Engineer-in-Charge...



218-64

1889  
91M

TASMAN LYELL

218-64