



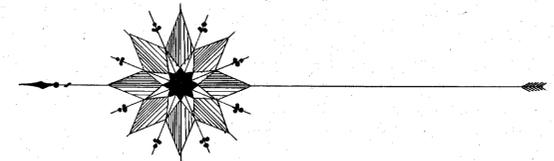

218-65

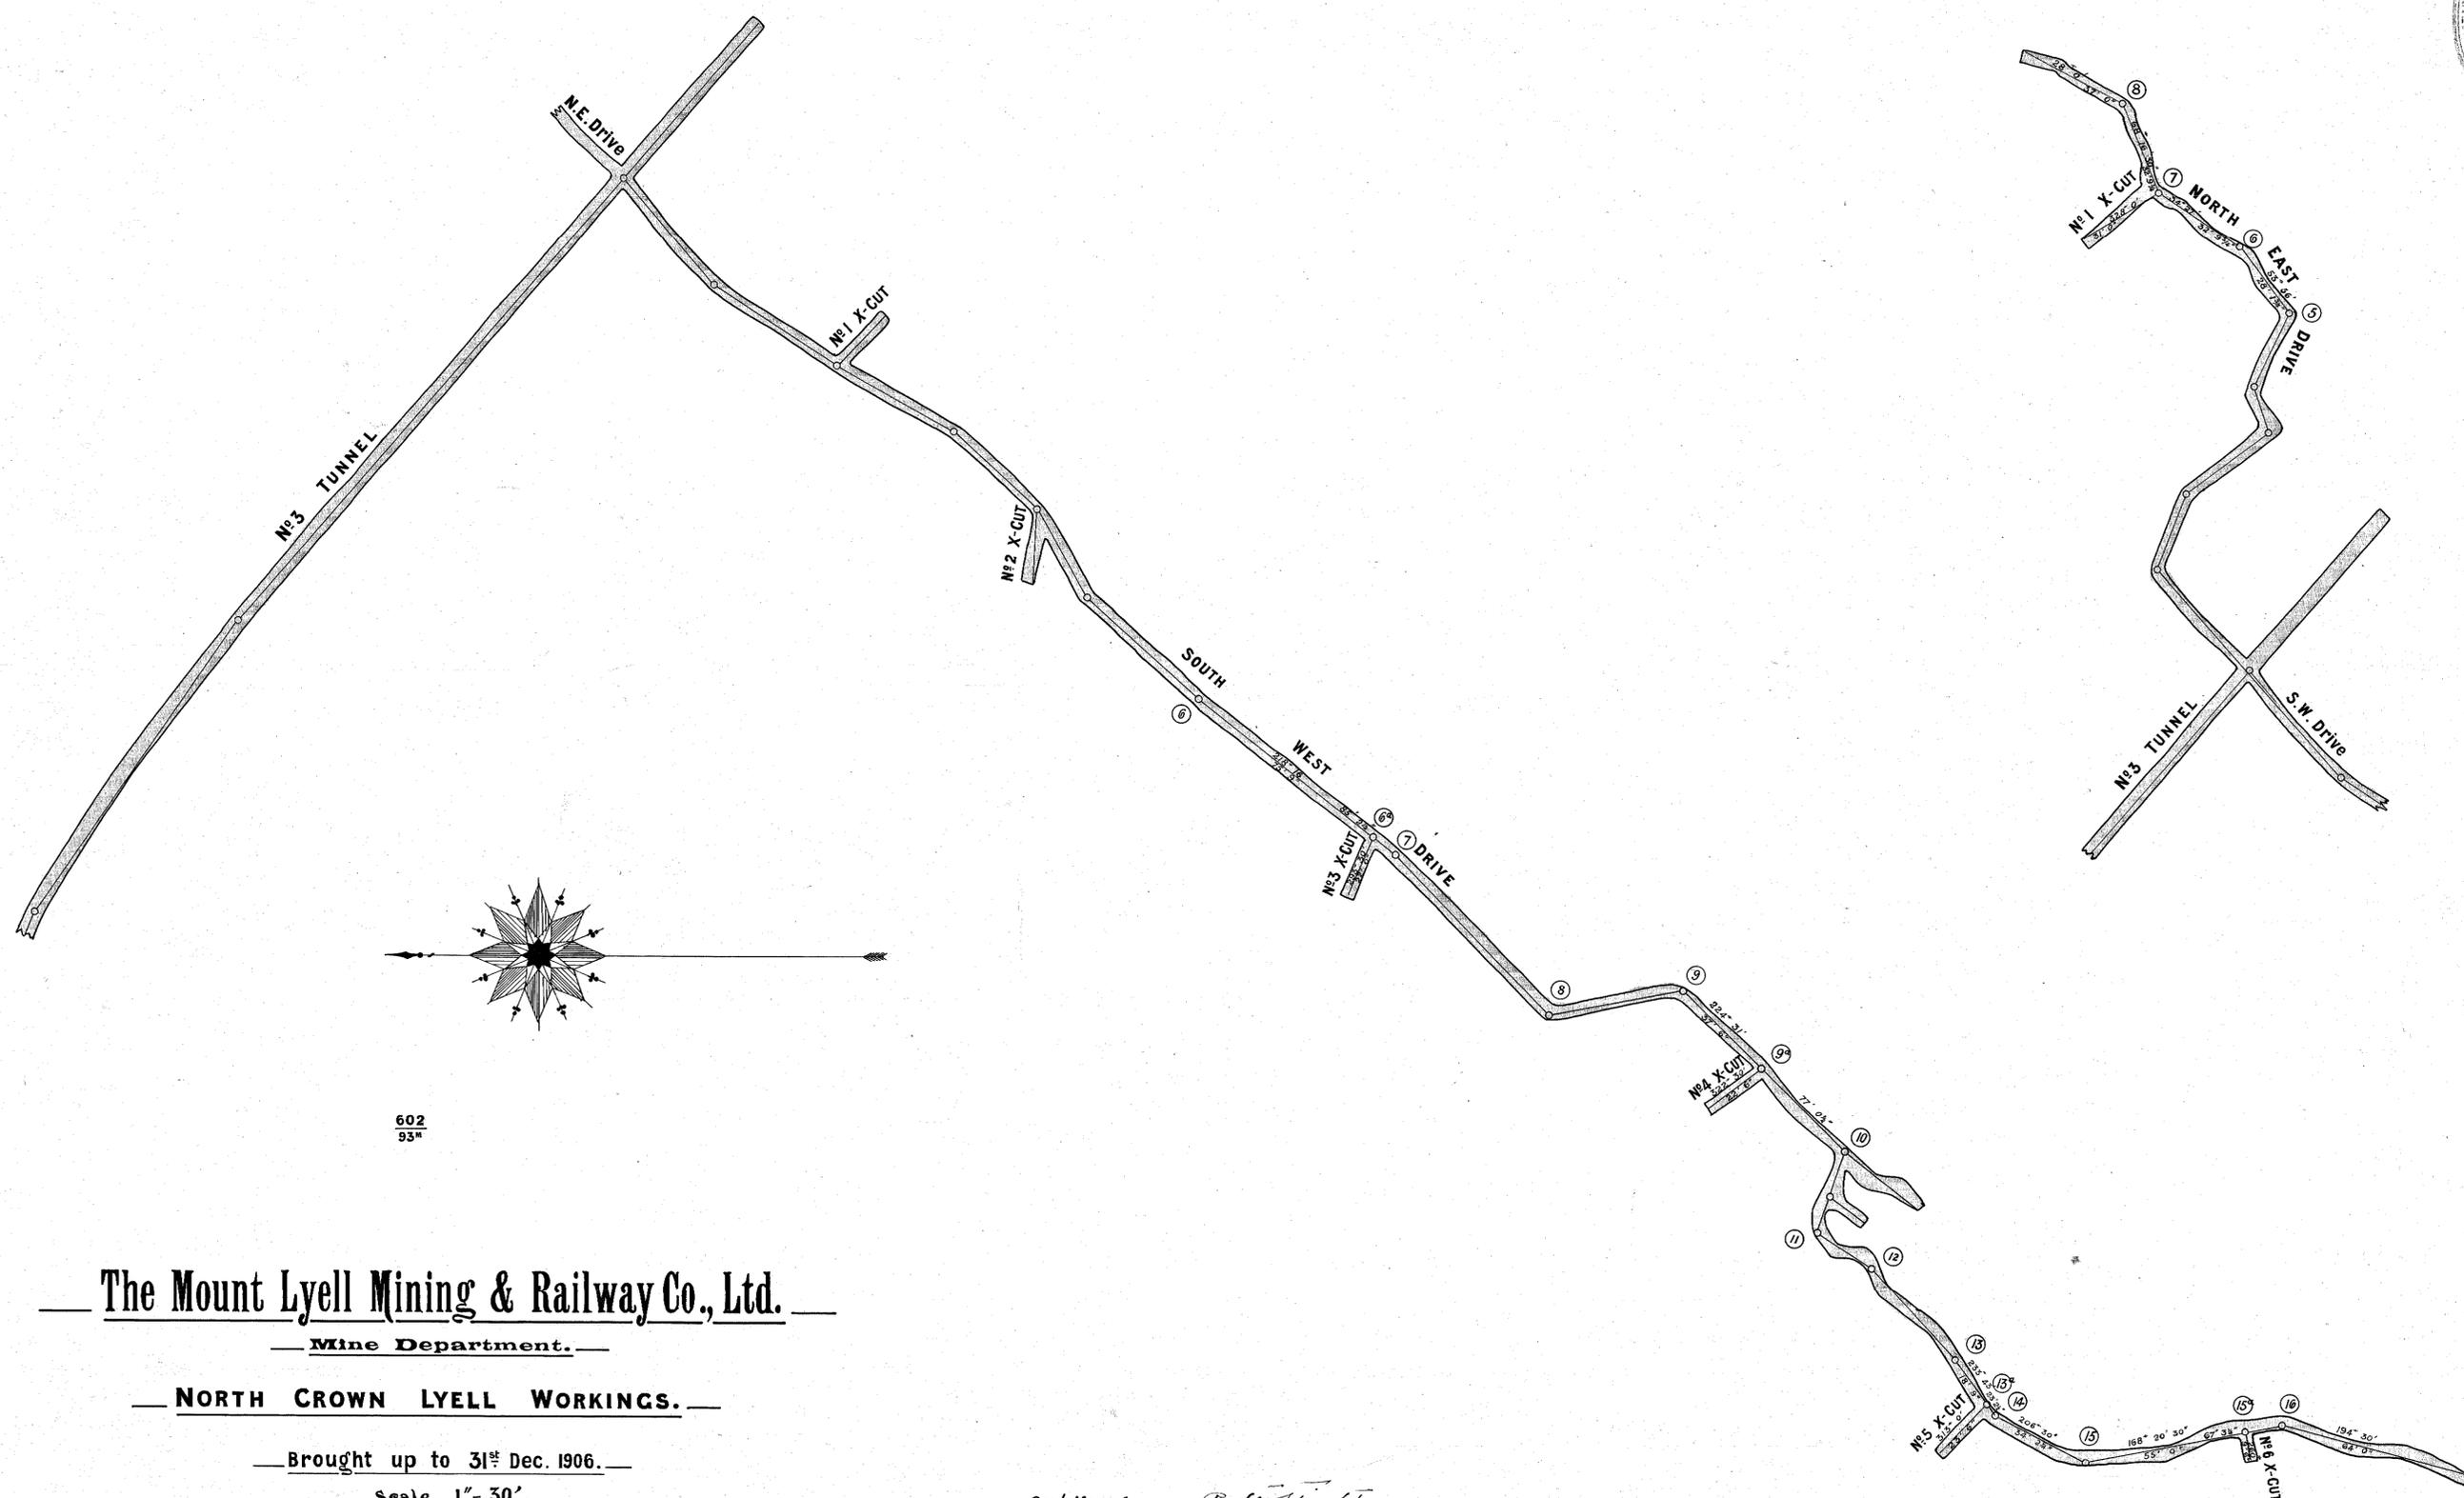

602  
93"

**The Mount Lyell Mining & Railway Co., Ltd.**

Mine Department.

**NORTH CROWN LYELL WORKINGS.**

Brought up to 31<sup>st</sup> Dec. 1906.

Scale - 1" = 30'.

Genl. Manager..... *Robt. Luck*  
Eng<sup>r</sup> in Charge..... *R. Mc Murray (acting)*

218-65