



218-67

500'

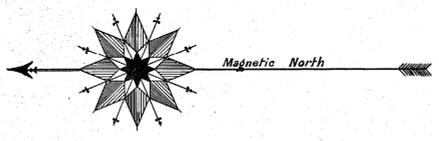

— The Mount Lyell Mining & Railway Co., Ltd. —  
 Mine Department.  
 — NORTH CROWN LYELL WORKINGS —  
 Scale 1"=30'

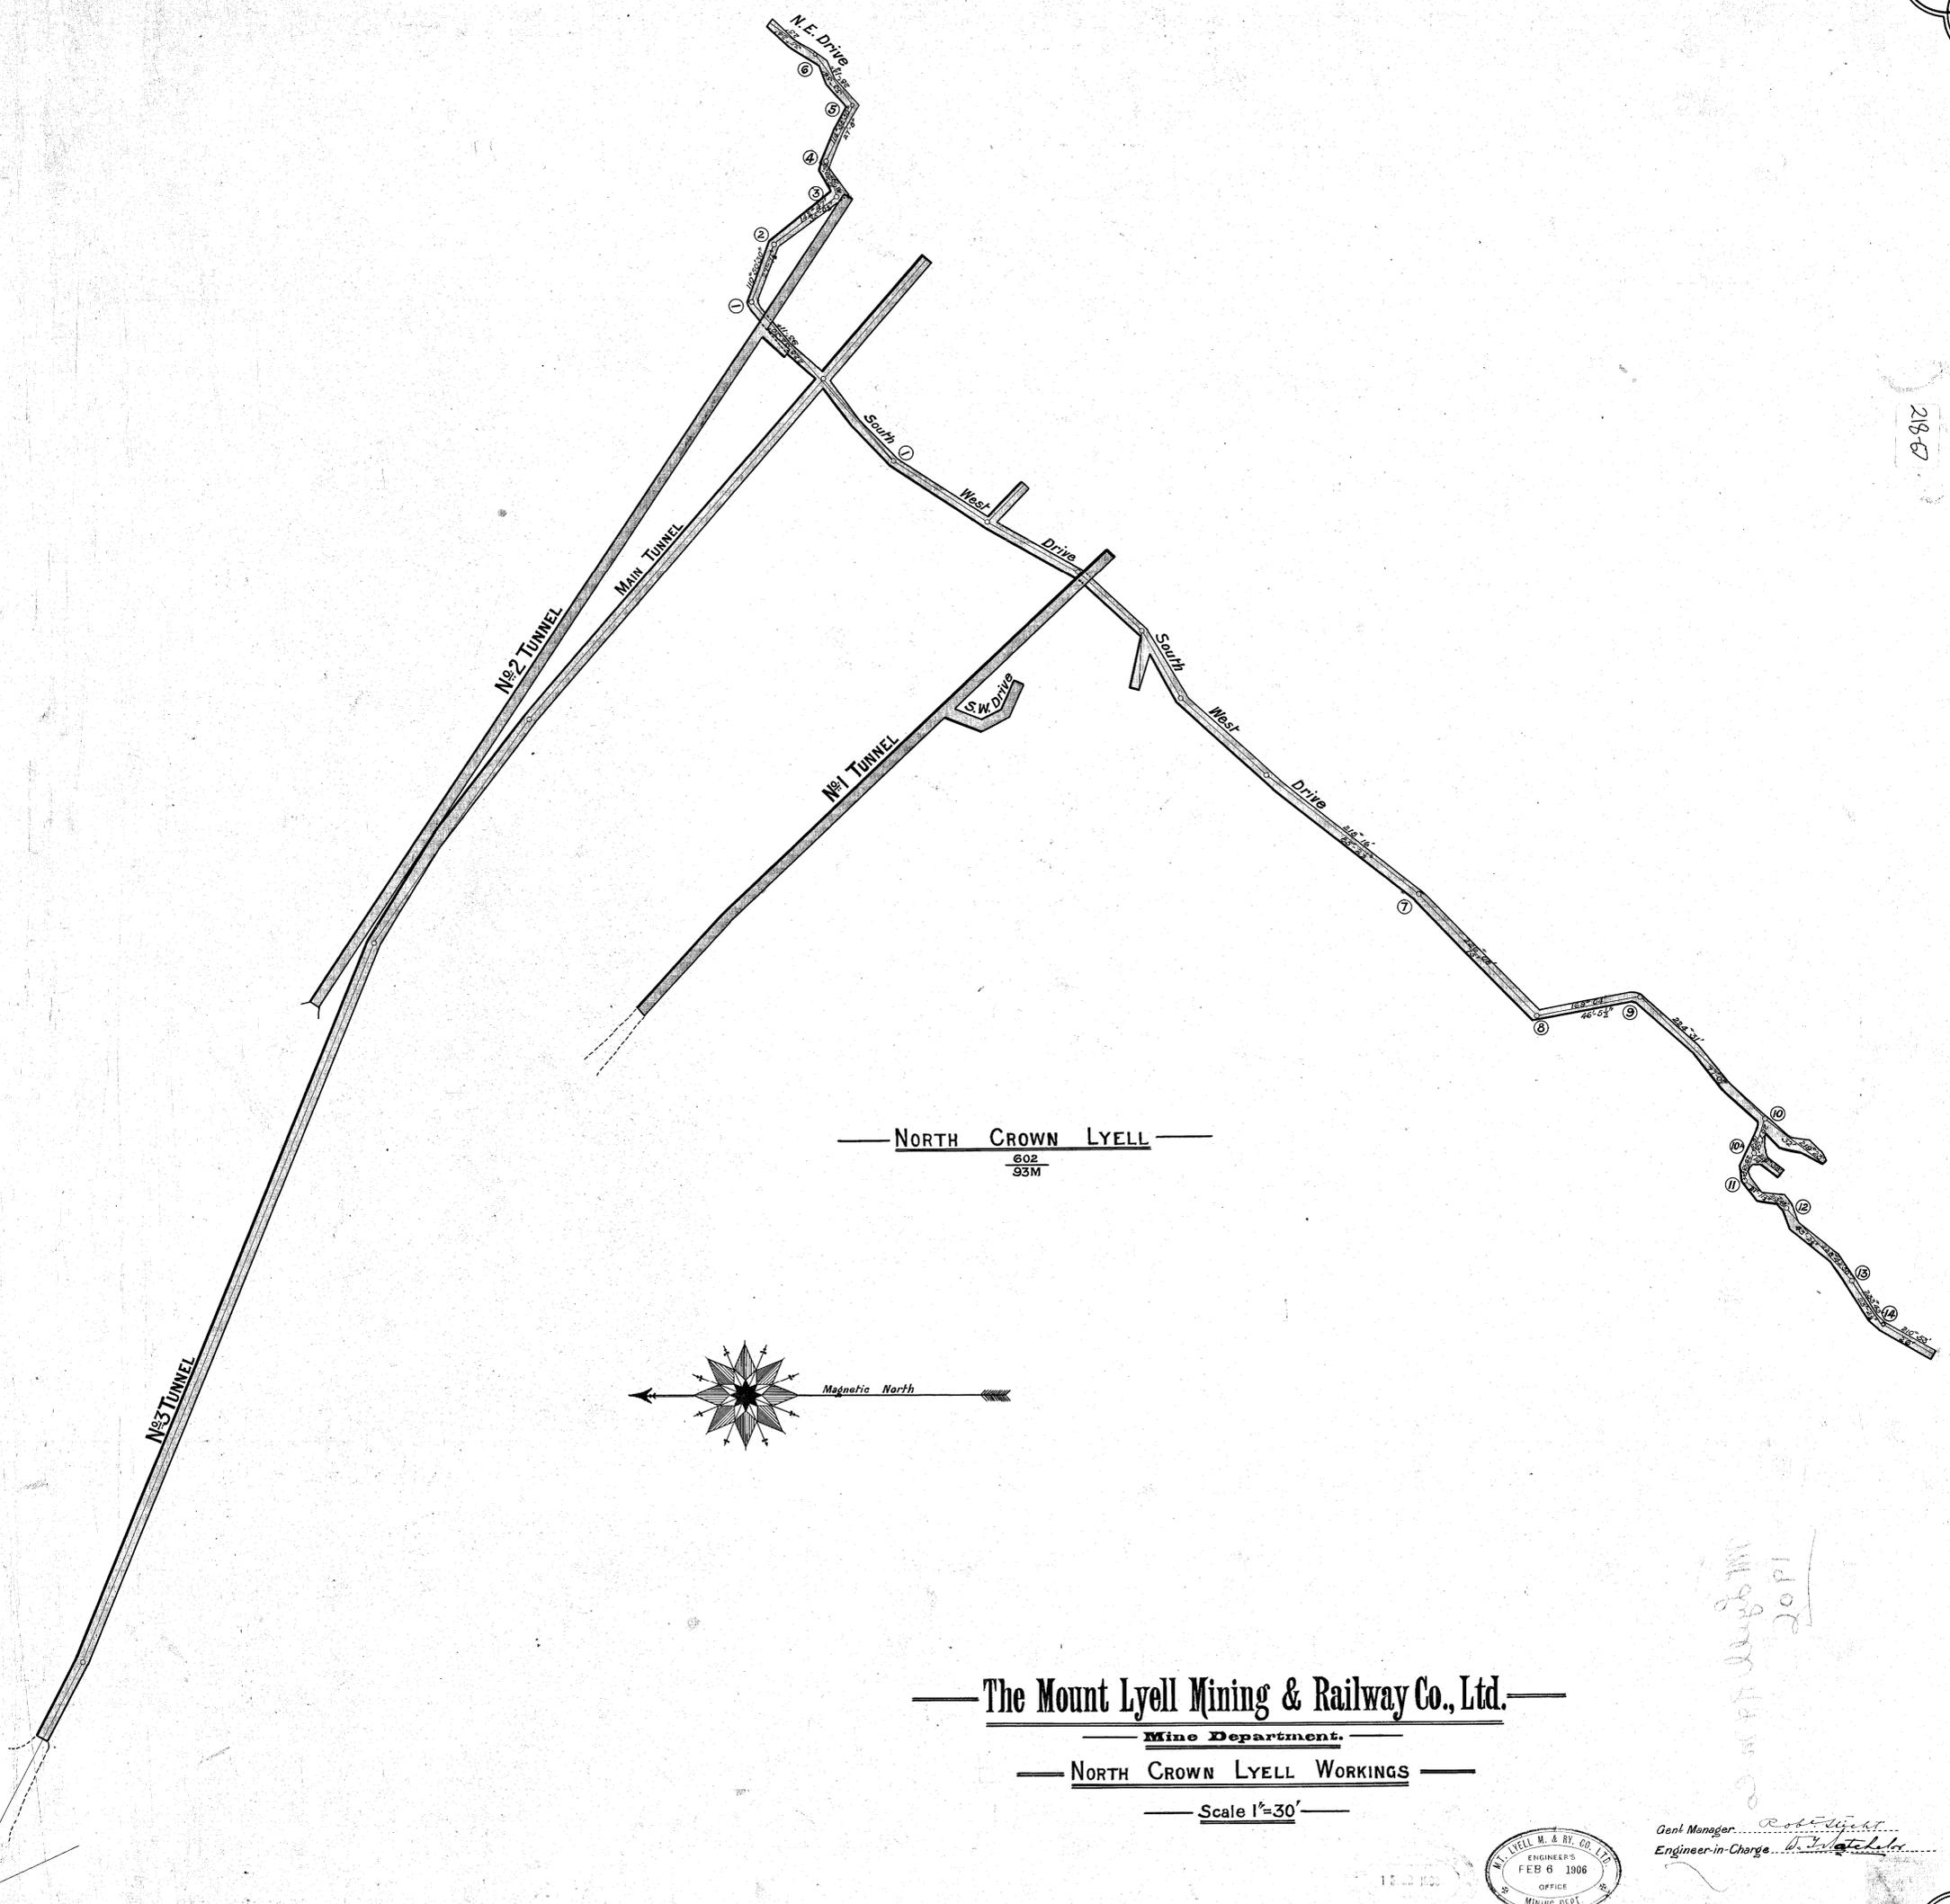

Genl. Manager *Roddy*  
 Engineer-in-Charge *W. J. ...*

*20PI*

218-67