


5 cm

28-68

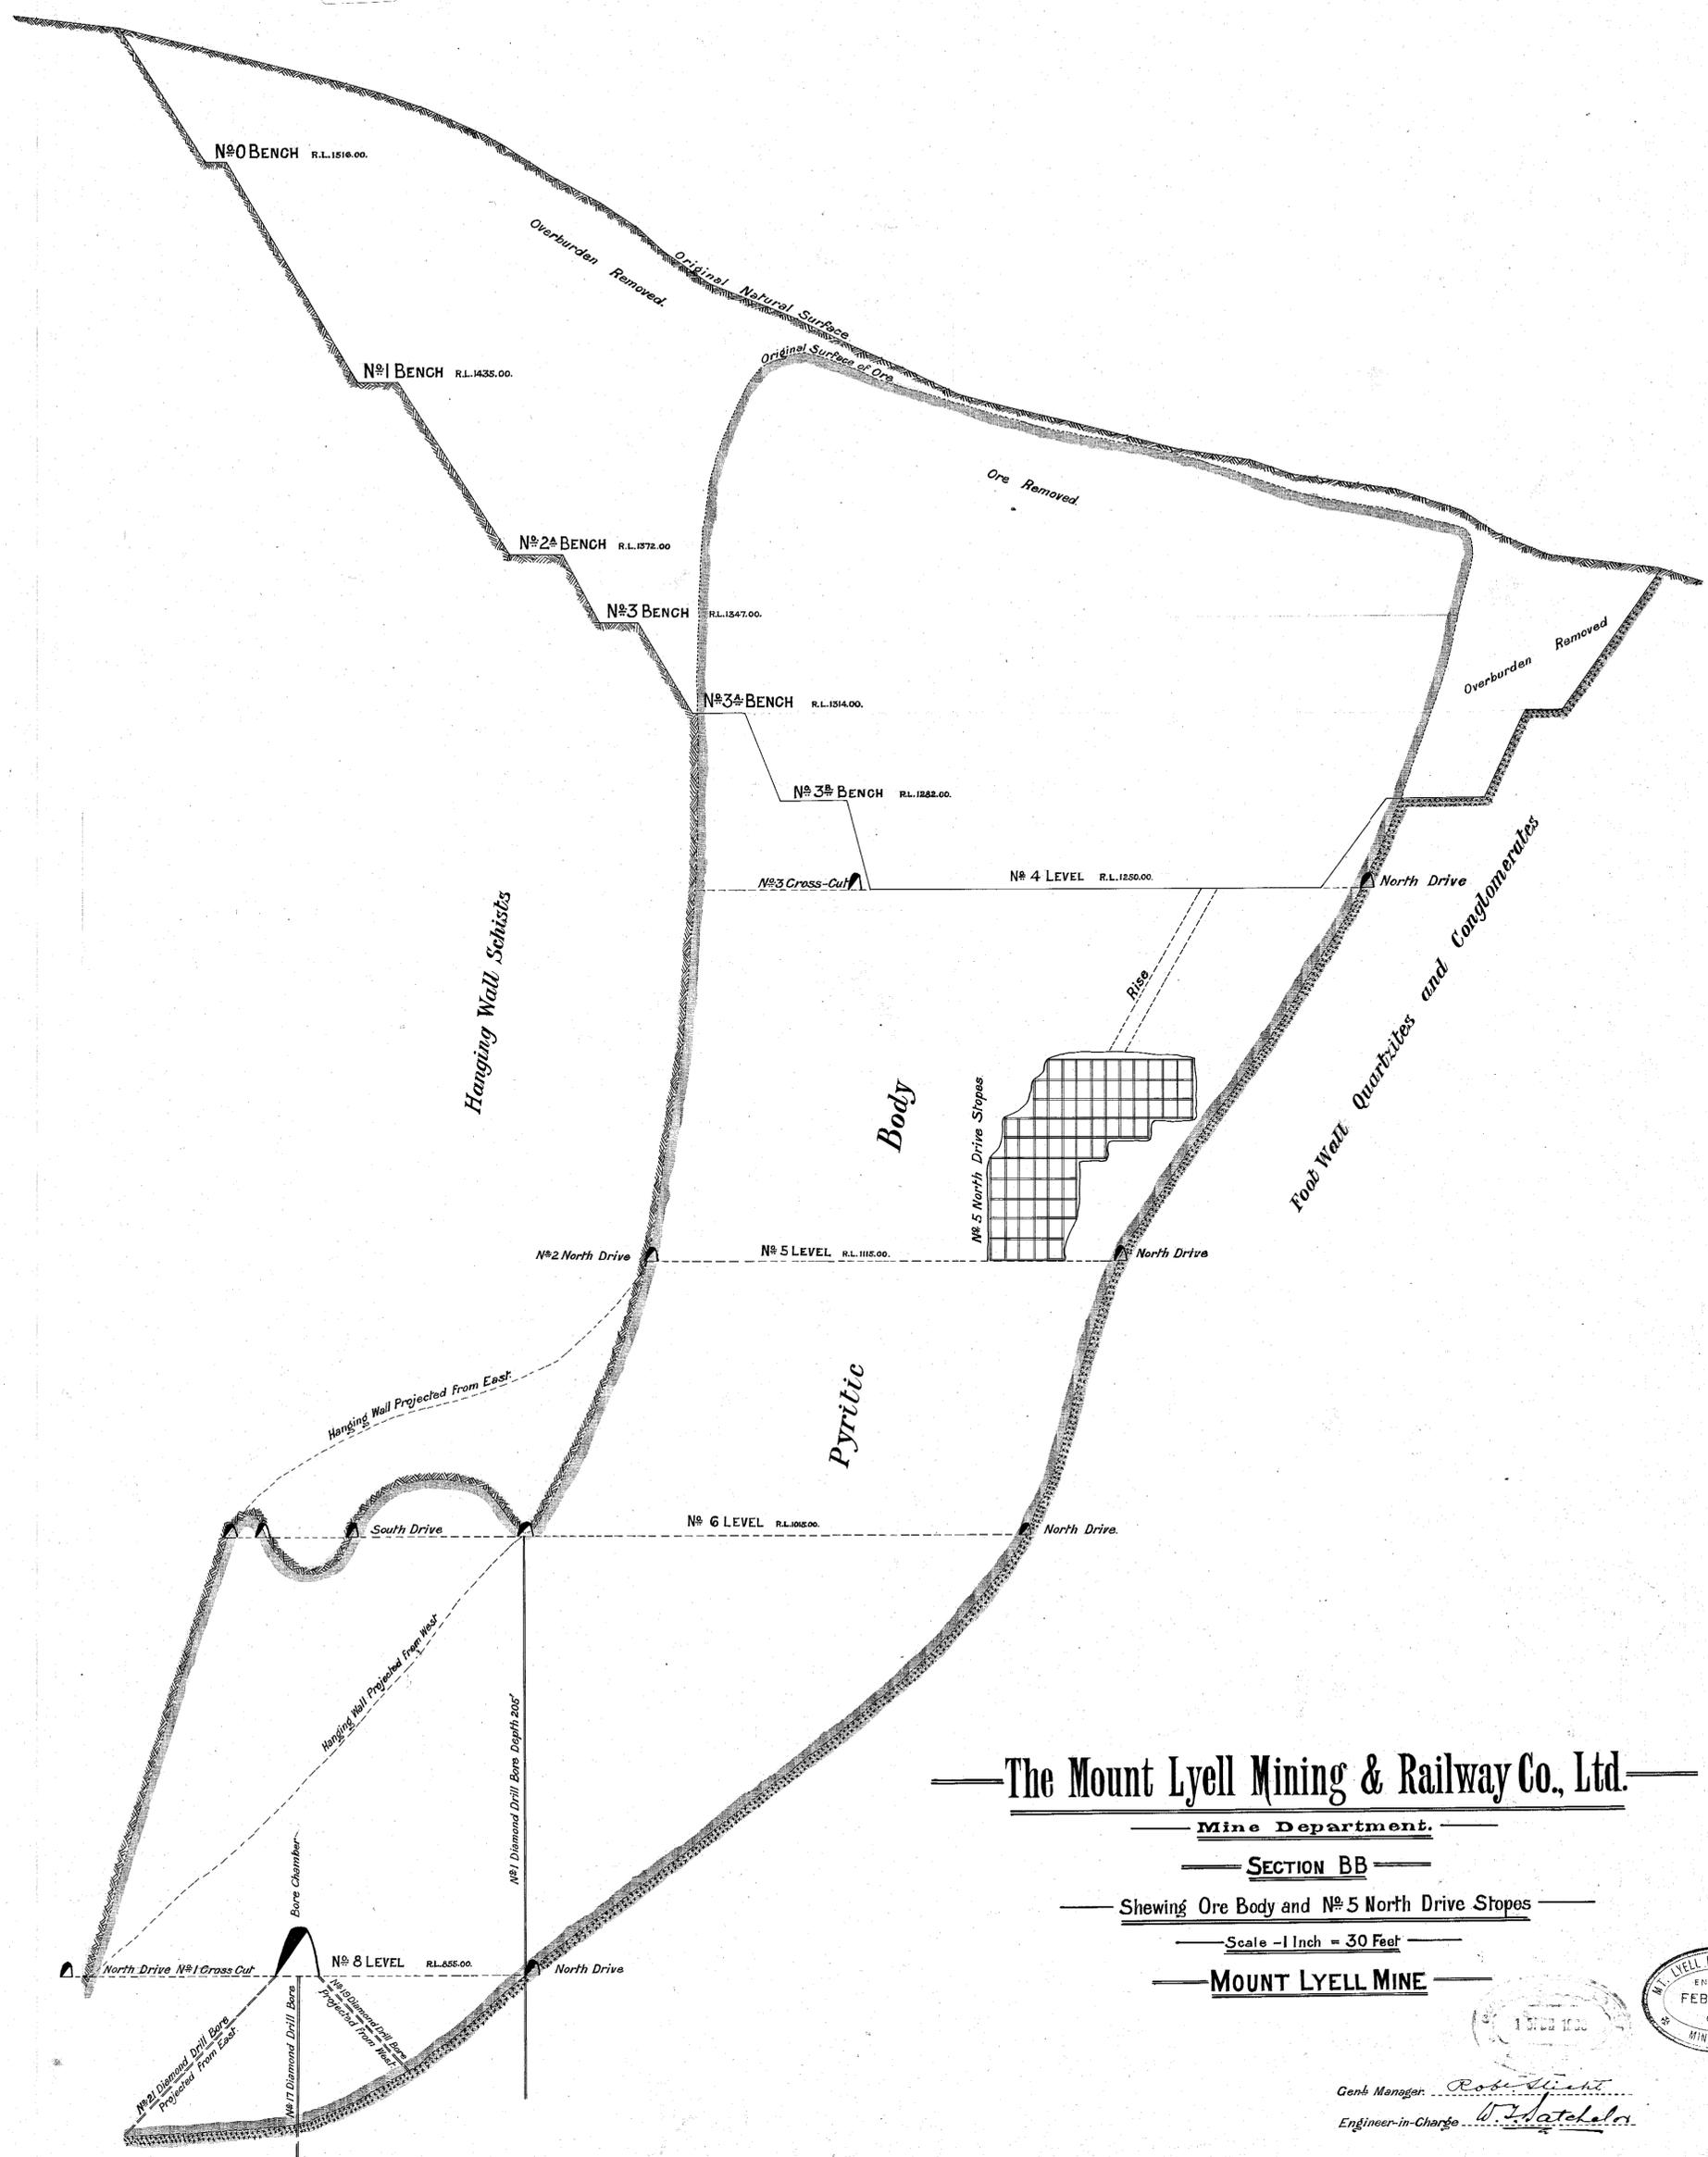

The Mount Lyell Mining & Railway Co., Ltd.

Mine Department.

SECTION BB

Shewing Ore Body and N°5 North Drive Stoppes

Scale - 1 Inch = 30 Feet

MOUNT LYELL MINE



Genl. Manager. *Robert Smith*
 Engineer-in-Charge. *W. H. Hatelberg*