


5 cm

218-69

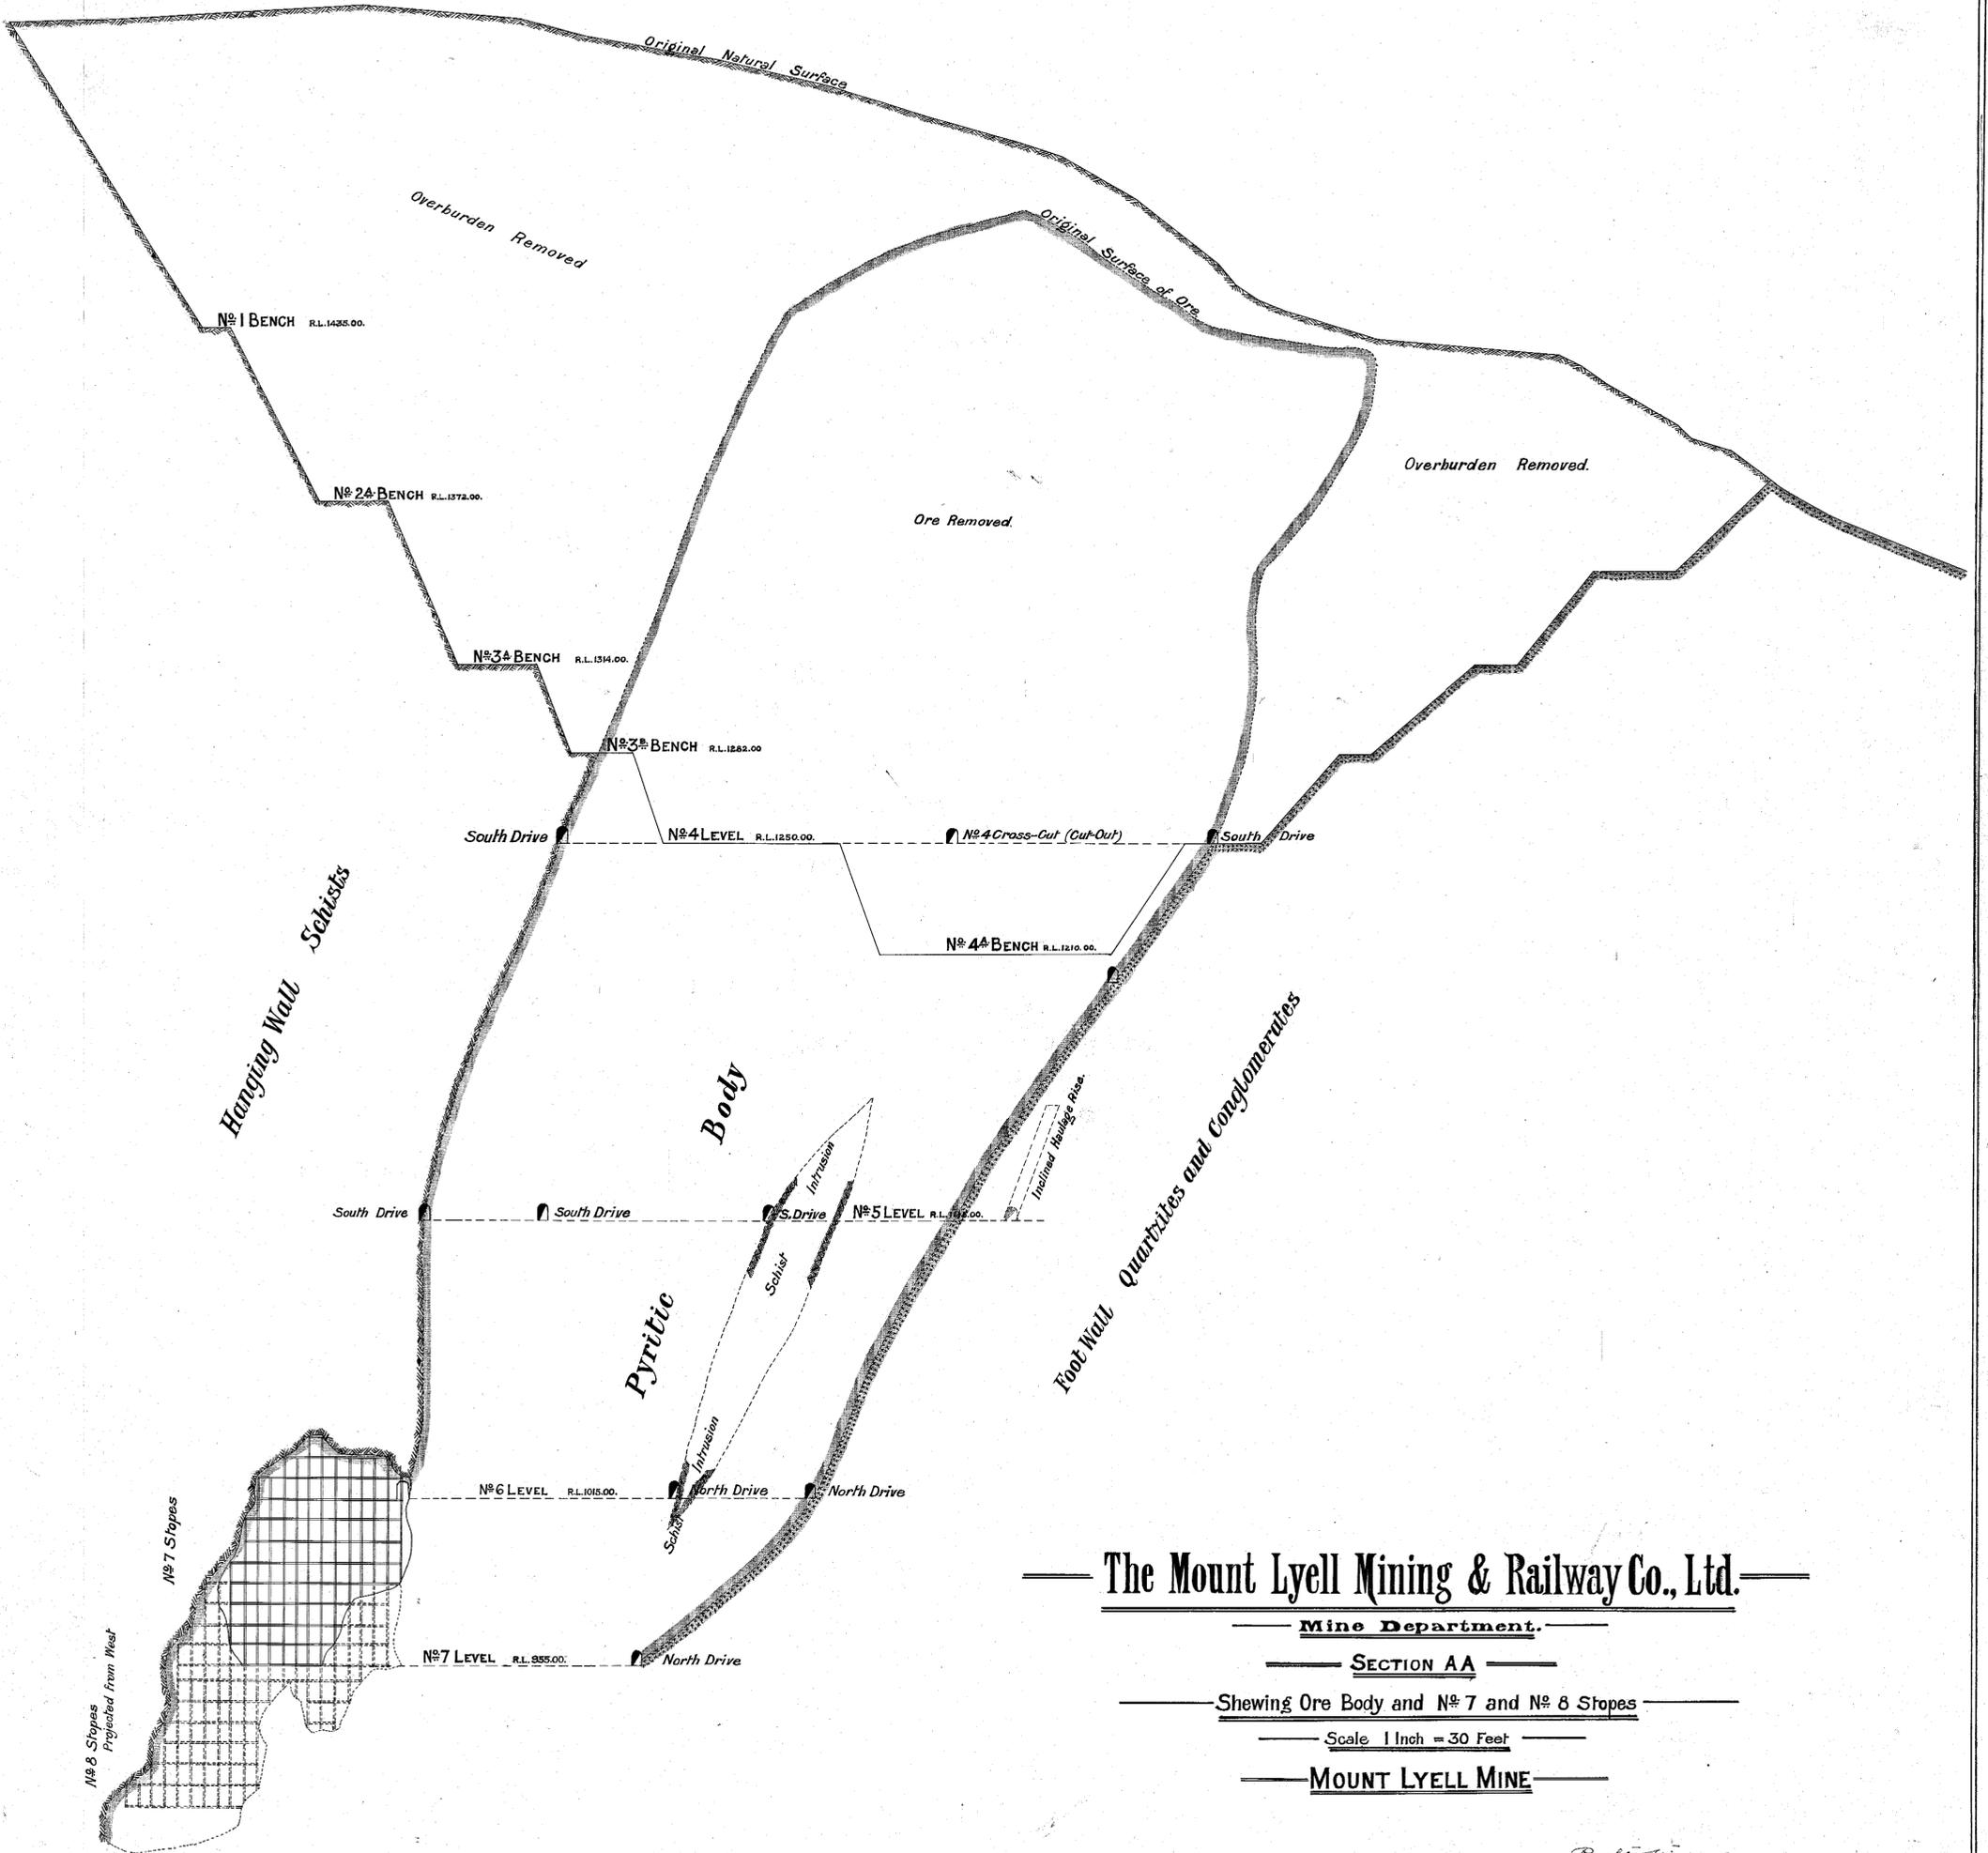

# The Mount Lyell Mining & Railway Co., Ltd.

Mine Department.

SECTION AA

Showing Ore Body and N<sup>o</sup> 7 and N<sup>o</sup> 8 Stopes

Scale 1 Inch = 30 Feet

MOUNT LYELL MINE

Genl. Manager..... *Robt. Smith*  
 Engineer-in-Charge..... *W. J. Hatchell*

