


218-70

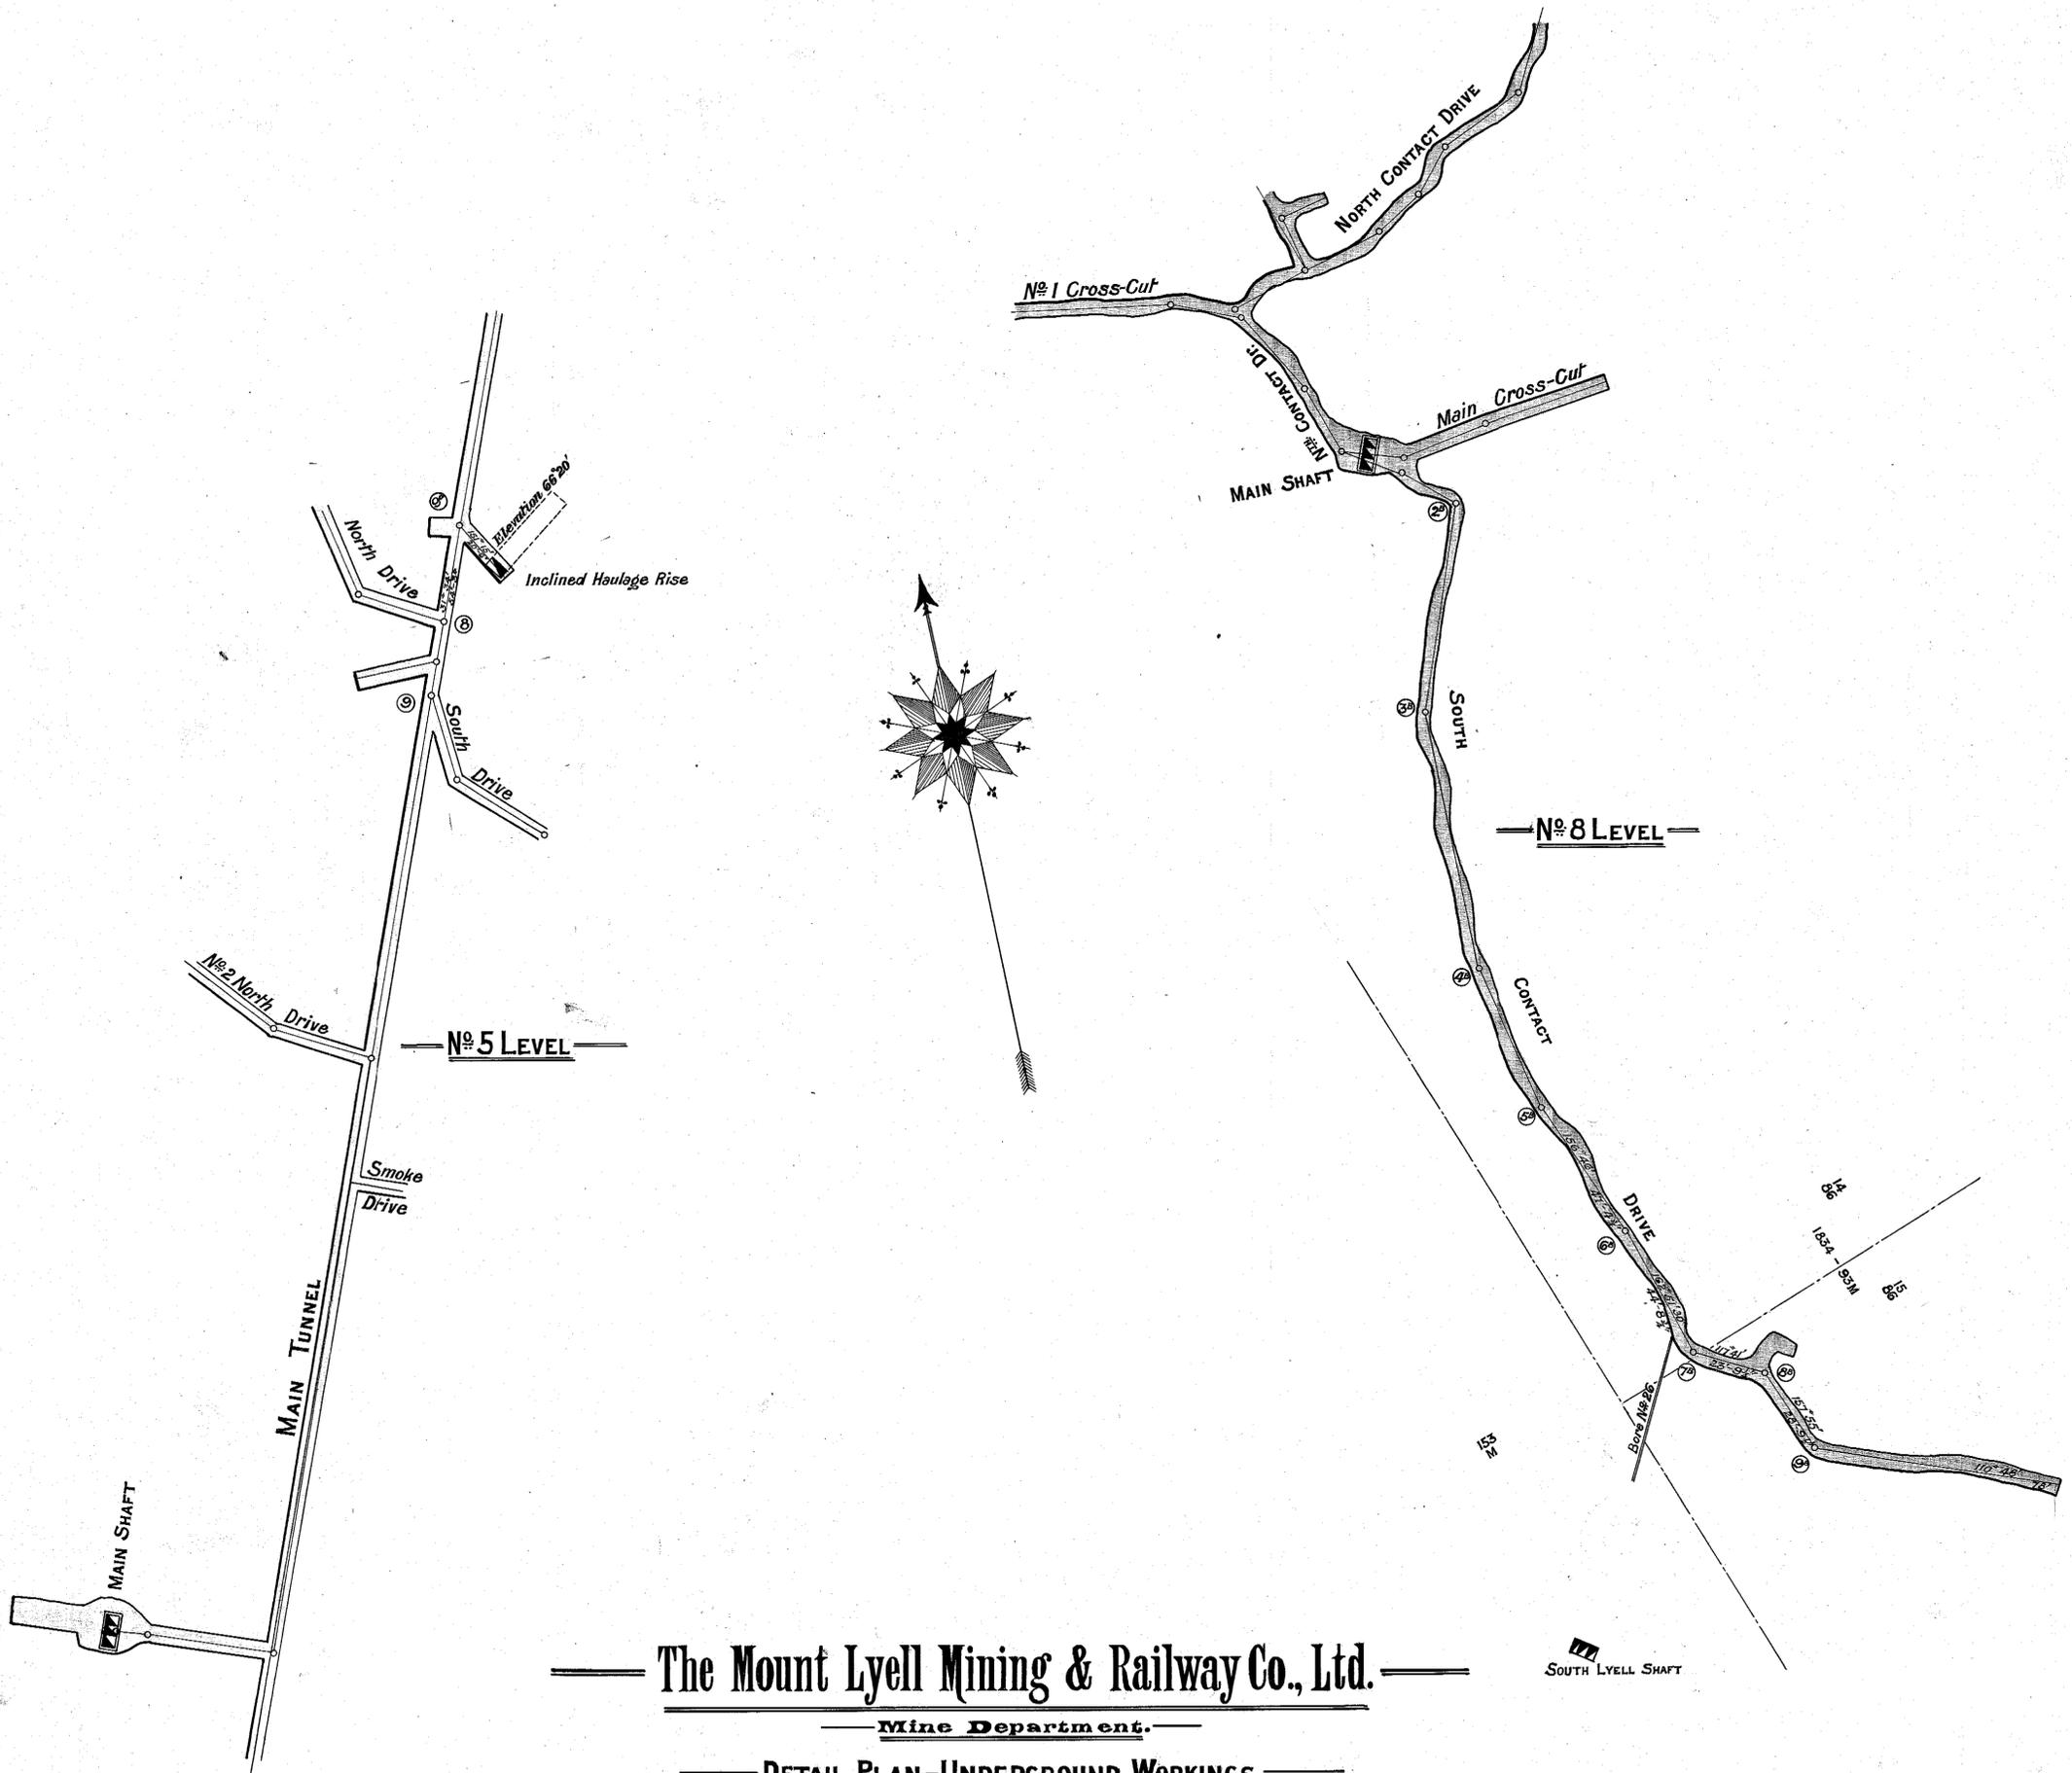

218-70

5 cm

The Mount Lyell Mining & Railway Co., Ltd.

Mine Department.

DETAIL PLAN - UNDERGROUND WORKINGS

MOUNT LYELL MINE

SCALE 1"=30'



SOUTH LYELL SHAFT

Genl Manger... *Robert Light*
 Engineer-in-Charge... *W. J. Hatchell*