




218-71

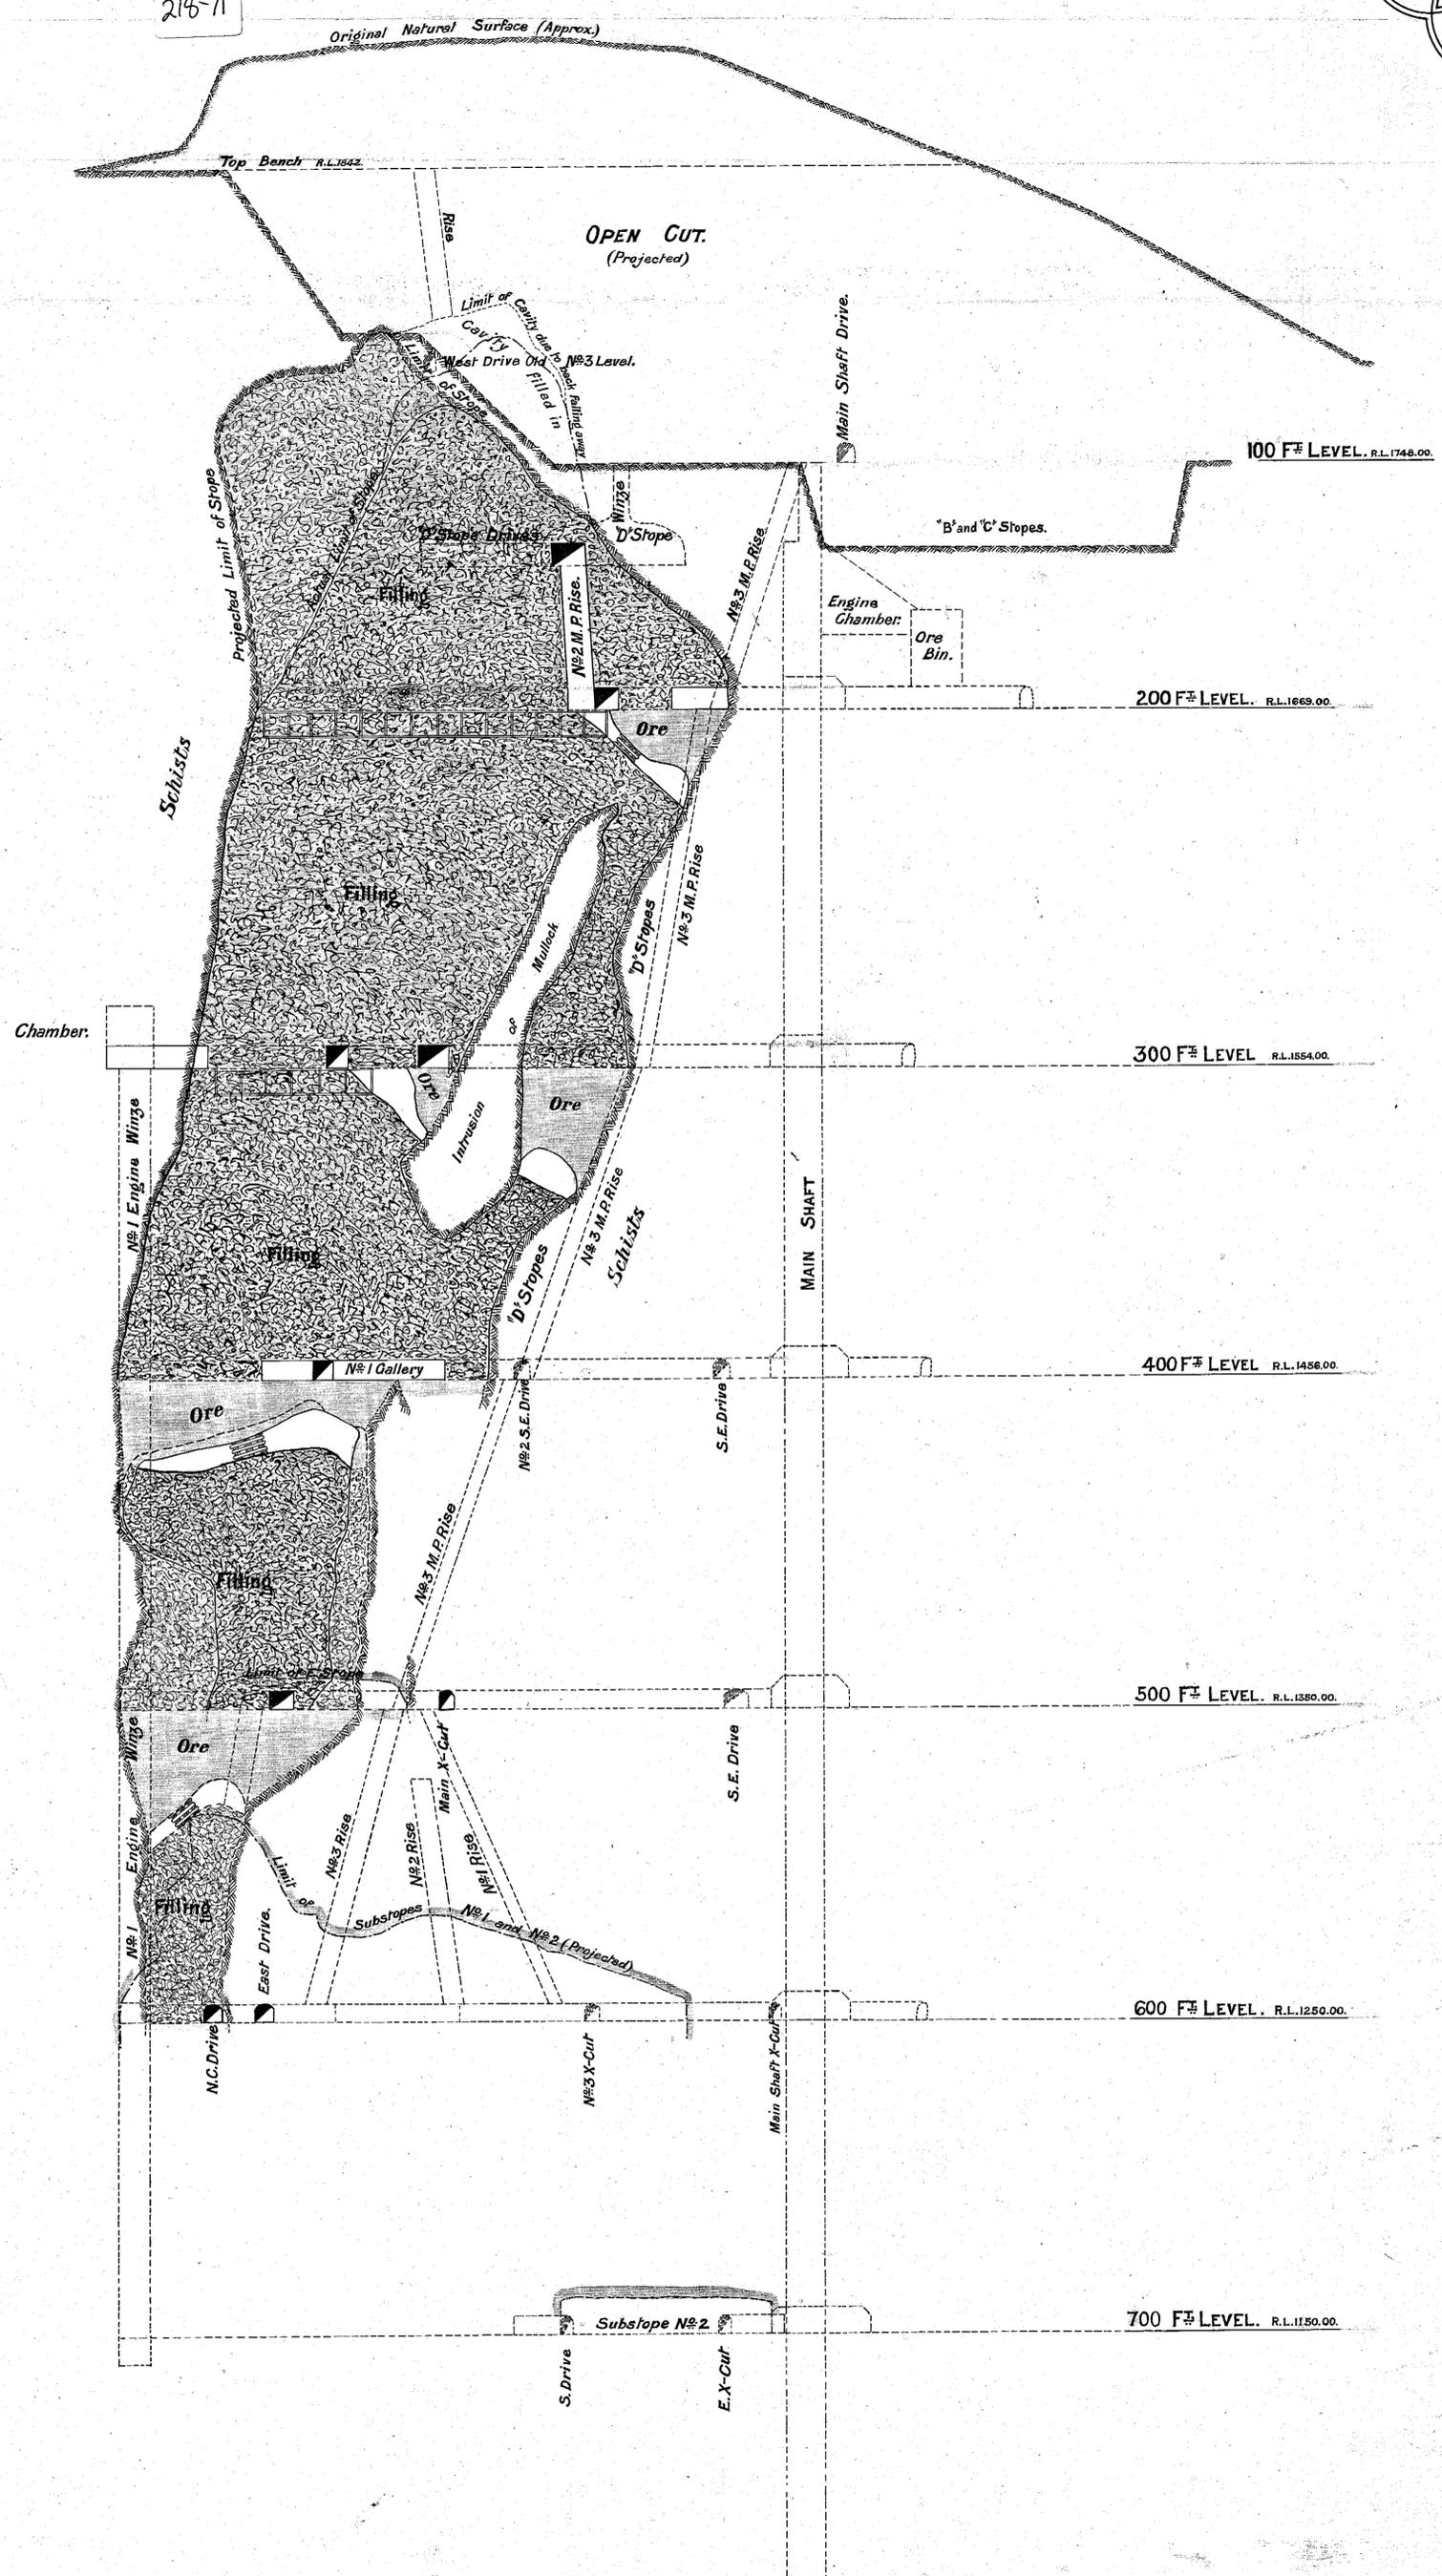

The Mount Lyell Mining & Railway Co., Ltd.


Mine Department.

SECTION ON LINE AA

Through Main Stope

NORTH LYELL MINE

SCALE 1" = 30'

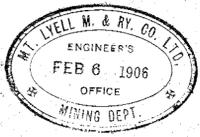

Genl. Manager *Robert Smith*
Engineer in Charge *W. J. Satchell*