


5 cm

218-72

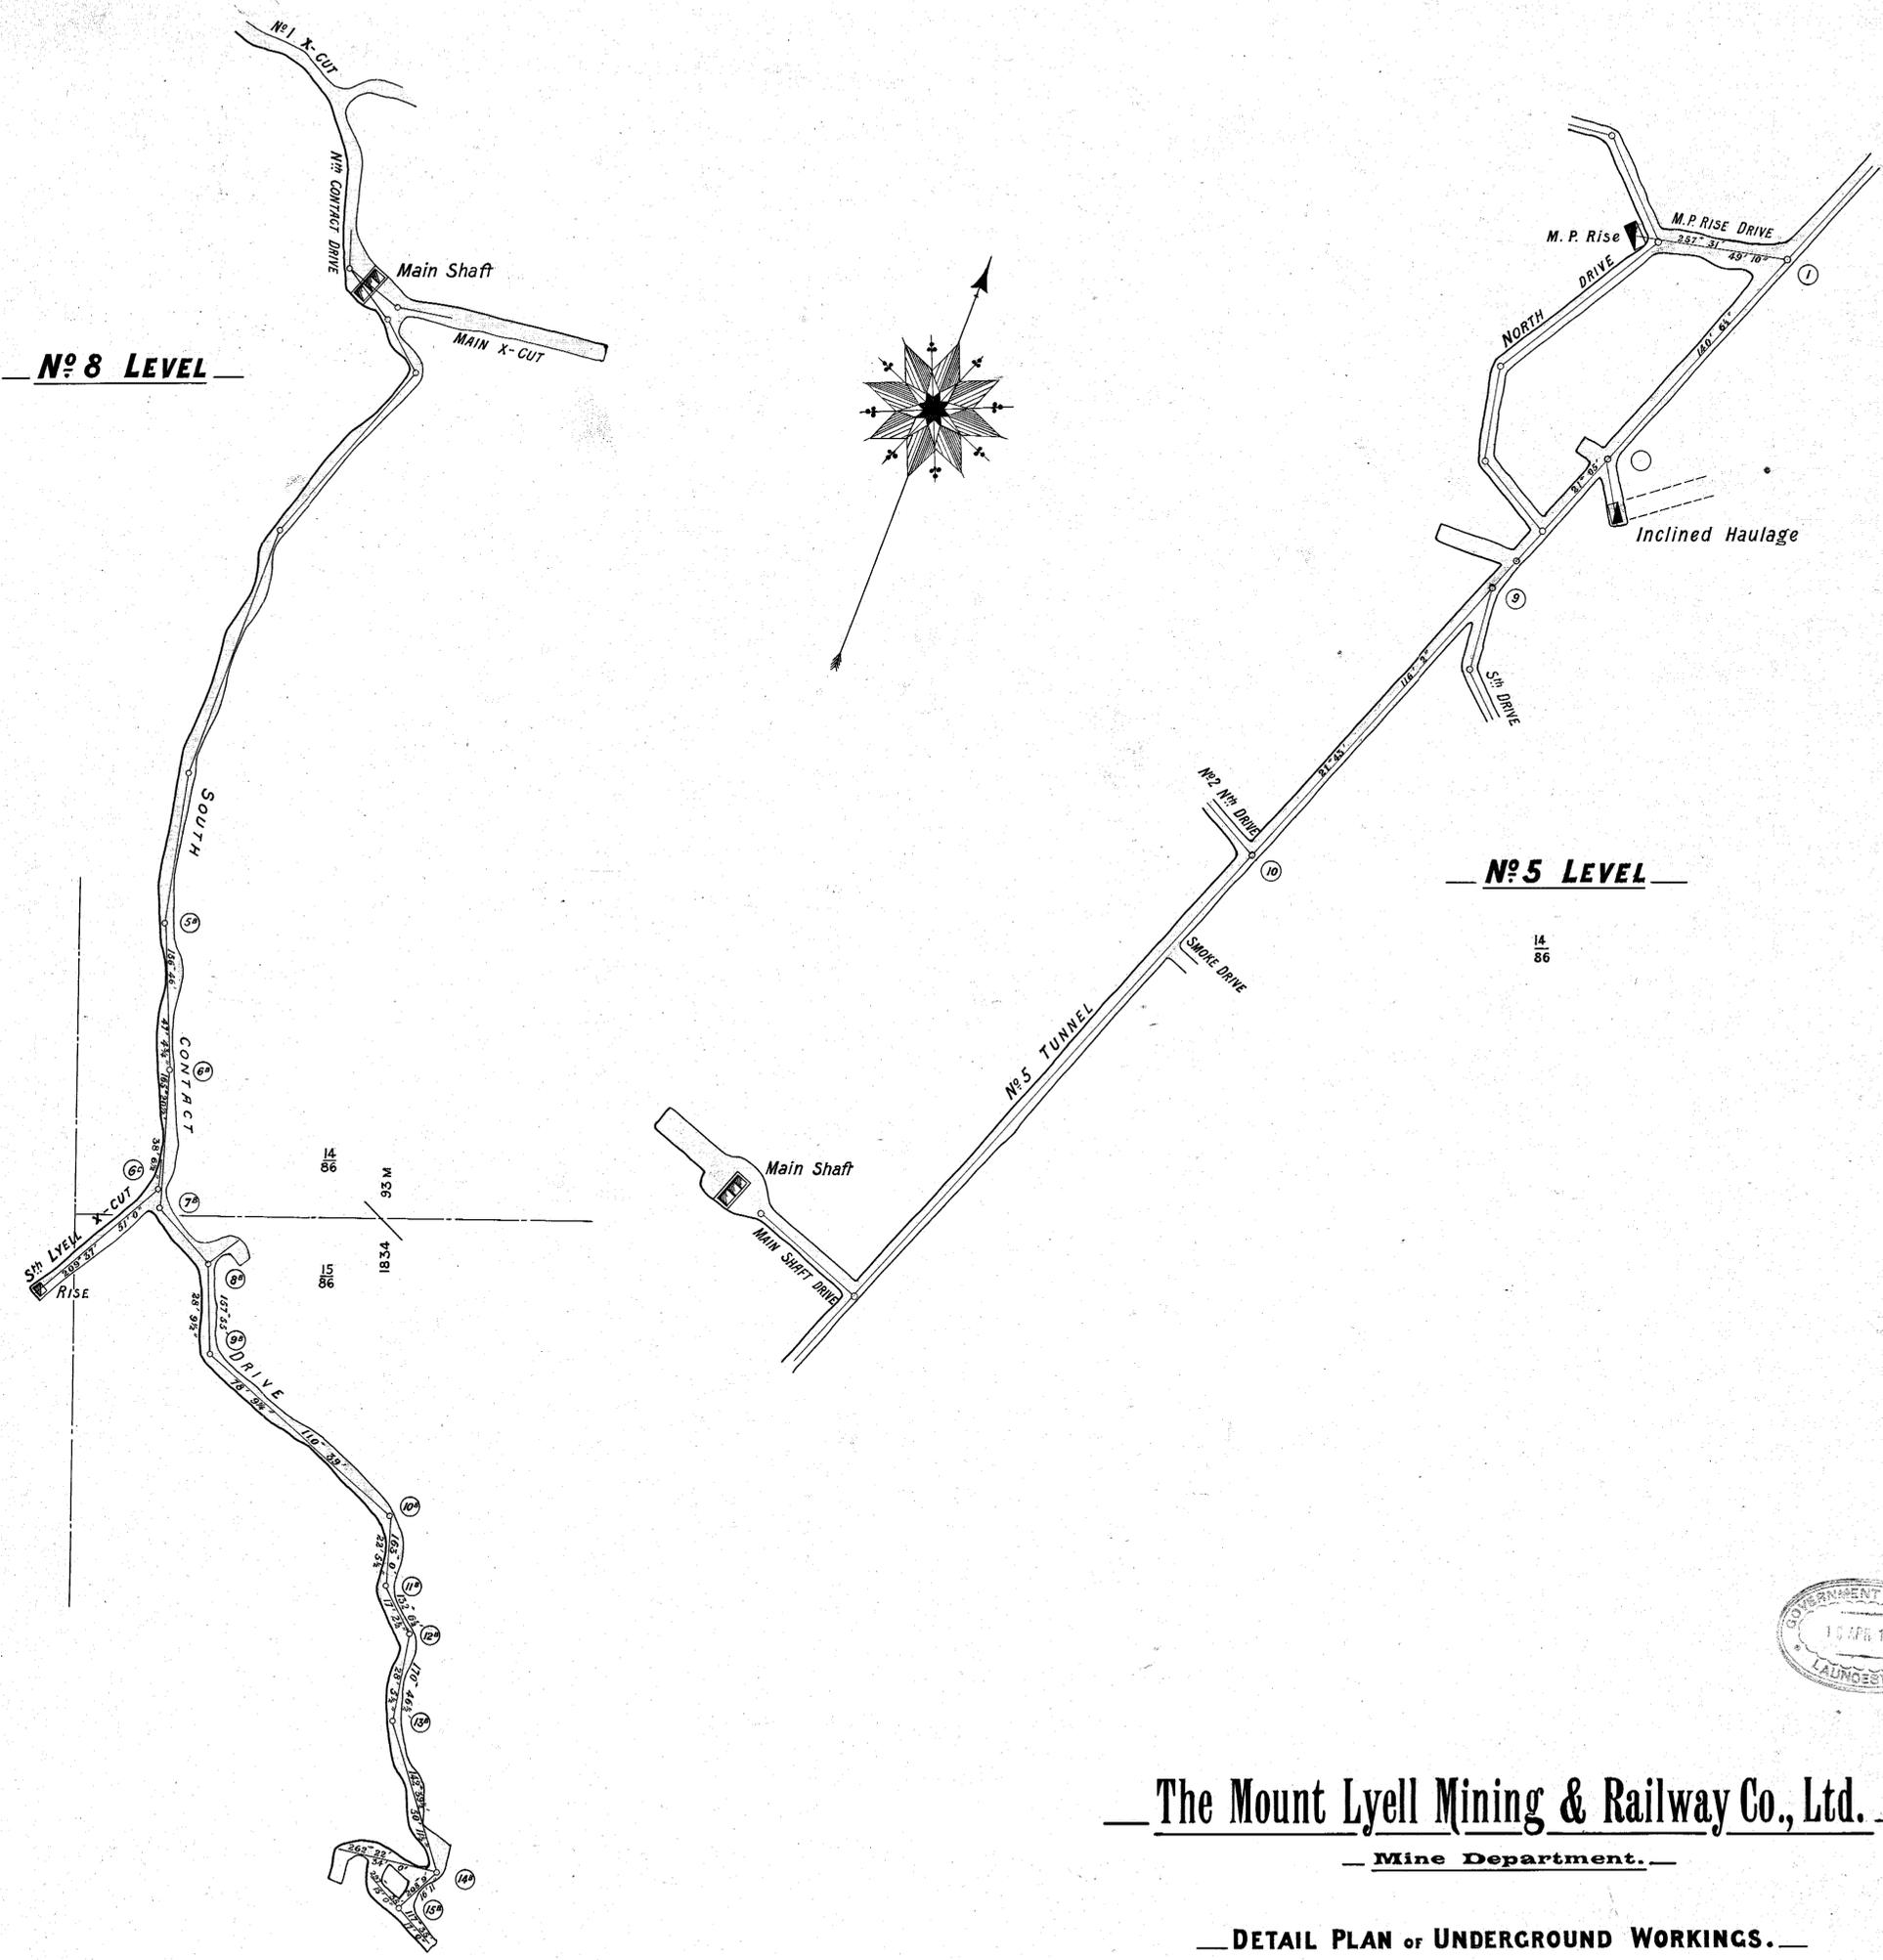

**The Mount Lyell Mining & Railway Co., Ltd.**

**Mine Department.**

**DETAIL PLAN OF UNDERGROUND WORKINGS.**

**MOUNT LYELL MINE.**

**Brought up to 31<sup>st</sup> Dec. 1906.**

**Scale - 1" = 30'.**

Genl Manager... *Robt. Dick*  
 Eng<sup>r</sup> in Charge... *L. G. Murray (acting)*