


21874

21874

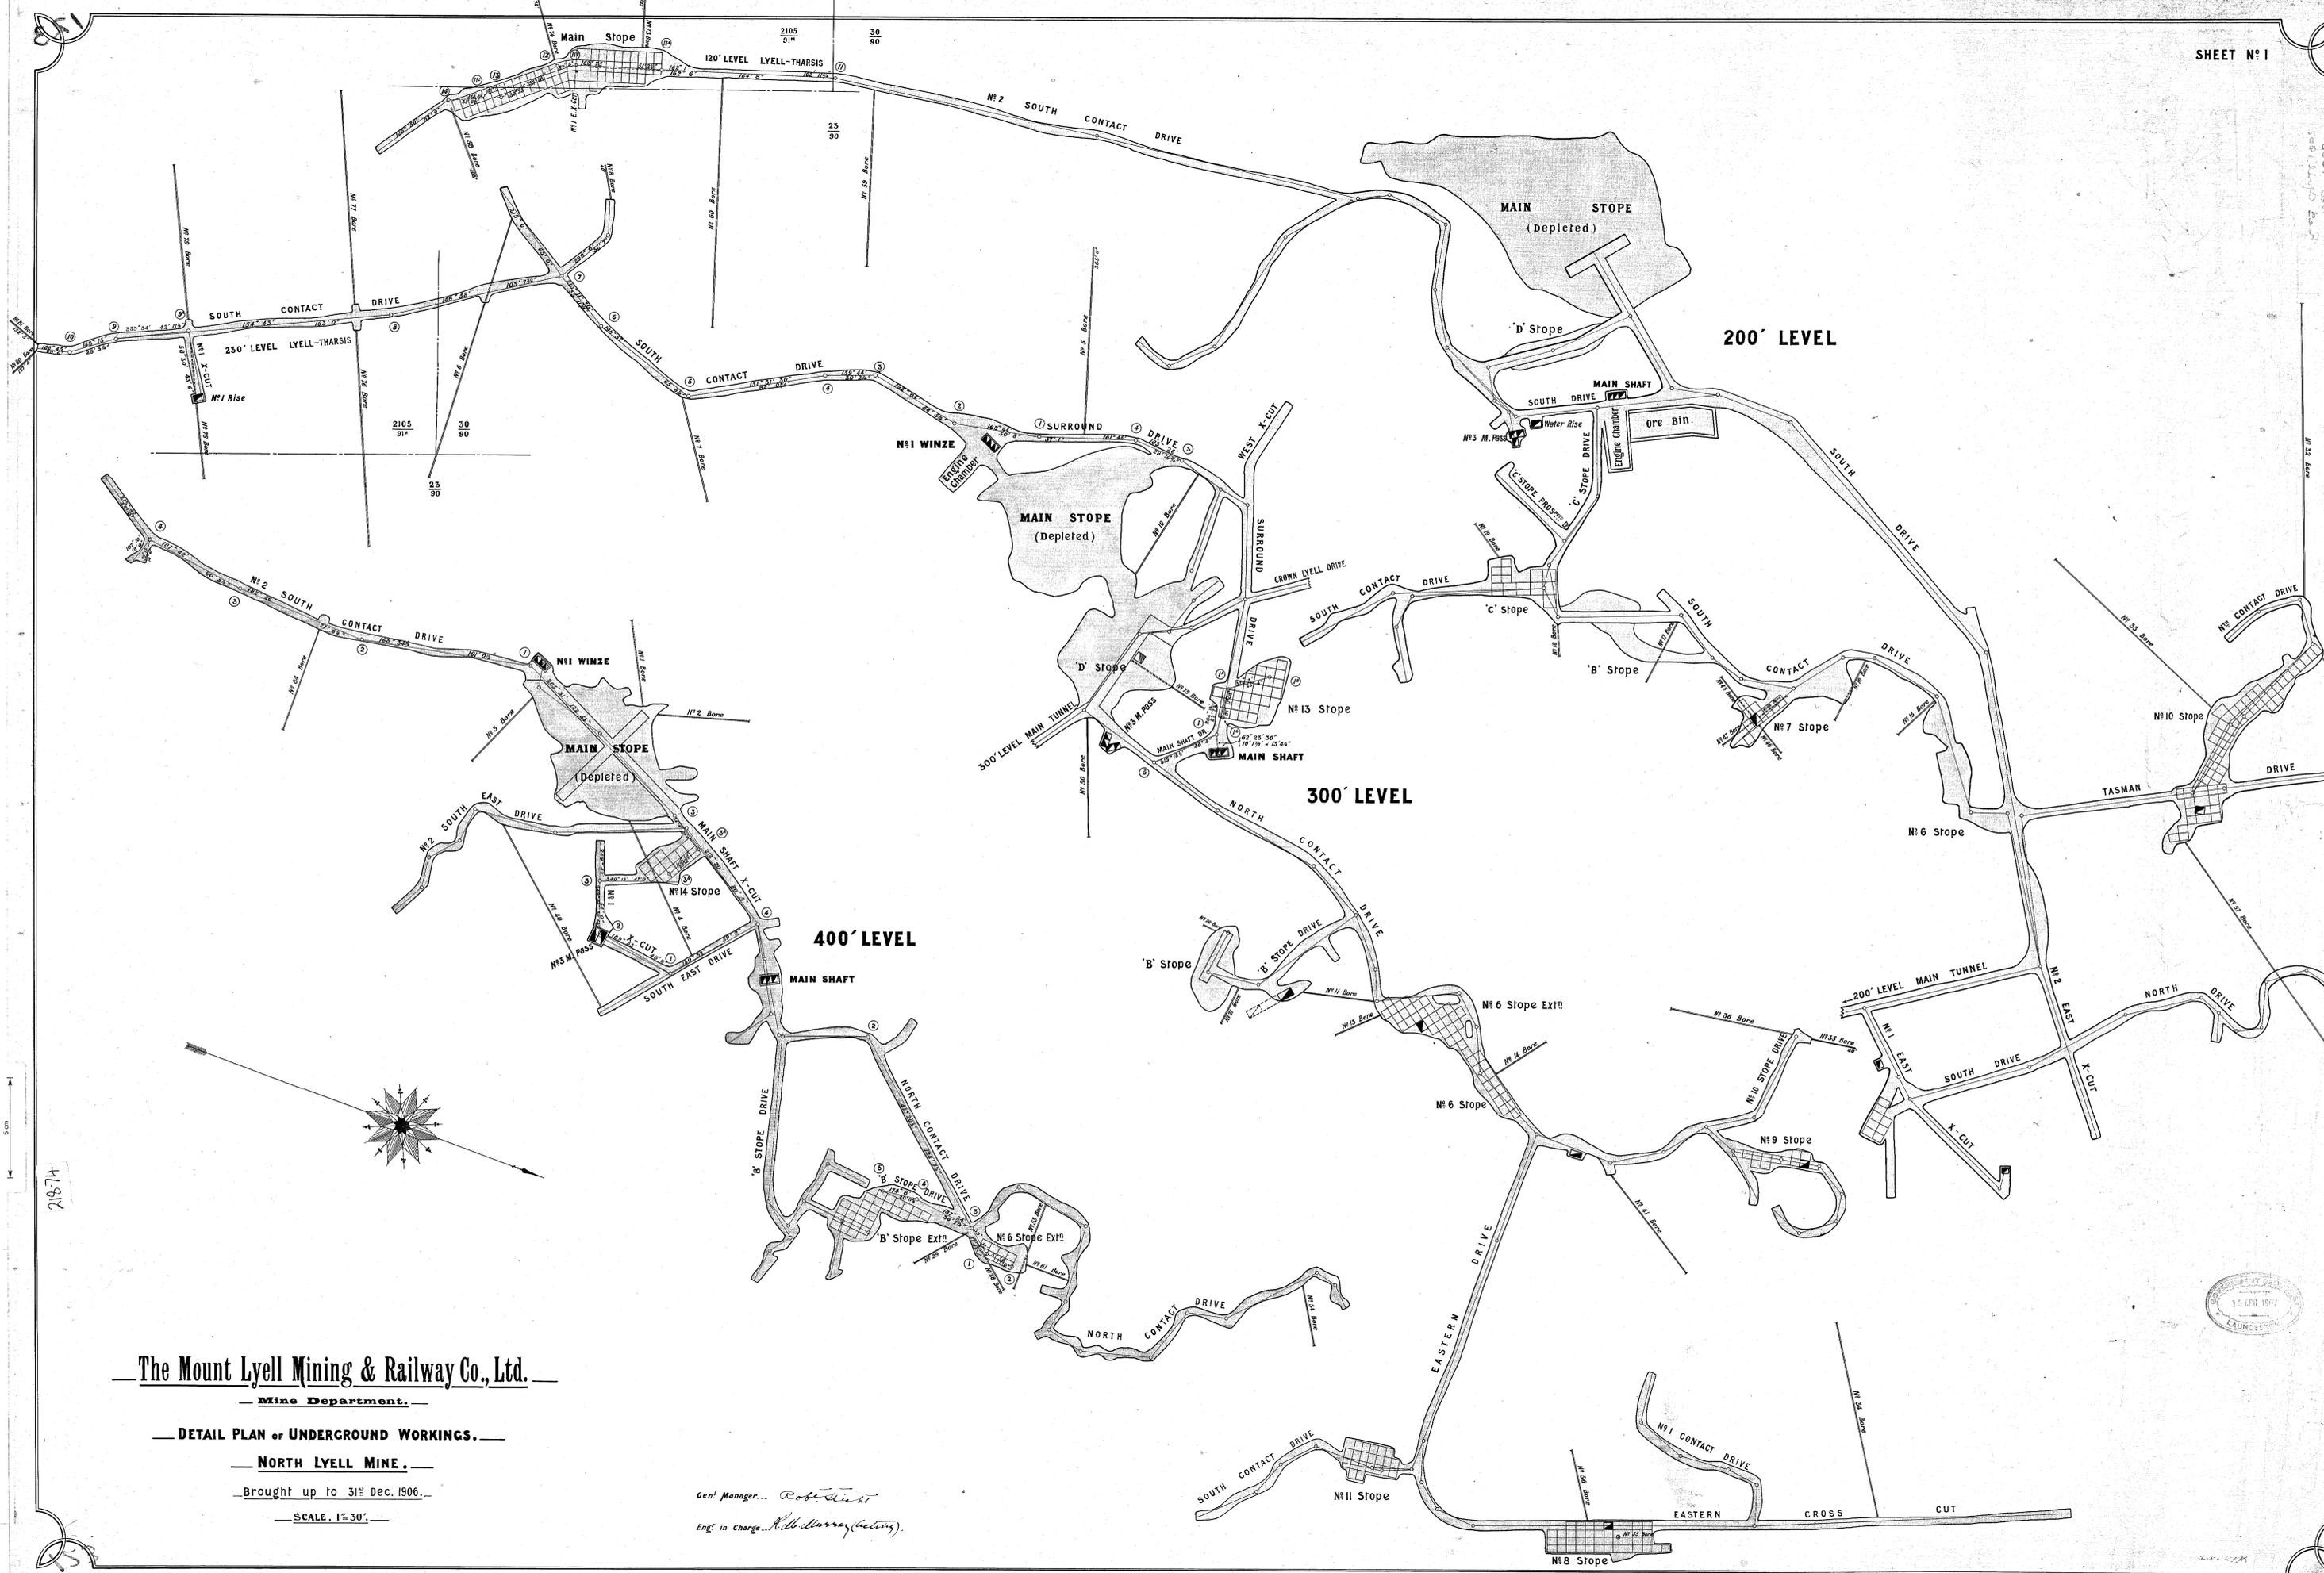

The Mount Lyell Mining & Railway Co., Ltd.

Mine Department.

DETAIL PLAN OF UNDERGROUND WORKINGS.

NORTH LYELL MINE.

Brought up to 31st Dec. 1906.

SCALE. 1"=30'

Genl. Manager... *Robert Smith*
Engl. in Charge... *W. H. Murray (acting)*

