

216-75


MOUNT LYELL CONSOLS

216-75

5m

REFERENCE		
Level.	Colour	Reduced Level at Main Shaft.
100Ft.	Omitted	1748
200Ft.	Light Blue	1669
300Ft.	Light Green	1554
400Ft.	Light Yellow	1456
500Ft.	Light Orange	1350
600Ft.	Light Red	1250
700Ft.	Light Purple	1150
850Ft.	Light Blue	1000

NOTE: Main Stope above the 200' Level omitted.

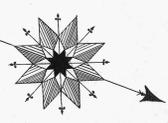

The Mount Lyell Mining & Railway Co., Ltd.

Mine Department.

COMPOSITE PLAN UNDERGROUND WORKINGS

NORTH LYELL MINE.

SCALE 1 INCH=30 FEET.

Brought up to 31st Dec. 1906.


Genl. Manager... *Robert Tennant*
Engt. in Charge... *Richard Murray (acting)*

10 1900

MOUNT LYELL BLOCKS MIN. CO.

9 1900

500 FT. LEVEL BLOCKS SHAFT WORKINGS

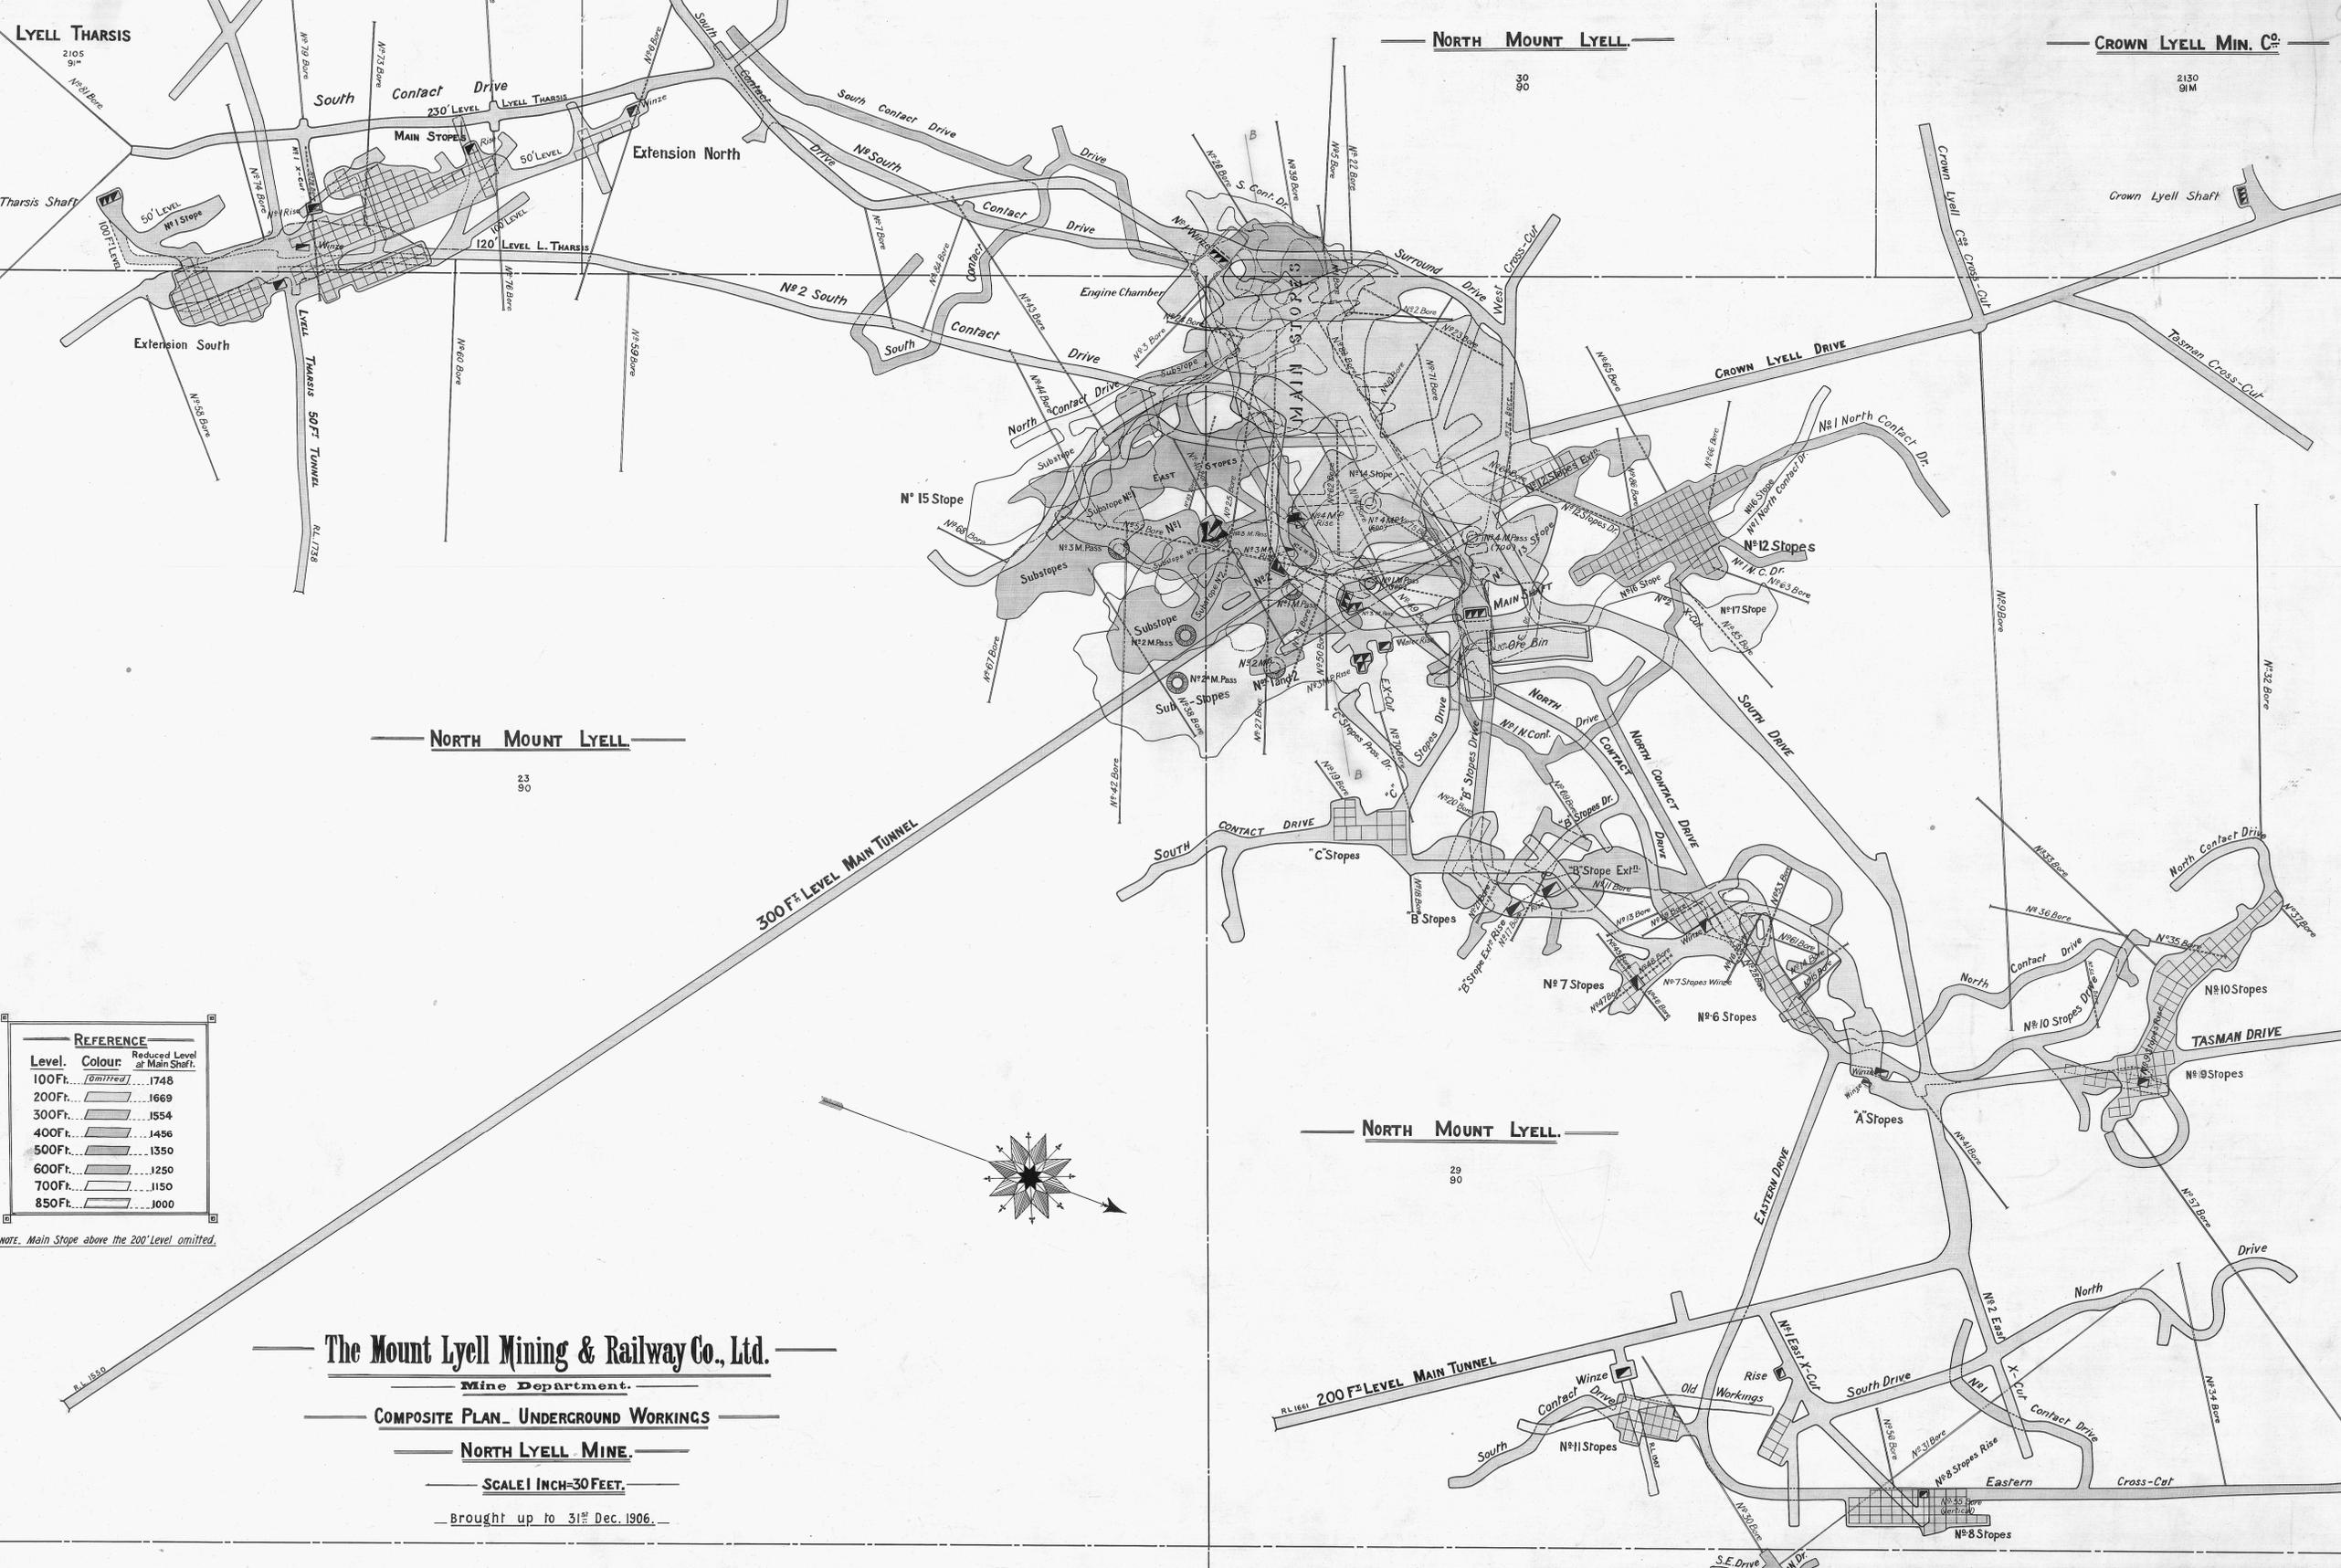

TASMAN LYELL PROS. ASSOC.

1839

91M