


5 cm

218-76

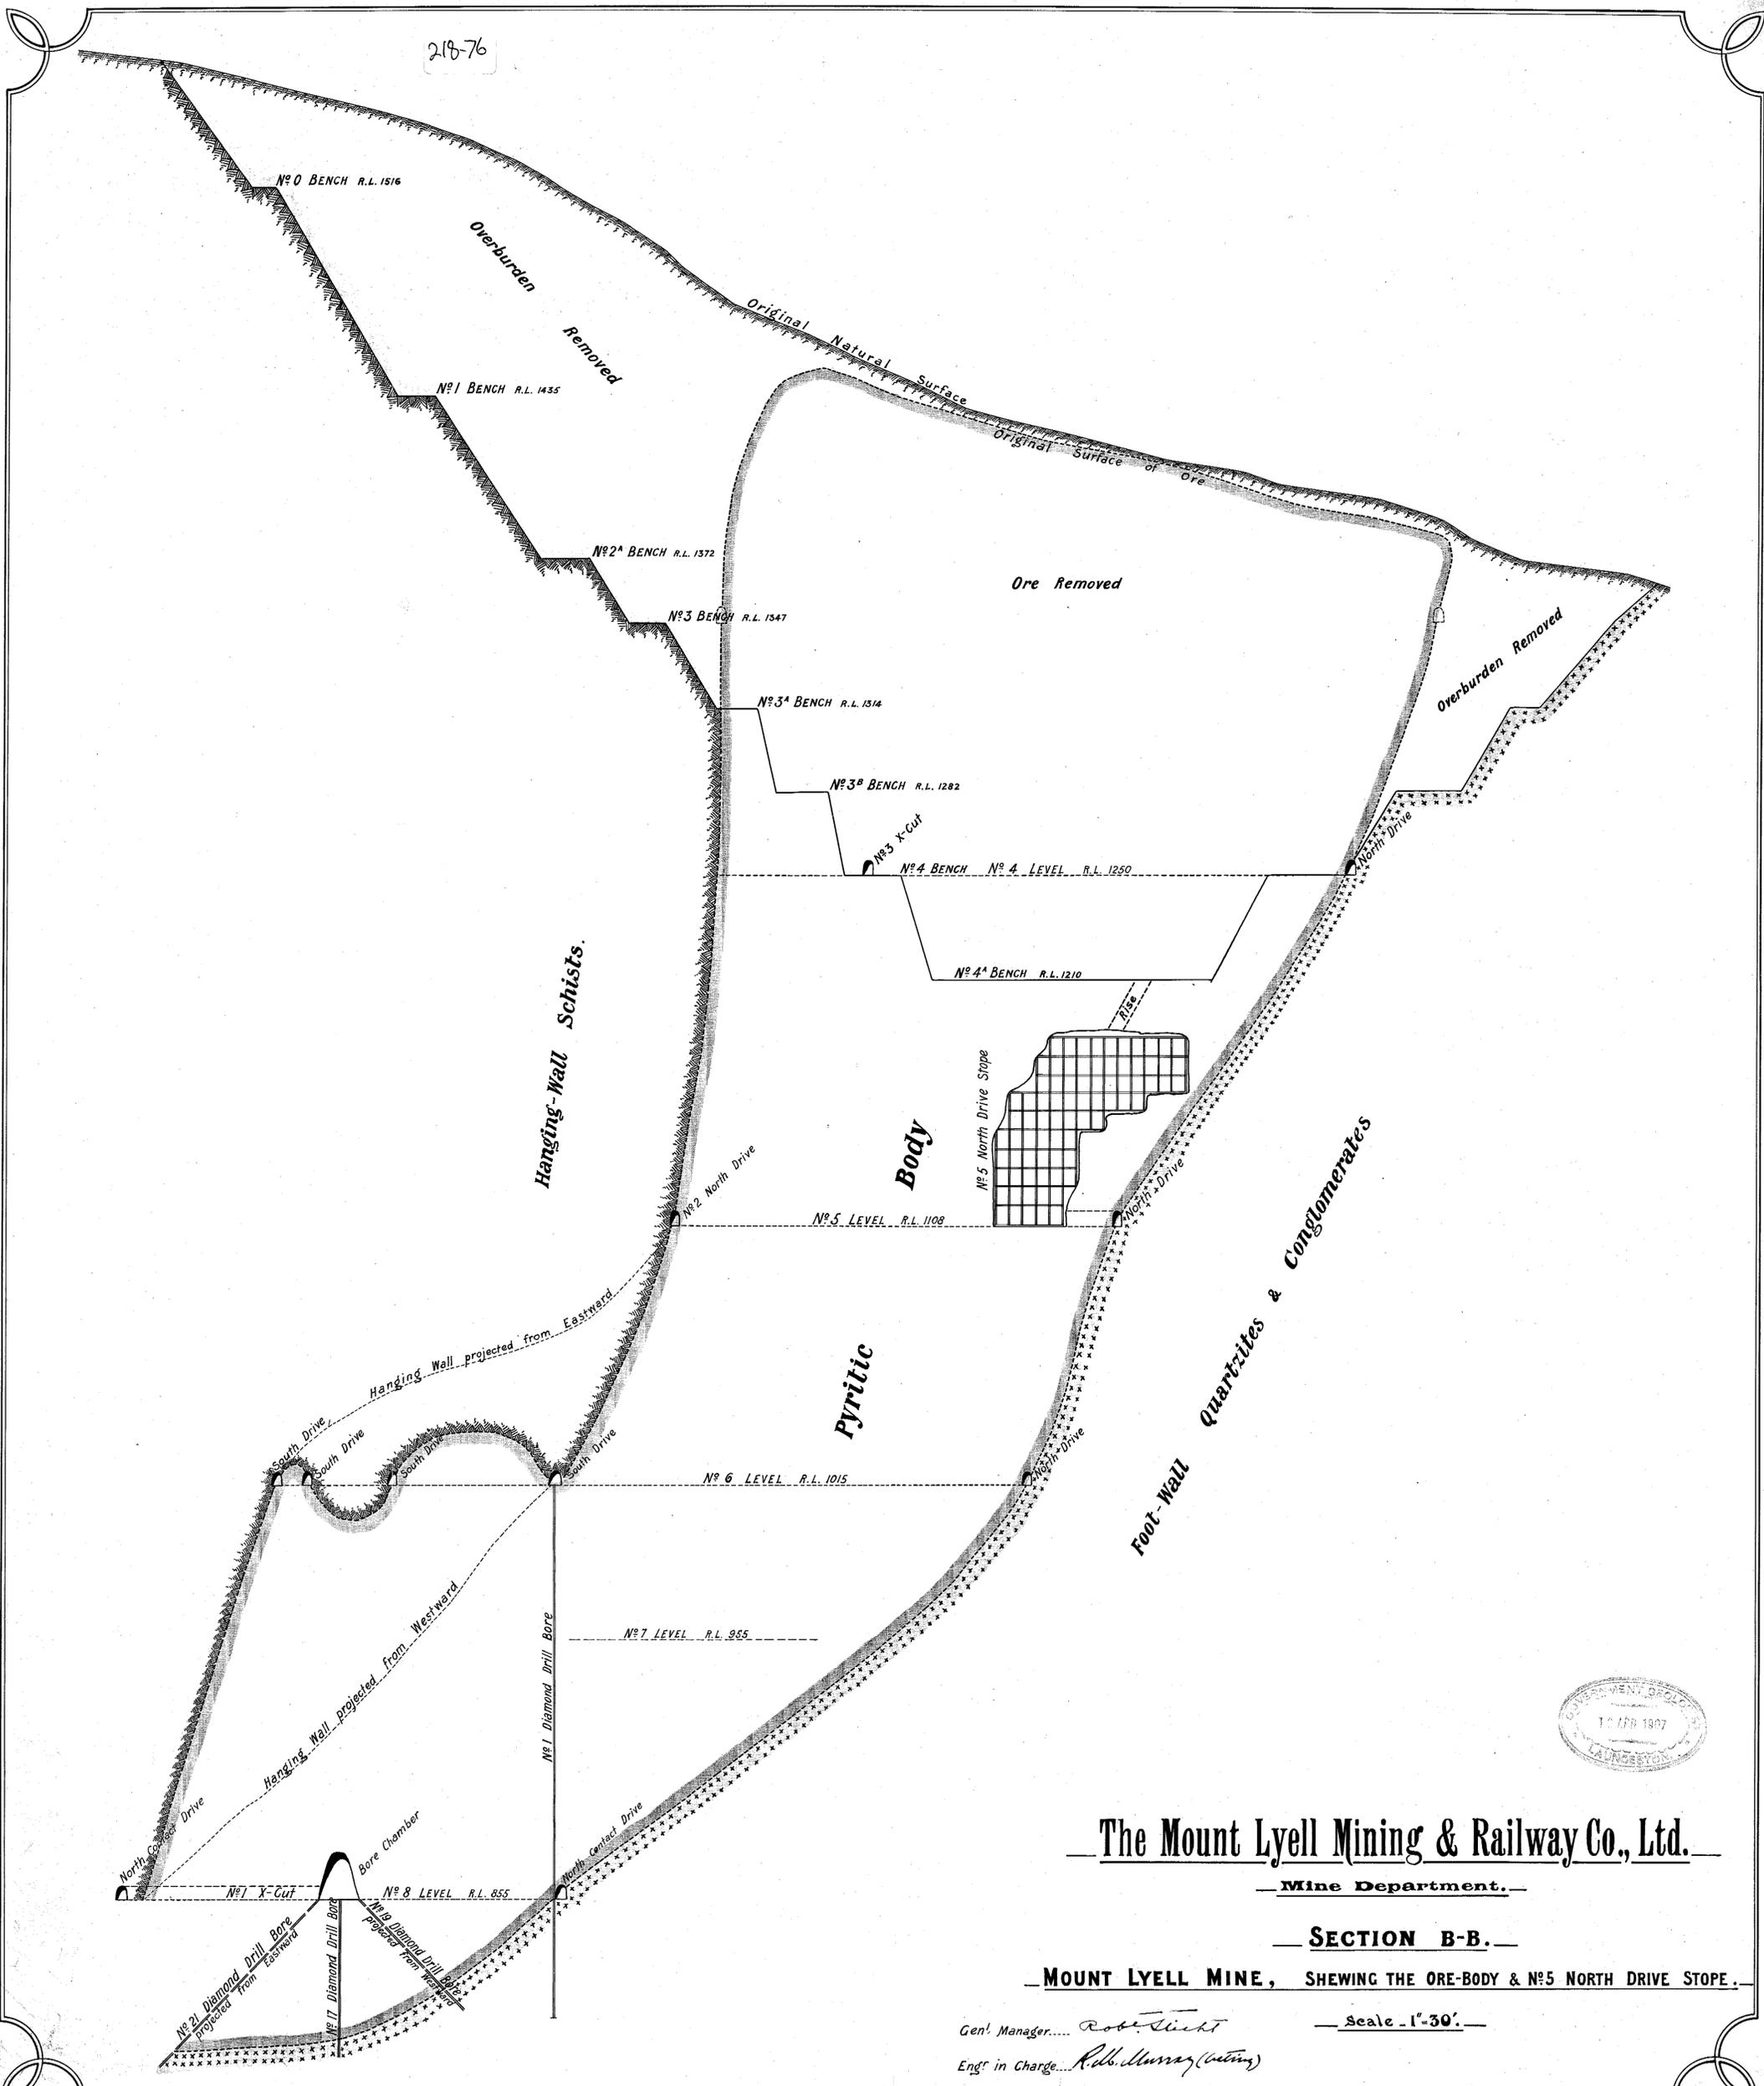

The Mount Lyell Mining & Railway Co., Ltd.

Mine Department.

SECTION B-B.

MOUNT LYELL MINE, SHEWING THE ORE-BODY & Nº 5 NORTH DRIVE STOPE.

Scale - 1"=30'.

Genl. Manager..... *Robt. Licht*

Eng^r in Charge..... *R. B. Murray (acting)*