

5 cm

218-77



The Mount Lyell Mining & Railway Co., Ltd.

Mine Department.

SOUTH THARSIS WORKINGS.

Brought up to 31st Dec. 1906.

Scale 1" = 30'.

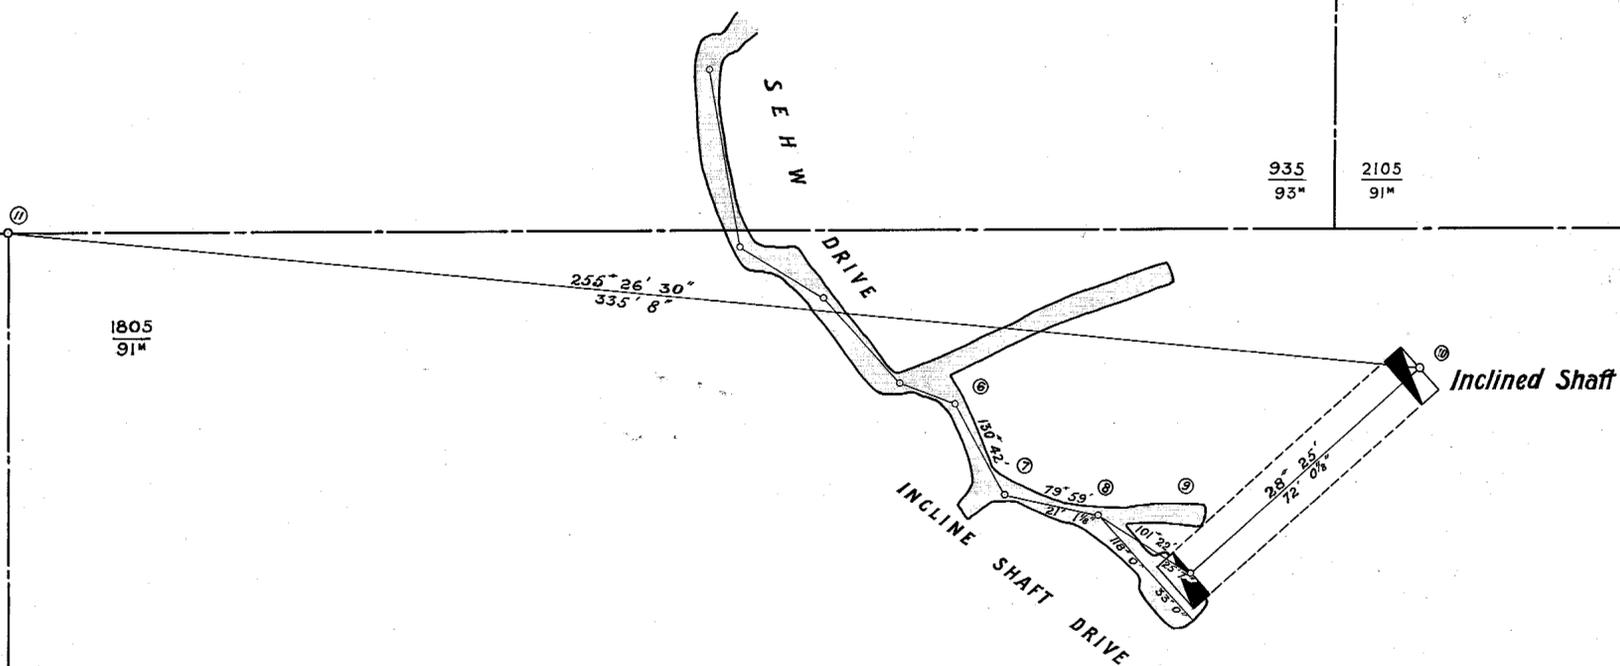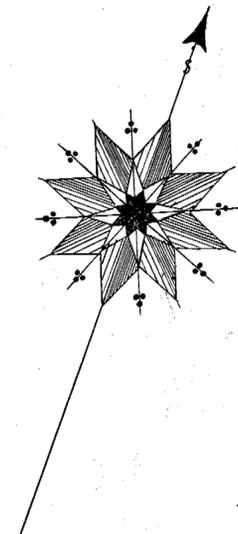

Genl. Manager... *Robt. Licht*

Eng^r in Charge... *R. H. Murray (acting)*