


218-80

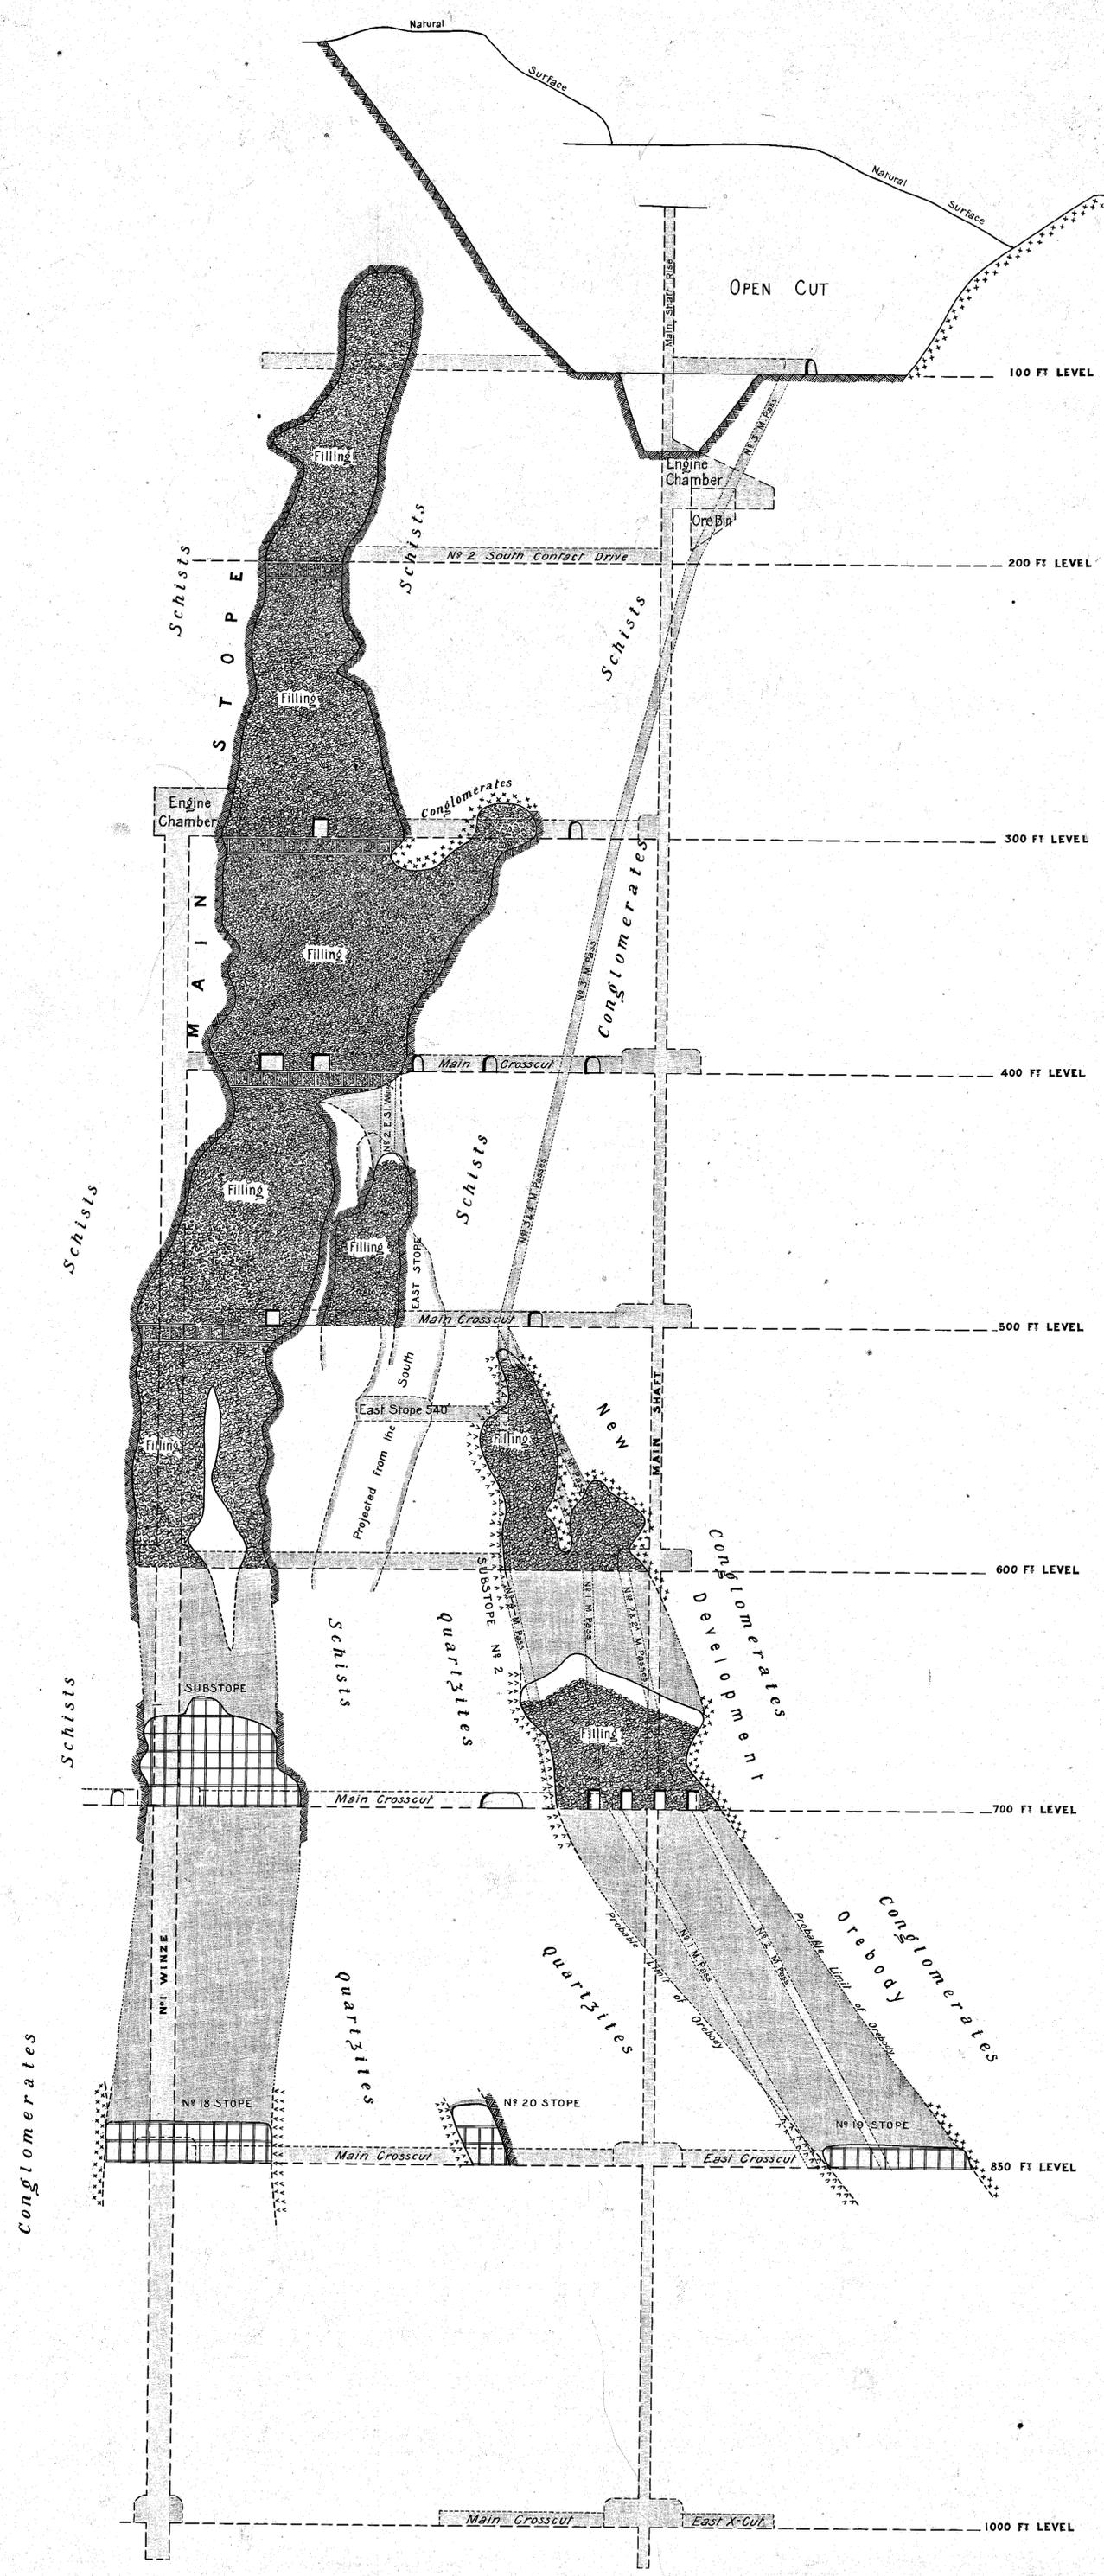

The Mount Lyell Mining & Railway Co., Ltd.

Mine Department.

NORTH LYELL MINE.

SECTION ON LINE B-B, LOOKING NORTH. — Dec. 31. 1907

SCALE, 1"=30'.

General Manager *Robert Smith*
Engineer-in-Charge *A. H. Murray*

W.S.K.

