


218-82

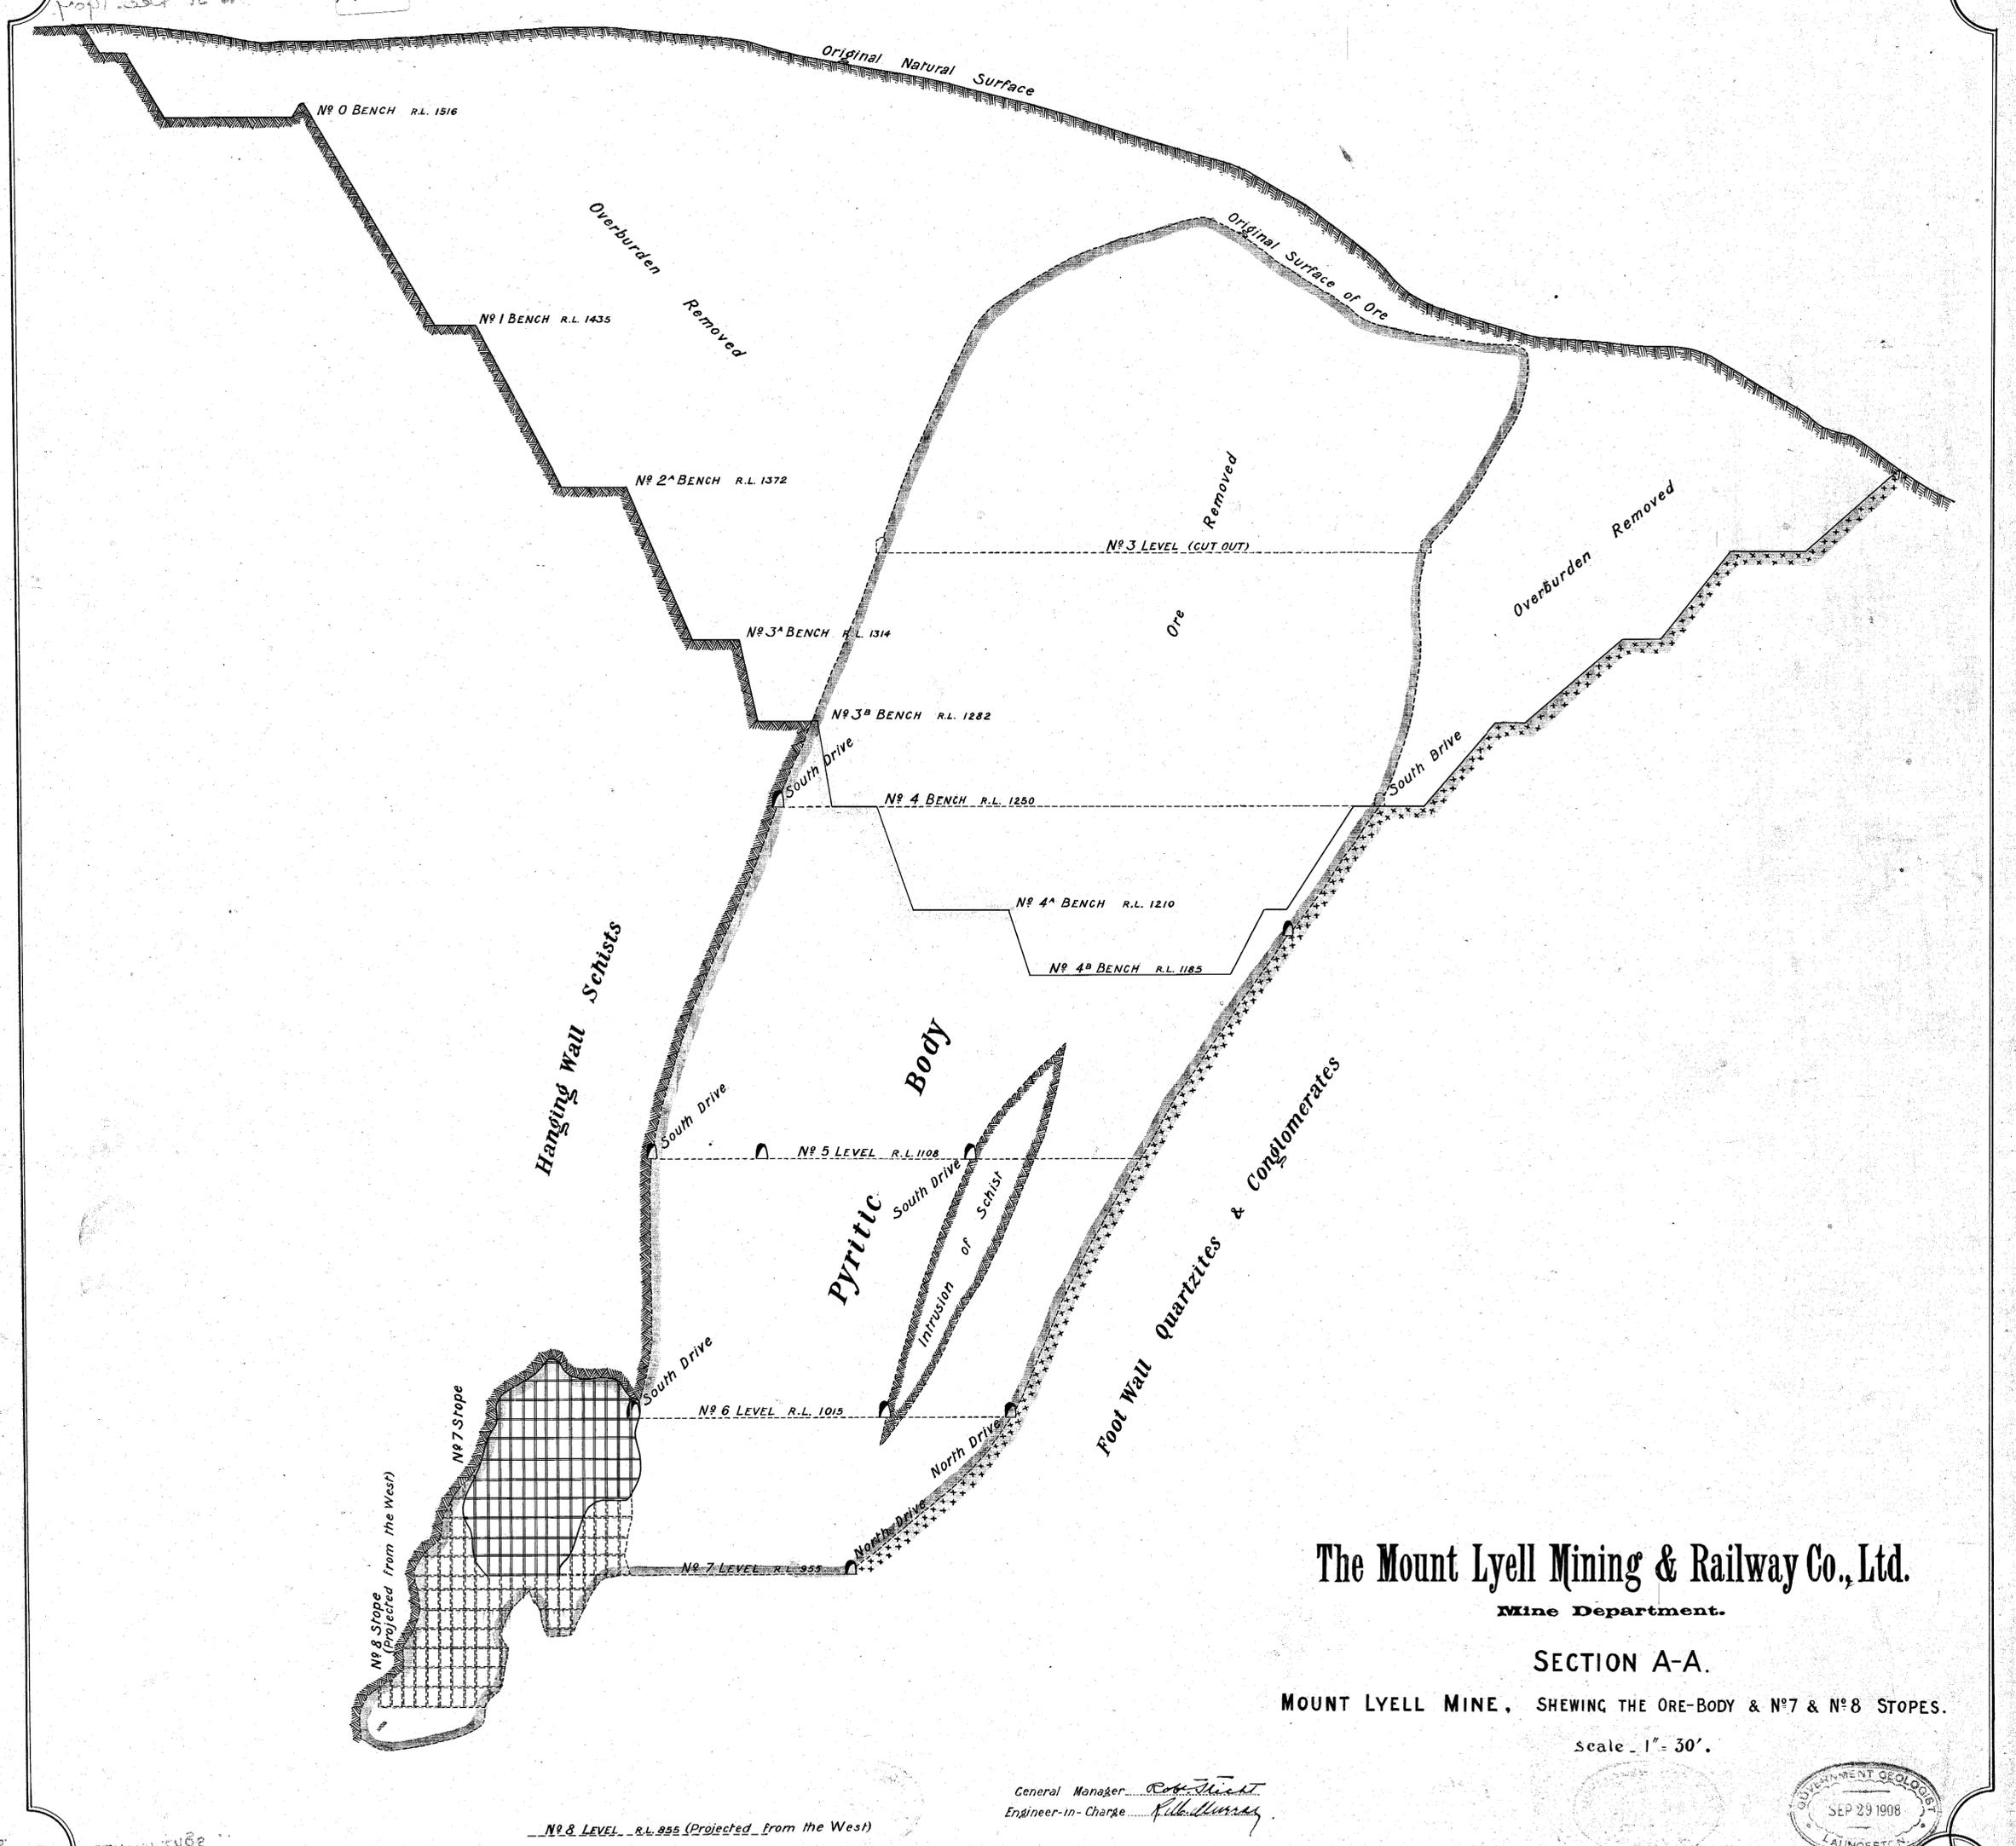

The Mount Lyell Mining & Railway Co., Ltd.

Mine Department.

SECTION A-A.

MOUNT LYELL MINE, SHEWING THE ORE-BODY & N°7 & N°8 STOPES.

scale 1" = 30'.

General Manager *Robt. Thickett*
Engineer-in-Charge *R. B. Murray*



Handwritten notes and signatures at the bottom left corner.