

218-83

218-83

No 0 BENCH R.L. 1516

No 0^a BENCH R.L. 1487 Overburden Removed

No 1 BENCH R.L. 1435

No 2 BENCH R.L. 1402

No 2^a BENCH R.L. 1372

No 3 BENCH R.L. 1347

No 3^a BENCH R.L. 1314

No 4 BENCH No 4 LEVEL R.L. 1250

No 4^a BENCH R.L. 1210


No 4^b BENCH R.L. 1185

No 5 LEVEL R.L. 1108

No 6 LEVEL R.L. 1015

No 7 LEVEL R.L. 955

No 8 LEVEL R.L. 855

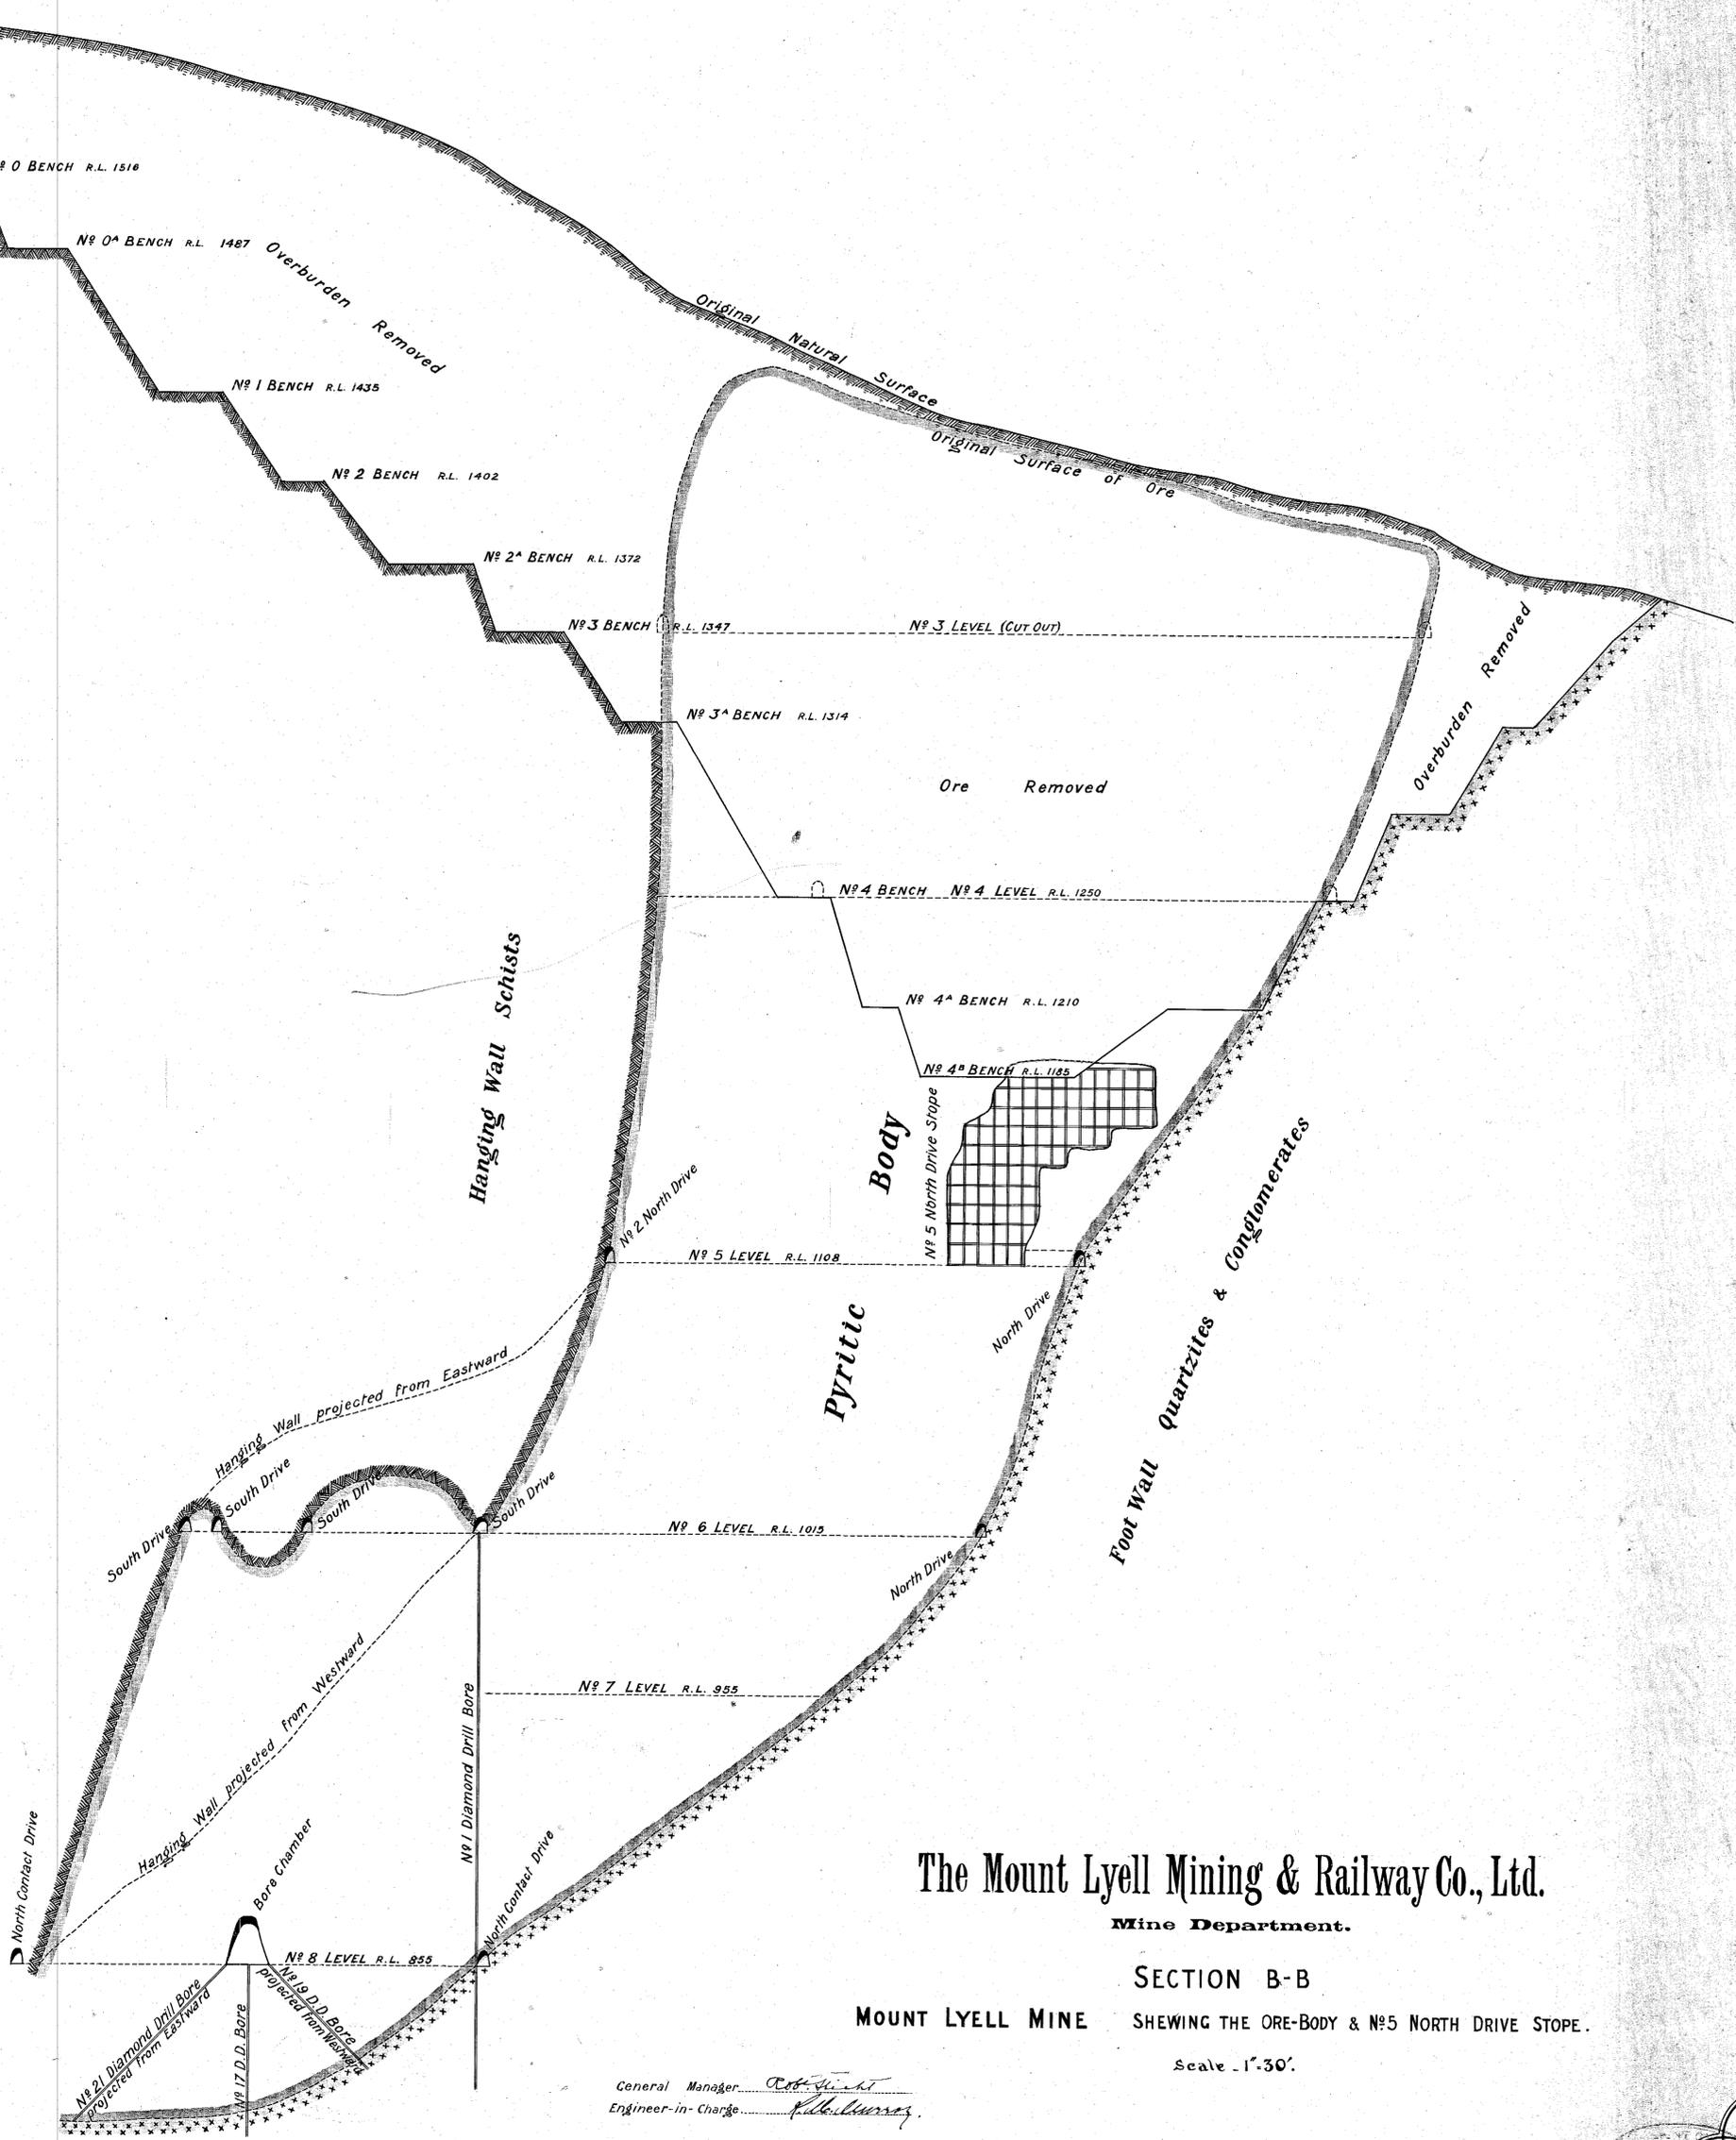

5 cm

218-83

The Mount Lyell Mining & Railway Co., Ltd.
 Mine Department.

SECTION B-B
 MOUNT LYELL MINE SHEWING THE ORE-BODY & No 5 NORTH DRIVE STOPE.

Scale - 1"=30'

General Manager *Robt. G. Smith*
 Engineer-in-Charge *W. H. Murray*



218-83
 1908
 153