
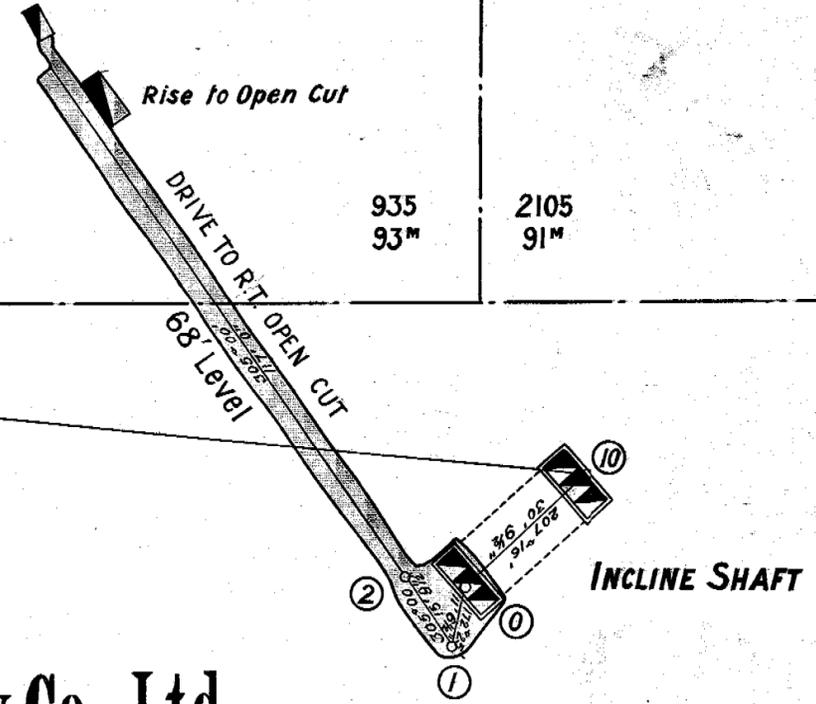


218-84

218-84

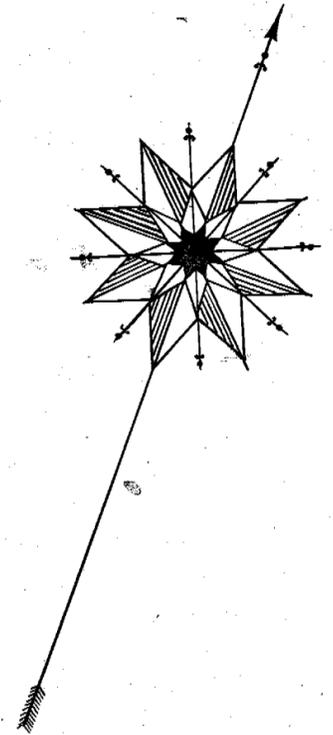

The Mount Lyell Mining & Railway Co., Ltd.

Mine Department.

SOUTH THARSIS WORKINGS.

Brought up to 31st Dec 1907.

Scale 1" = 30'.

General Manager... *Robt. Tennant*
Engineer-in-Charge... *W. Murray*

W.R.

